

73
96
BROAD ST
State of Conn.
June 11, 1910
Vol. 4-200-277

Scale 1"=100'

CAPITOL AVENUE



City of Hartford Bushnell Park

State Capital
State of Conn
City of Hfd.
1822


TRINITY STREET
Vol. 4-200-277



City of Hartford Bushnell Park

See sheet 9

ELM STREET
Apr. 21, 1902 Vol. 5-58

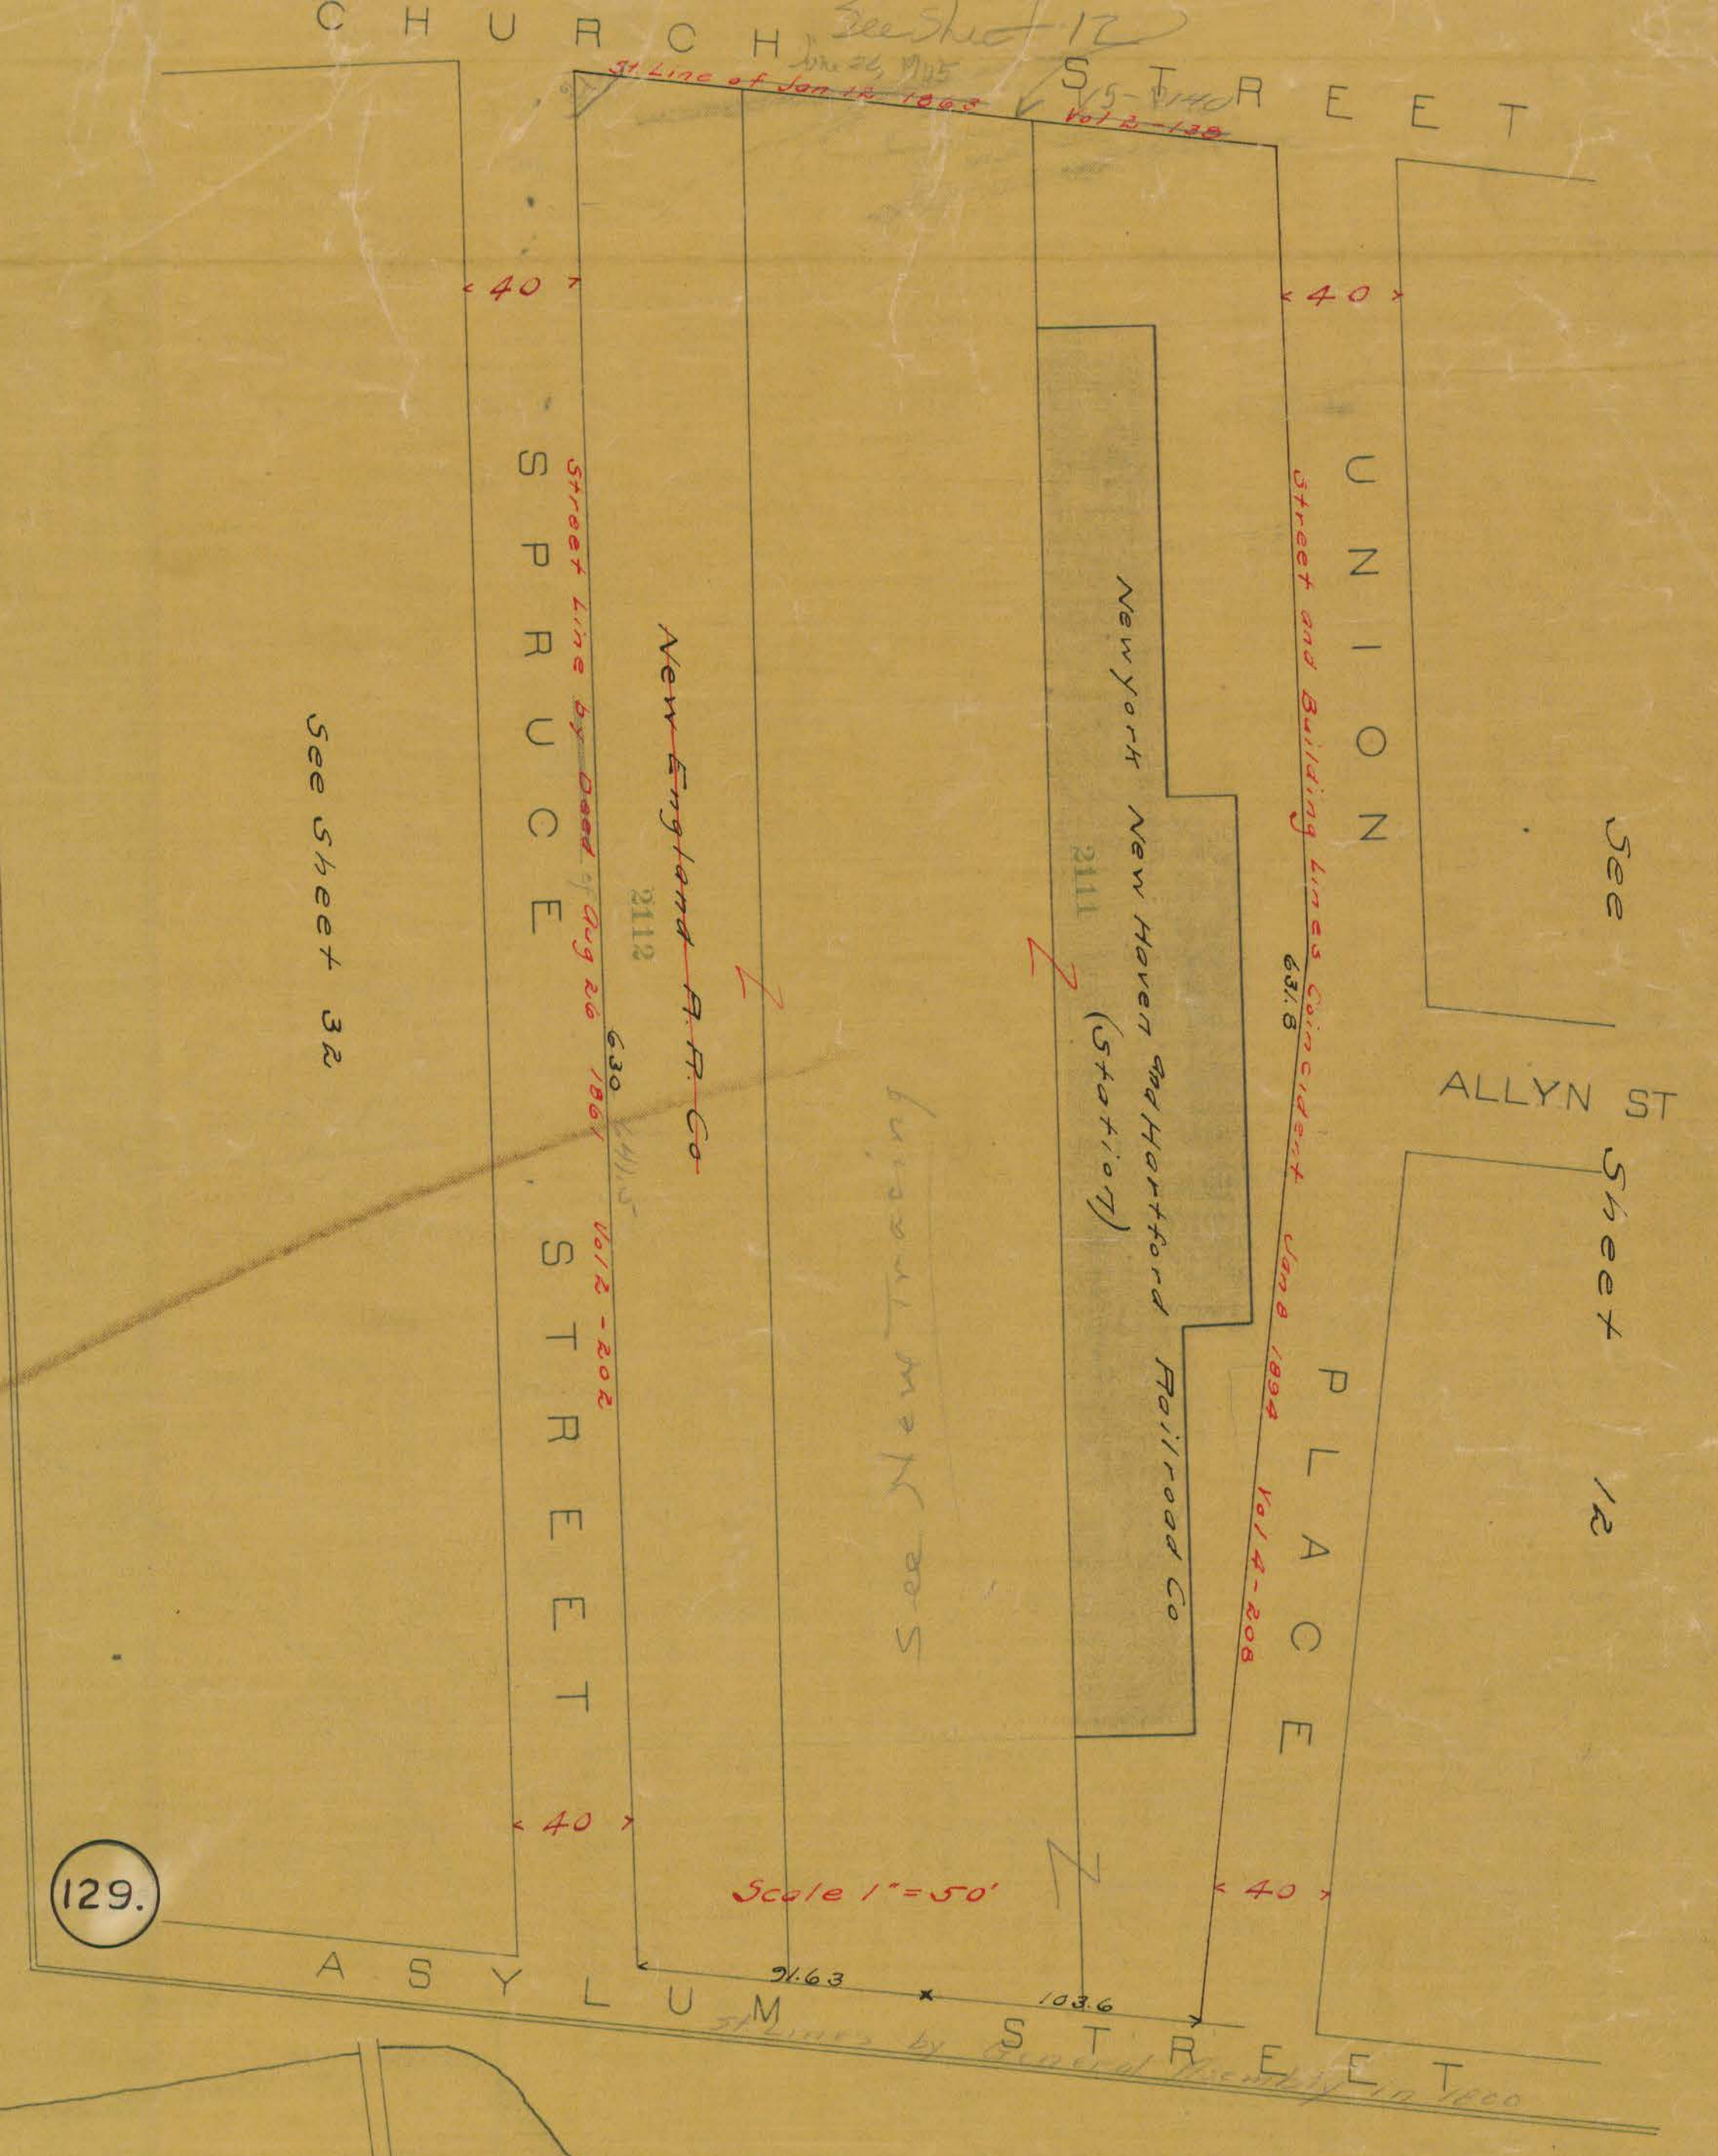

See sheet 32

New England A. R. Co.

New Haven and Hartford Railroad Co.

Union Place
See sheet 32

See sheet 12

Scale 1"=50'