


Sta. 1926.1 - North Curb Ward St.

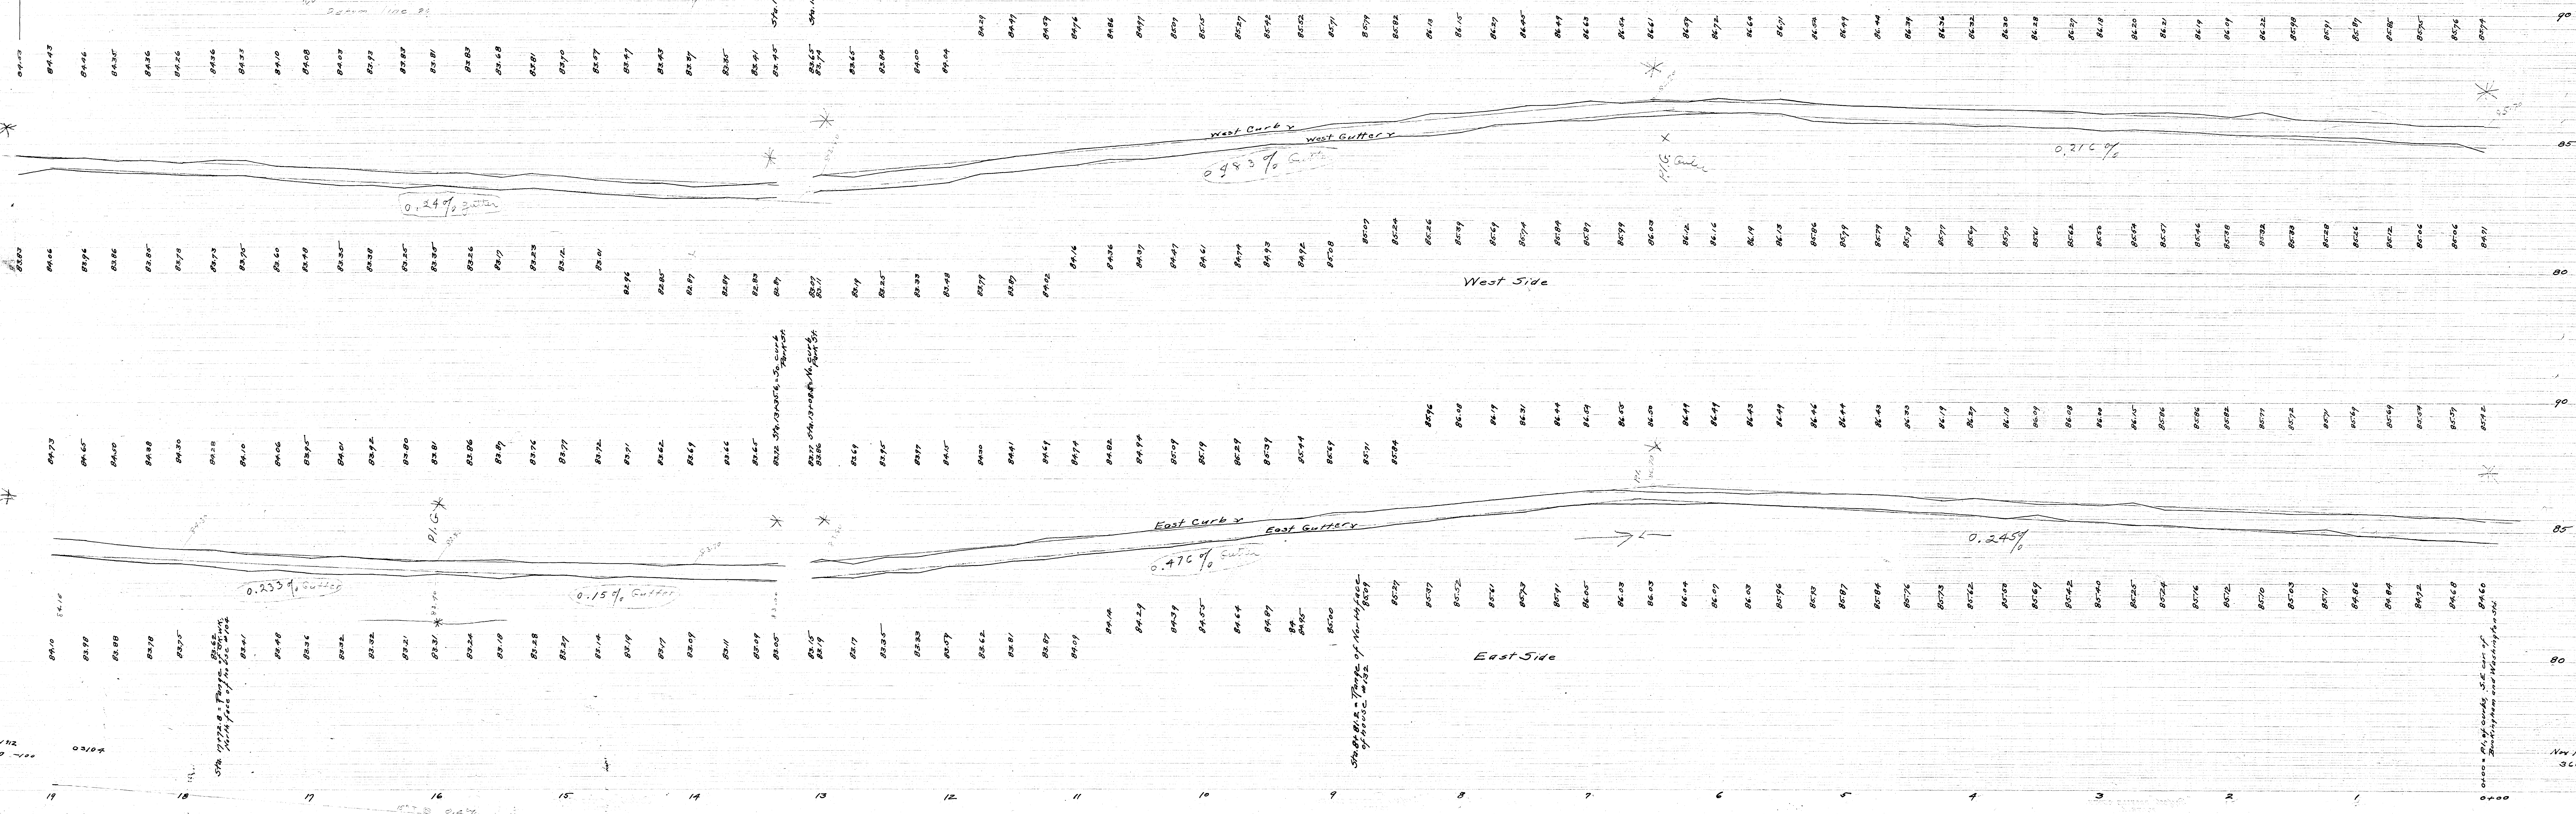

WASHINGTON ST.
PROFILE OF
EAST AND WEST CURBS AND GUTTERS
BUCKINGHAM ST. TO WARD ST.
SCALE 1" = 20'
STATIONS MEASURED IN EAST CURB.

Washington St. curb profile

Nov 1912
360-100

Nov 1912
360-100