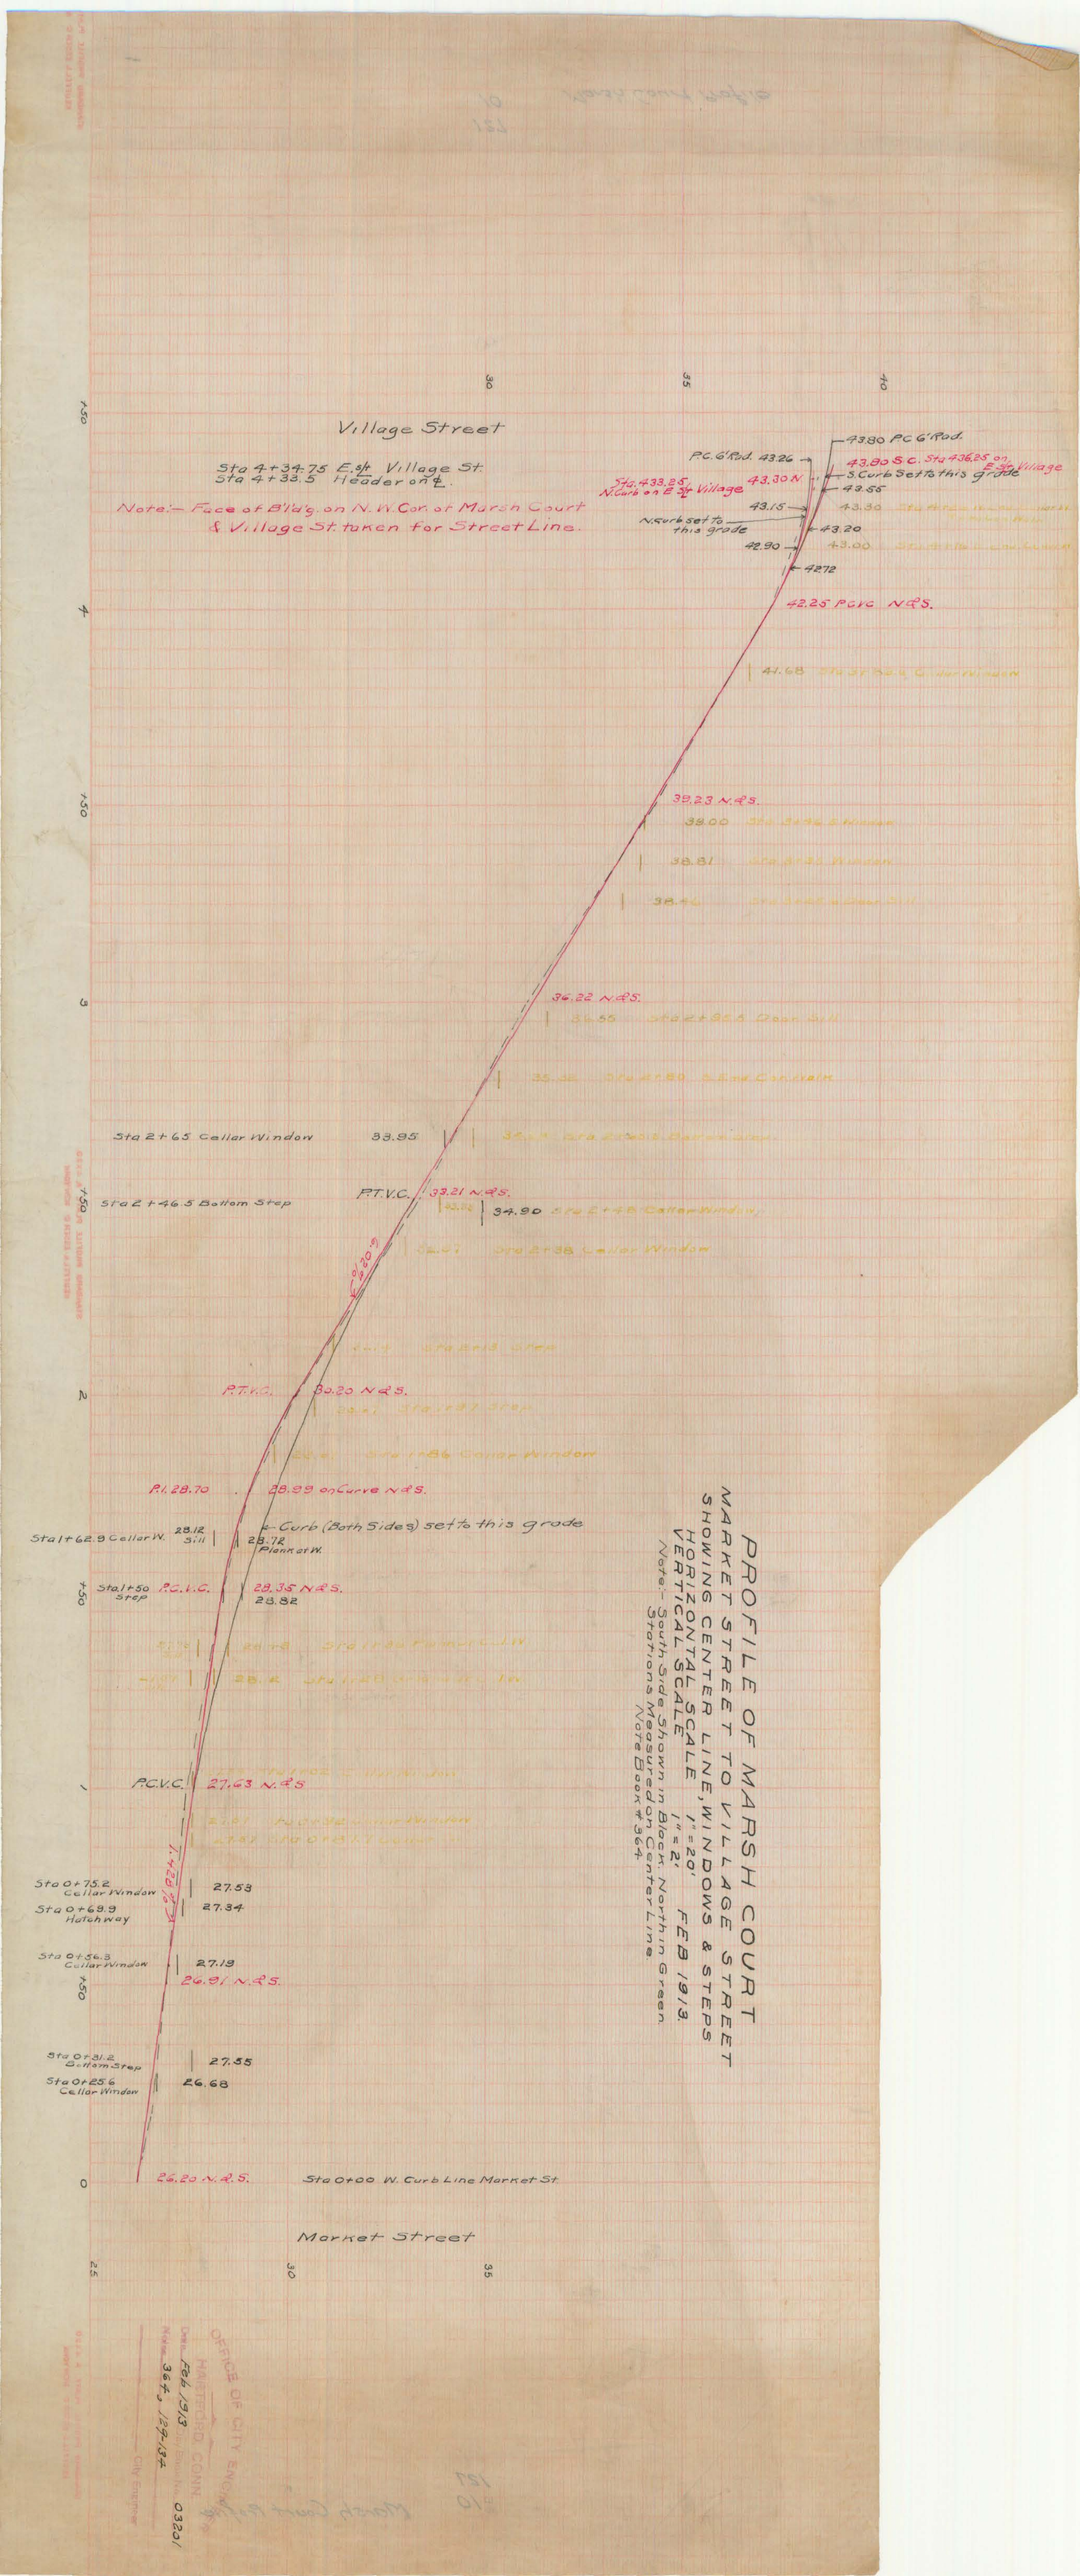
PROFILE OF MARSH COURT
MARKET STREET TO VILLAGE STREET
SHOWING CENTER LINE, WINDOWS & STEPS
HORIZONTAL SCALE 1" = 20'
VERTICAL SCALE 1" = 2'
FEB 1913.
Note:- South Side Shown in Black, North in Green.
Stations Measured on Center Line
Note Book #364
Village Street
Sta 4+34.75 E. of Village St.
Sta 4+33.5 Header on ℄.
Note:- Face of Bldg. on N.W. Cor. of Marsh Court & Village St. taken for Street Line.
43.80 P.C. 6' Rad.
43.80 S.C. Sta 436.25 on E. Side Village
S. Curb Set to this grade
43.55
43.30
43.20
43.00
42.90
42.72
42.25 P.C.I.C. N. & S.
41.68
39.23 N. & S.
38.00
38.81
36.22 N. & S.
34.55
33.95
Sta 2+65 Cellar Window
Sta 2+46.5 Bottom Step
P.T.V.C.
33.21 N. & S.
34.90
Sta 2+38 Cellar Window
E 220.5
P.T.V.C.
30.20 N. & S.
P.I. 28.70
28.29 on Curve N. & S.
Curb (Both Sides) set to this grade
Sta 1+62.9 Cellar W.
28.12 Sill
28.12 Plank at W.
Sta 1+50 Step
P.C.I.C.
28.35 N. & S.
28.82
P.C.V.C.
27.63 N. & S.
E 82.4
Sta 0+75.2 Cellar Window
27.53
Sta 0+68.9 Hatchway
27.34
Sta 0+56.8 Cellar Window
27.19
26.91 N. & S.
Sta 0+31.2 Bottom Step
27.55
Sta 0+25.6 Cellar Window
26.68
26.23 N. & S.
Sta 0+00 W. Curb Line Market St.
Market Street
OFFICE OF CITY ENGINEER
HARTFORD, CONN.
Drawn by
Traced by
Checked by
Approved
Feb 1913
Scale
Map No. 3845
Sheet No. 124-134
0320