


SHOULD PAINT TO TOP OF CURB

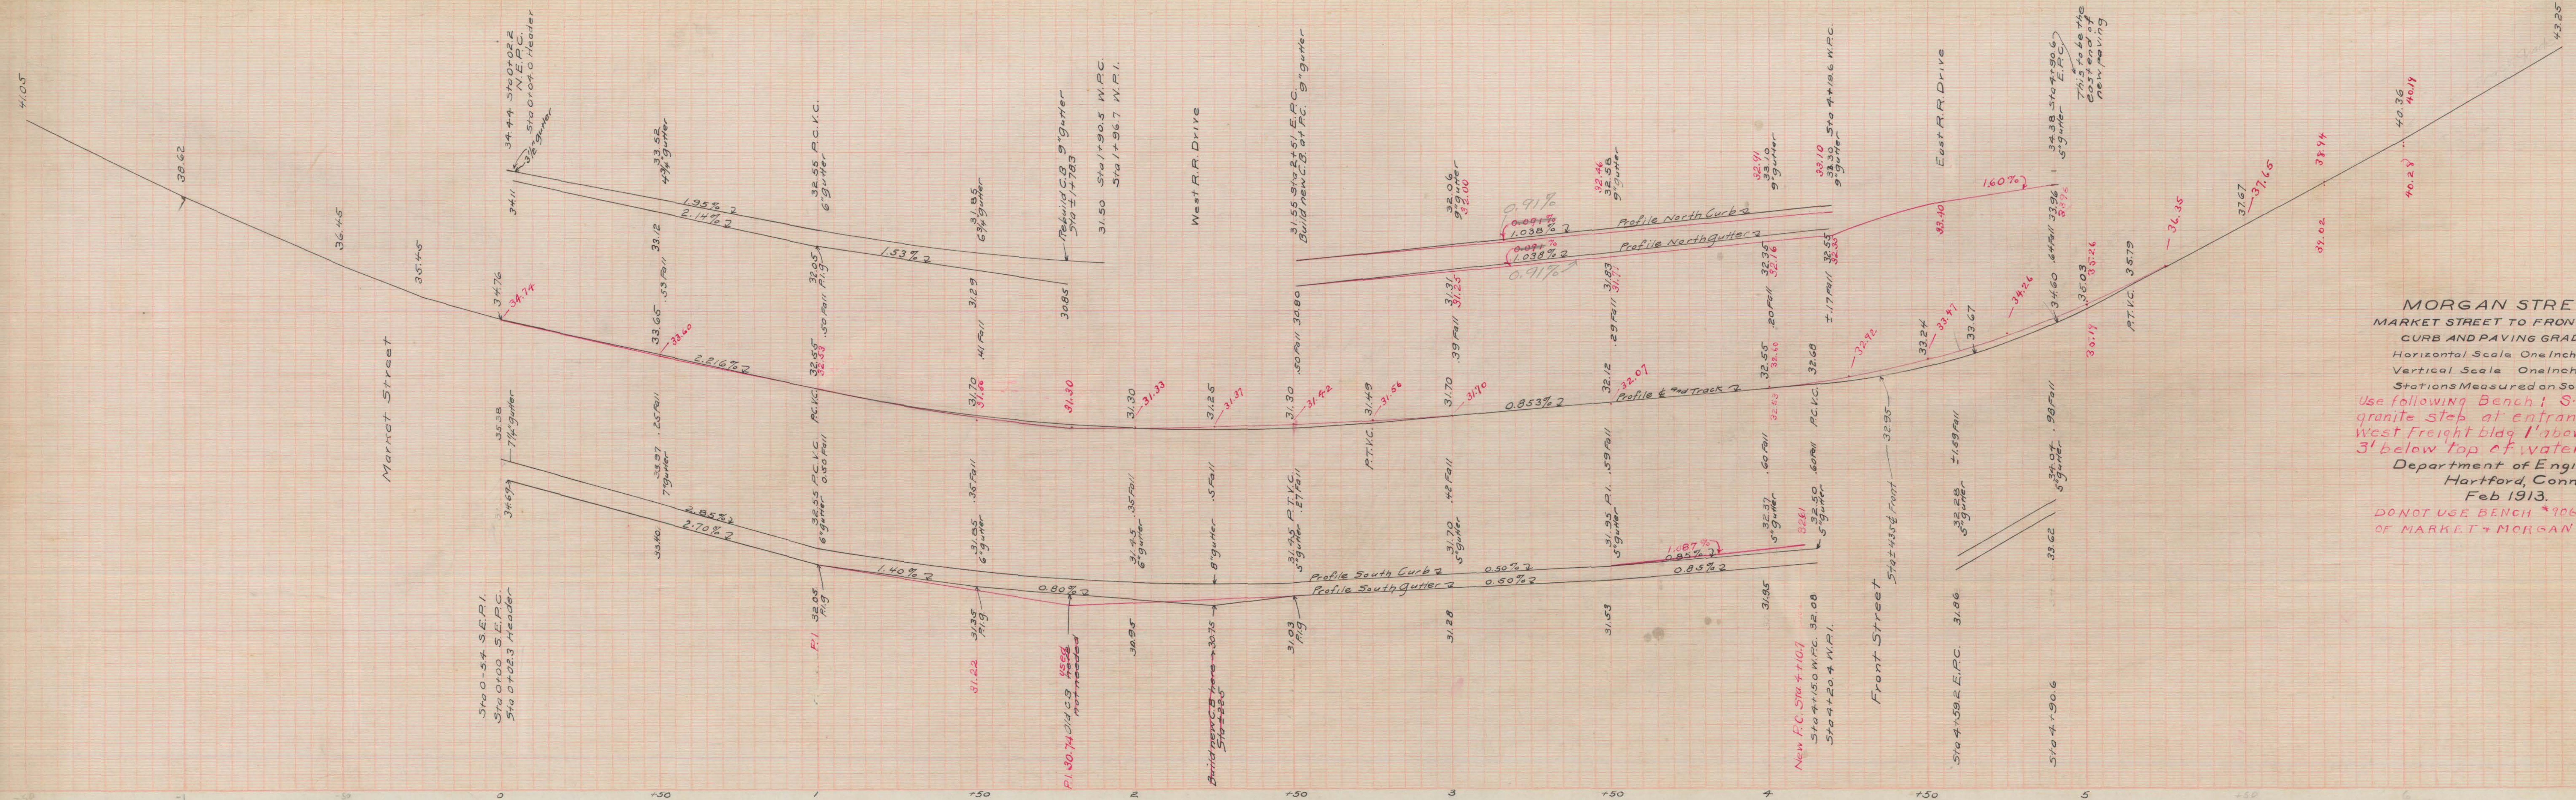

MORGAN STREET
MARKET STREET TO FRONT STREET
CURB AND PAVING GRADES
Horizontal Scale One Inch = 20'
Vertical Scale One Inch = 2'
Stations Measured on South Curb
Use following Bench: S.E. cor.
granite step at entrance to
West Freight bldg 1' above ground,
3' below top of water table.
Department of Engineering
Hartford, Conn.
Feb 1913.
DO NOT USE BENCH #906 AT CORNER
OF MARKET + MORGAN STS.

E.I. 32.62

OFFICE OF CITY ENGINEER
HARTFORD, CONN.
Feb 1913
367, 78-80, 84-83