
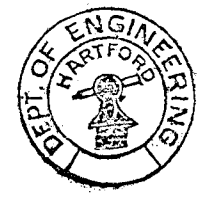


Catherine St.
Scale H 1" = 20'
V. 1" = 2'

N 1/4 Ft. 0
5 " " +

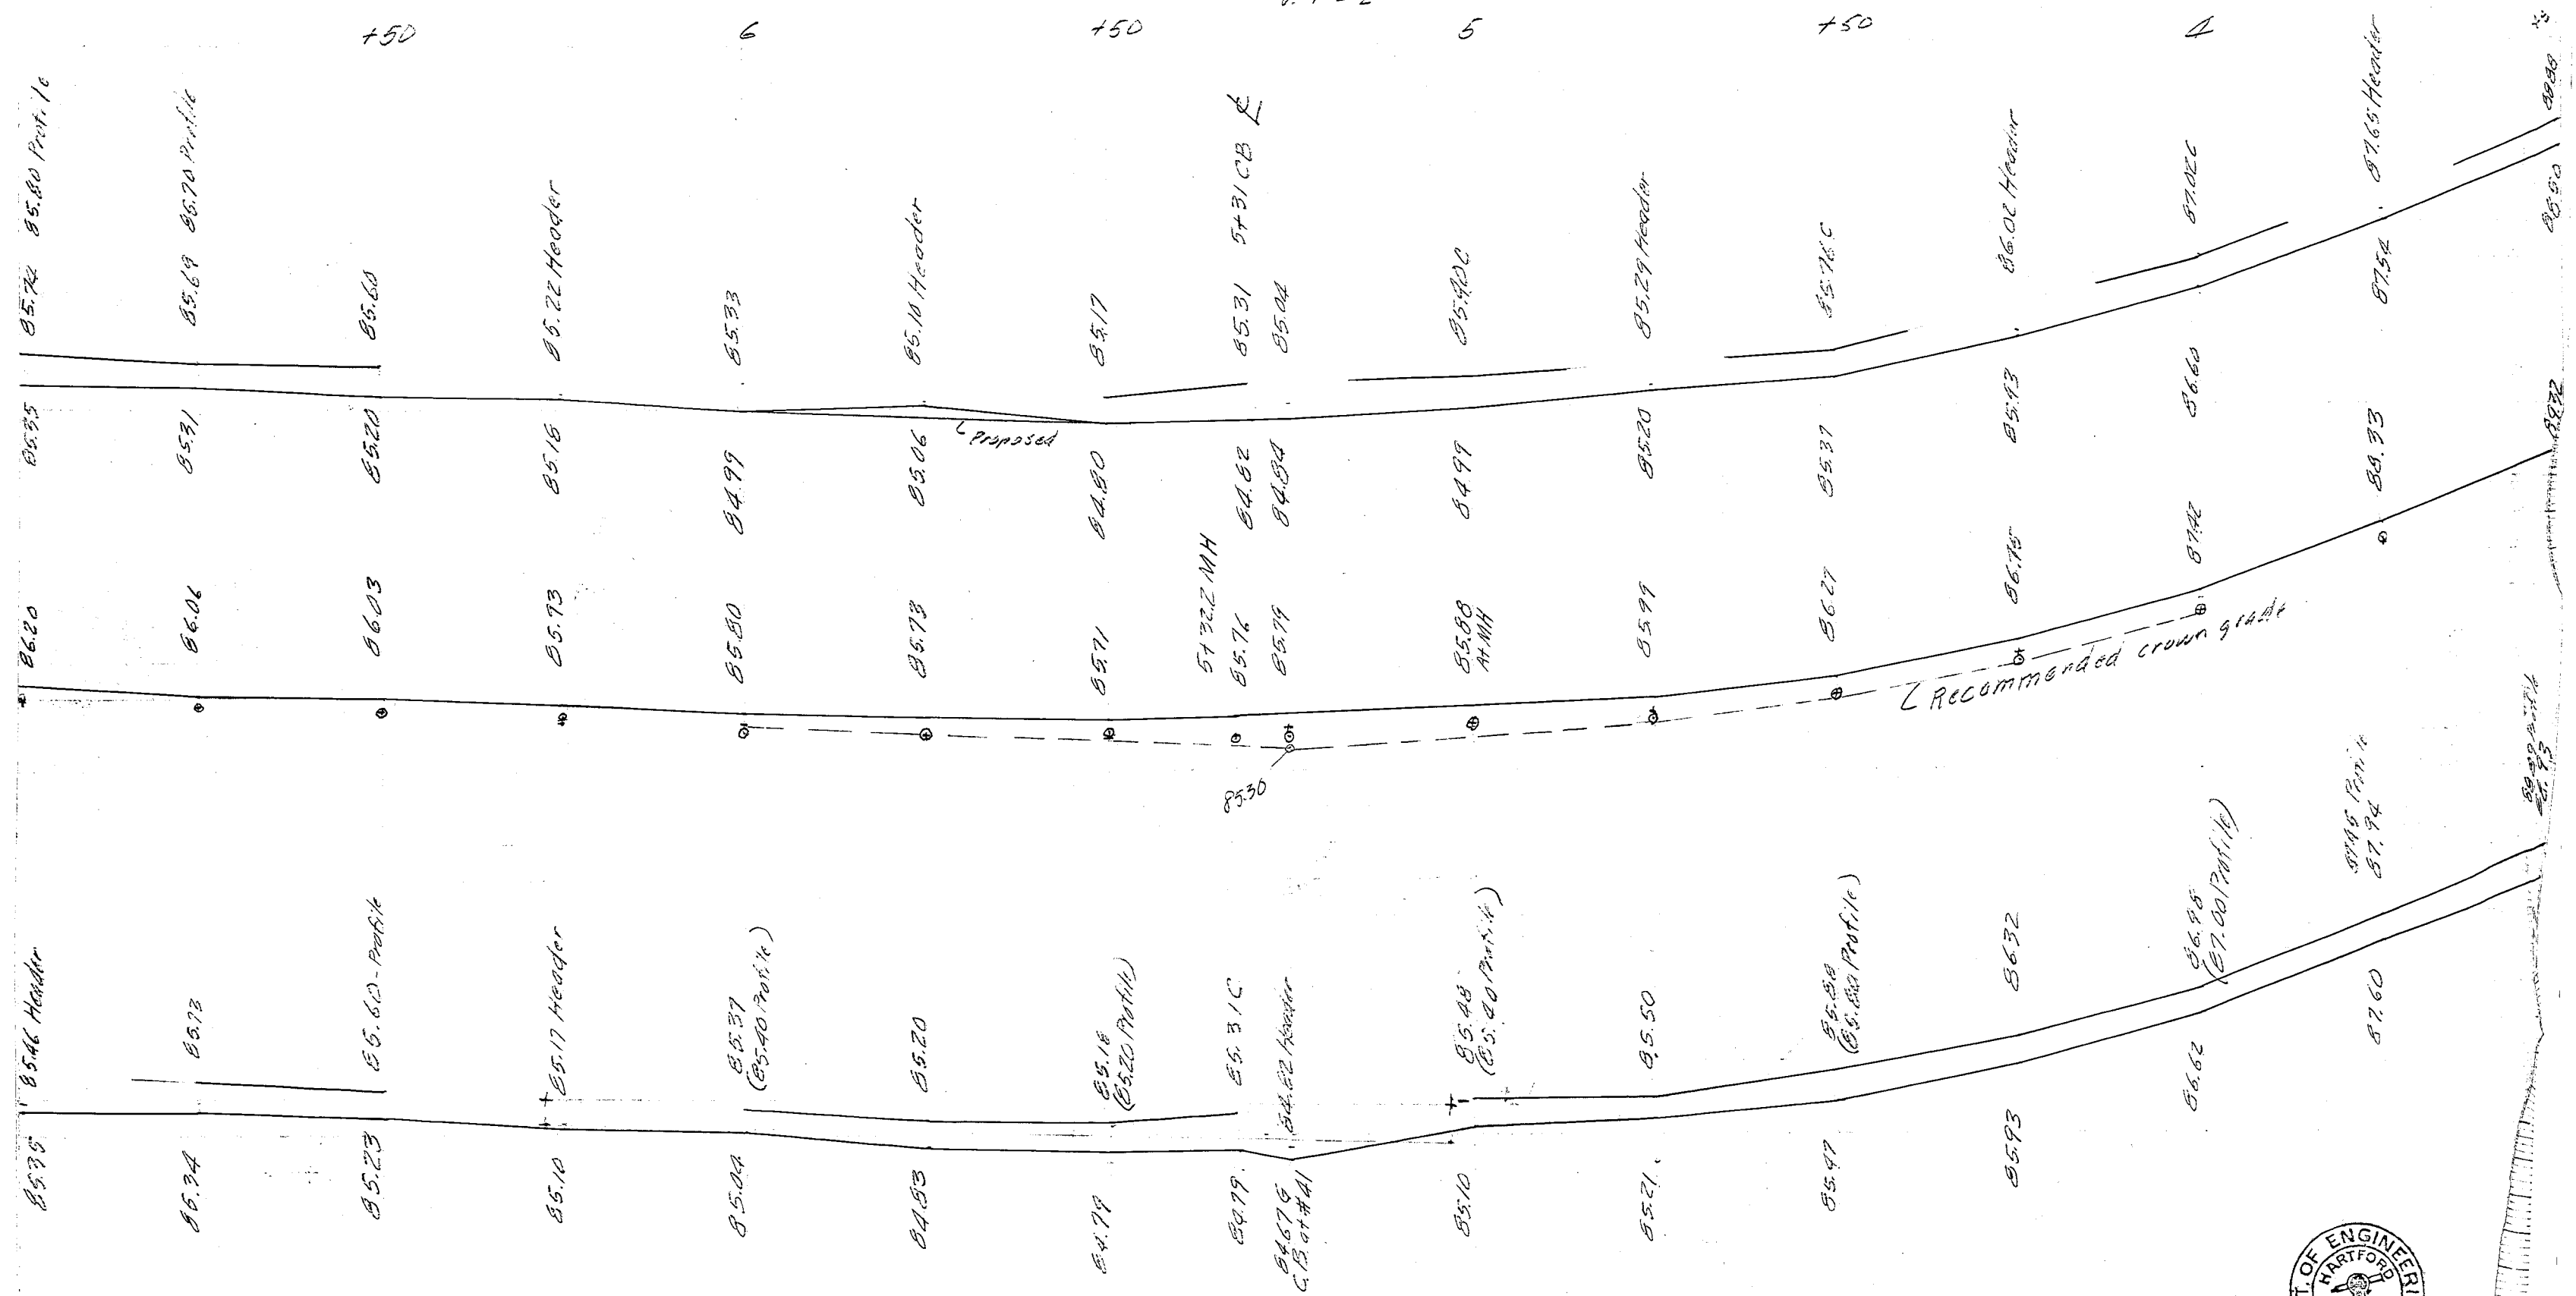

Levels of March 8 '61