


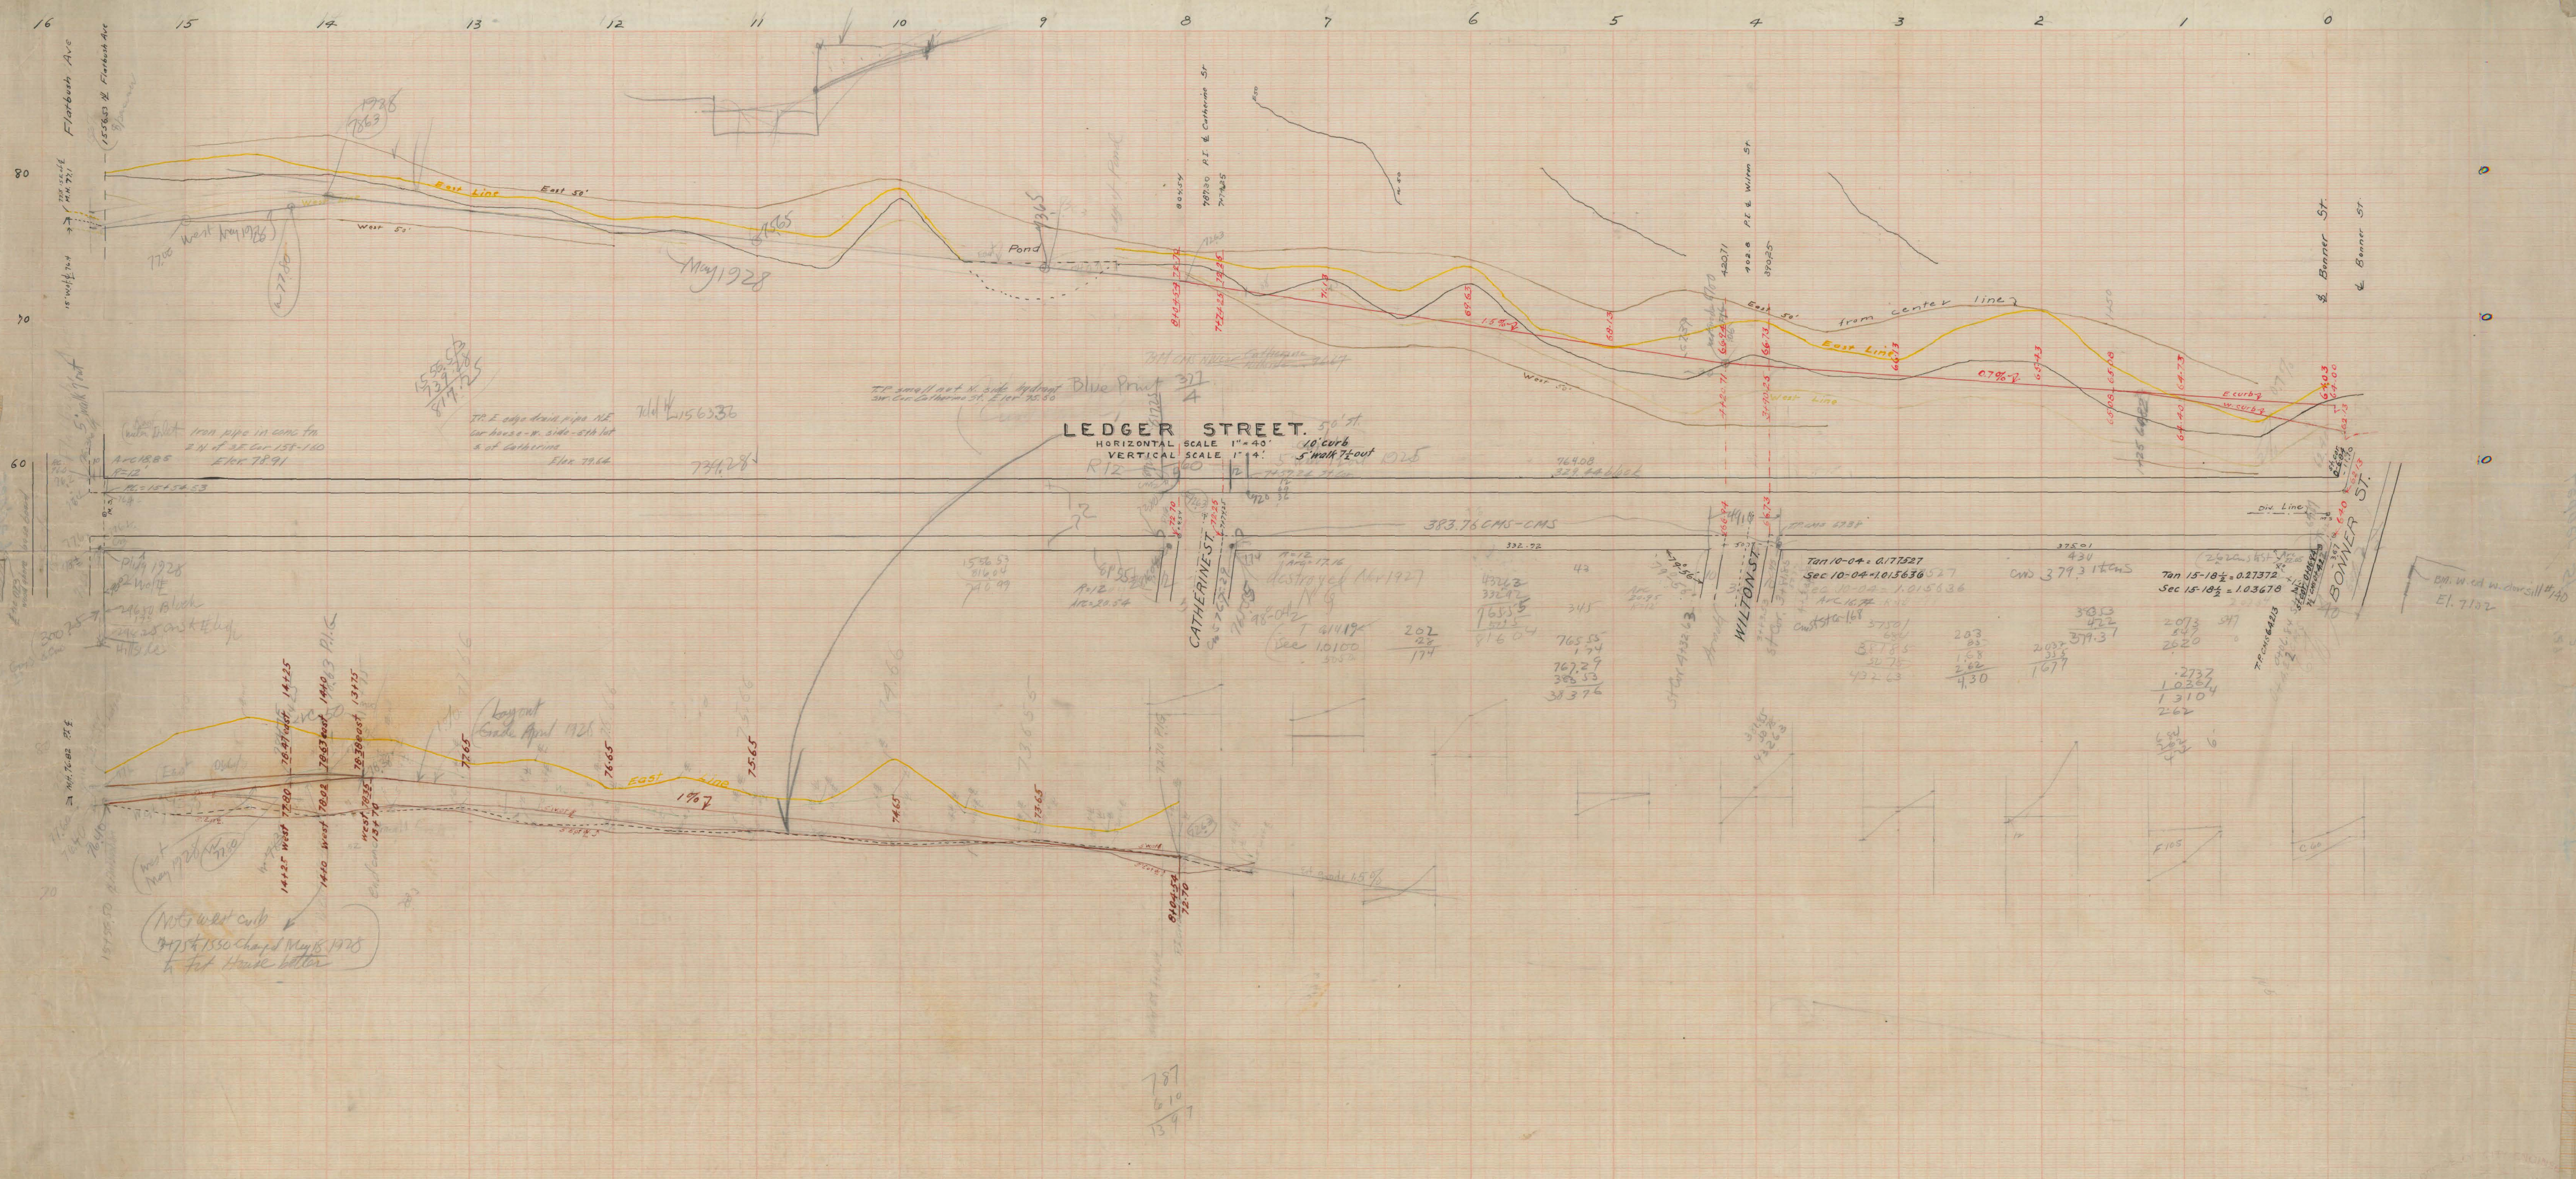

LEDGER STREET.
HORIZONTAL SCALE 1"=40'
VERTICAL SCALE 1"=4'

10' curb
5' walk 7' out

383.76 CMS-CMS

332.22

432.3
332.9
765.3
501.5
816.04

765.55
1.74
767.29
383.76

202
28
174

787
610
1397

787
610
1397

