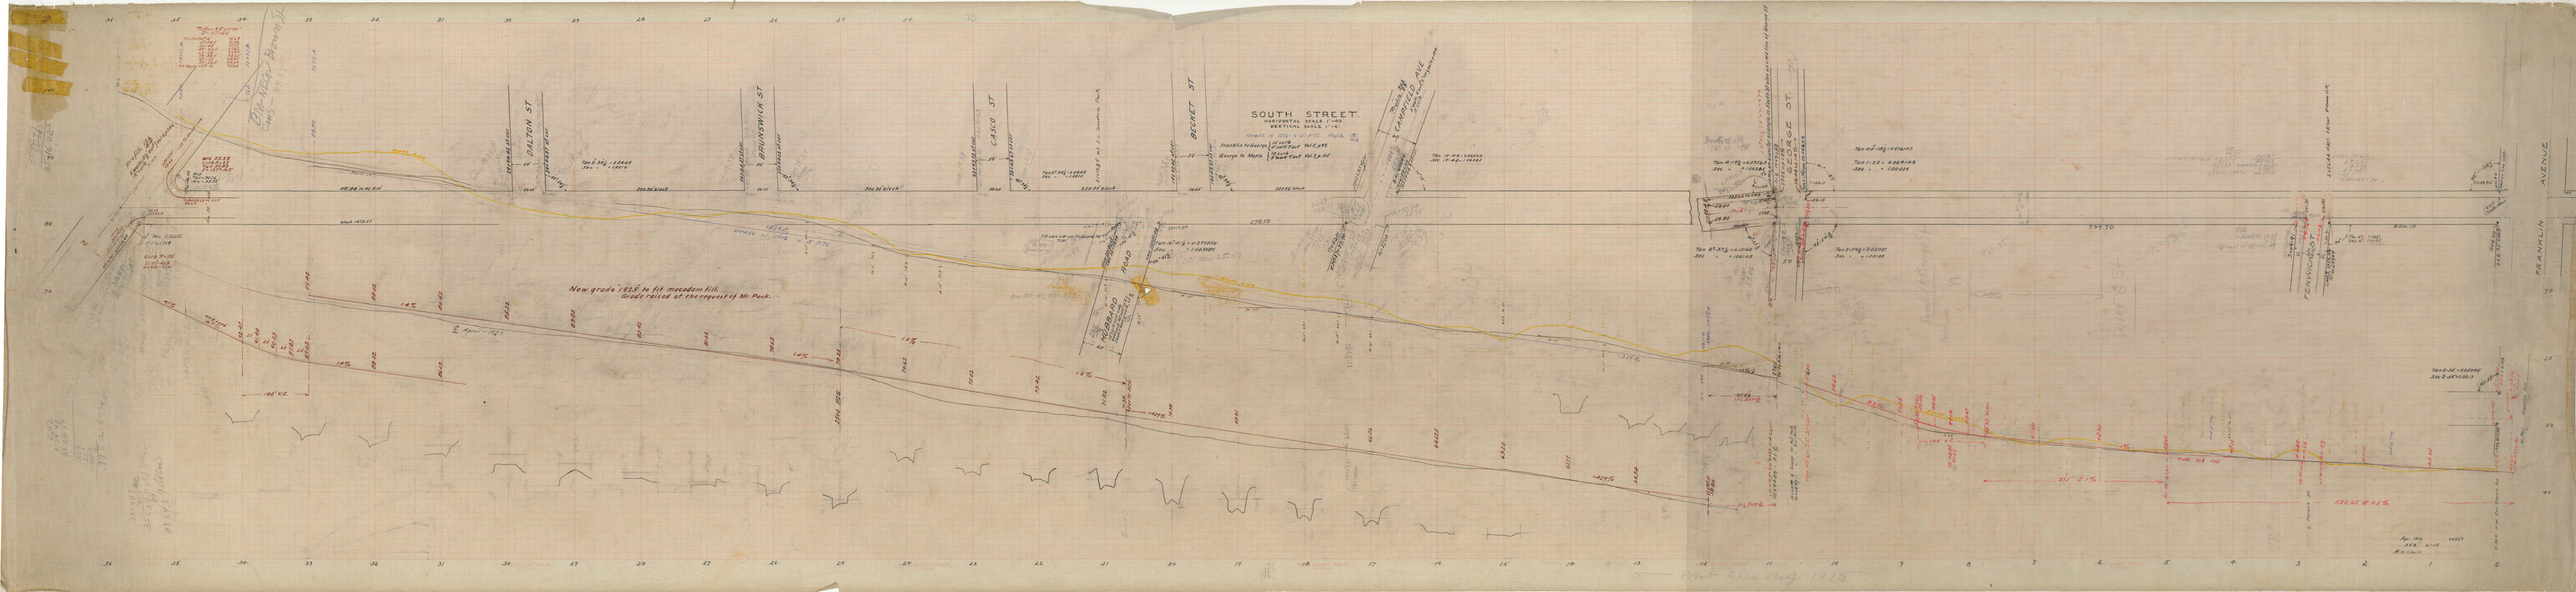
SOUTH STREET.
HORIZONTAL SCALE 1"=40'
VERTICAL SCALE 1"=4'
DALTON ST.
BRUNSWICK ST.
CASCO ST.
BECKET ST.
FRANKLIN AVENUE
New grade 1915 to fit macadam fill.
Grade raised at the request of Mr Peck.
E. April 1915