
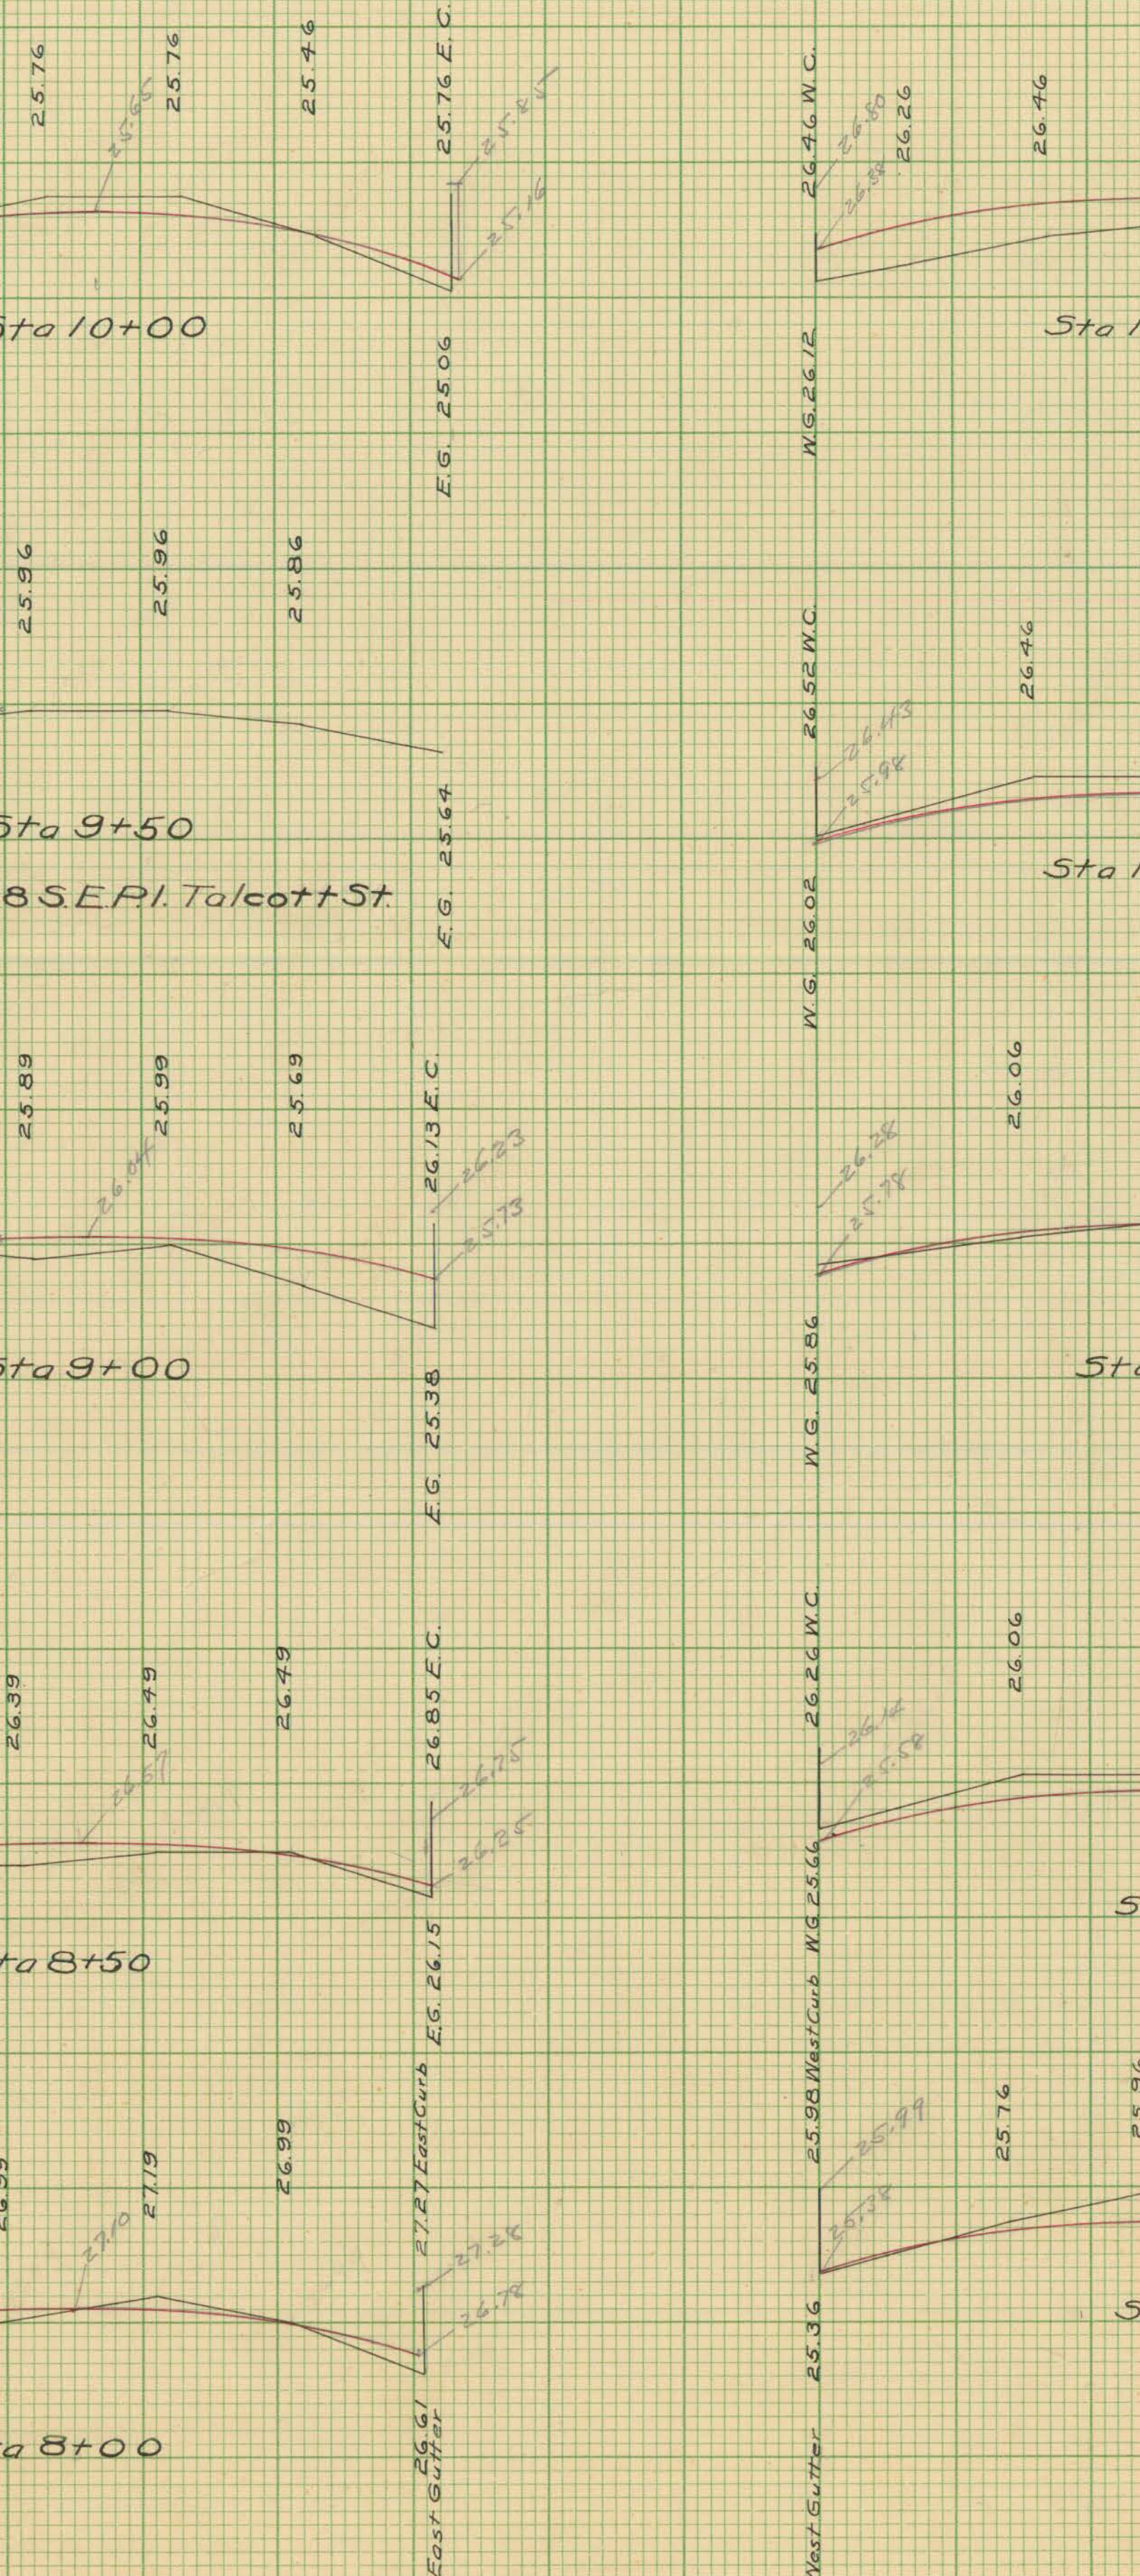
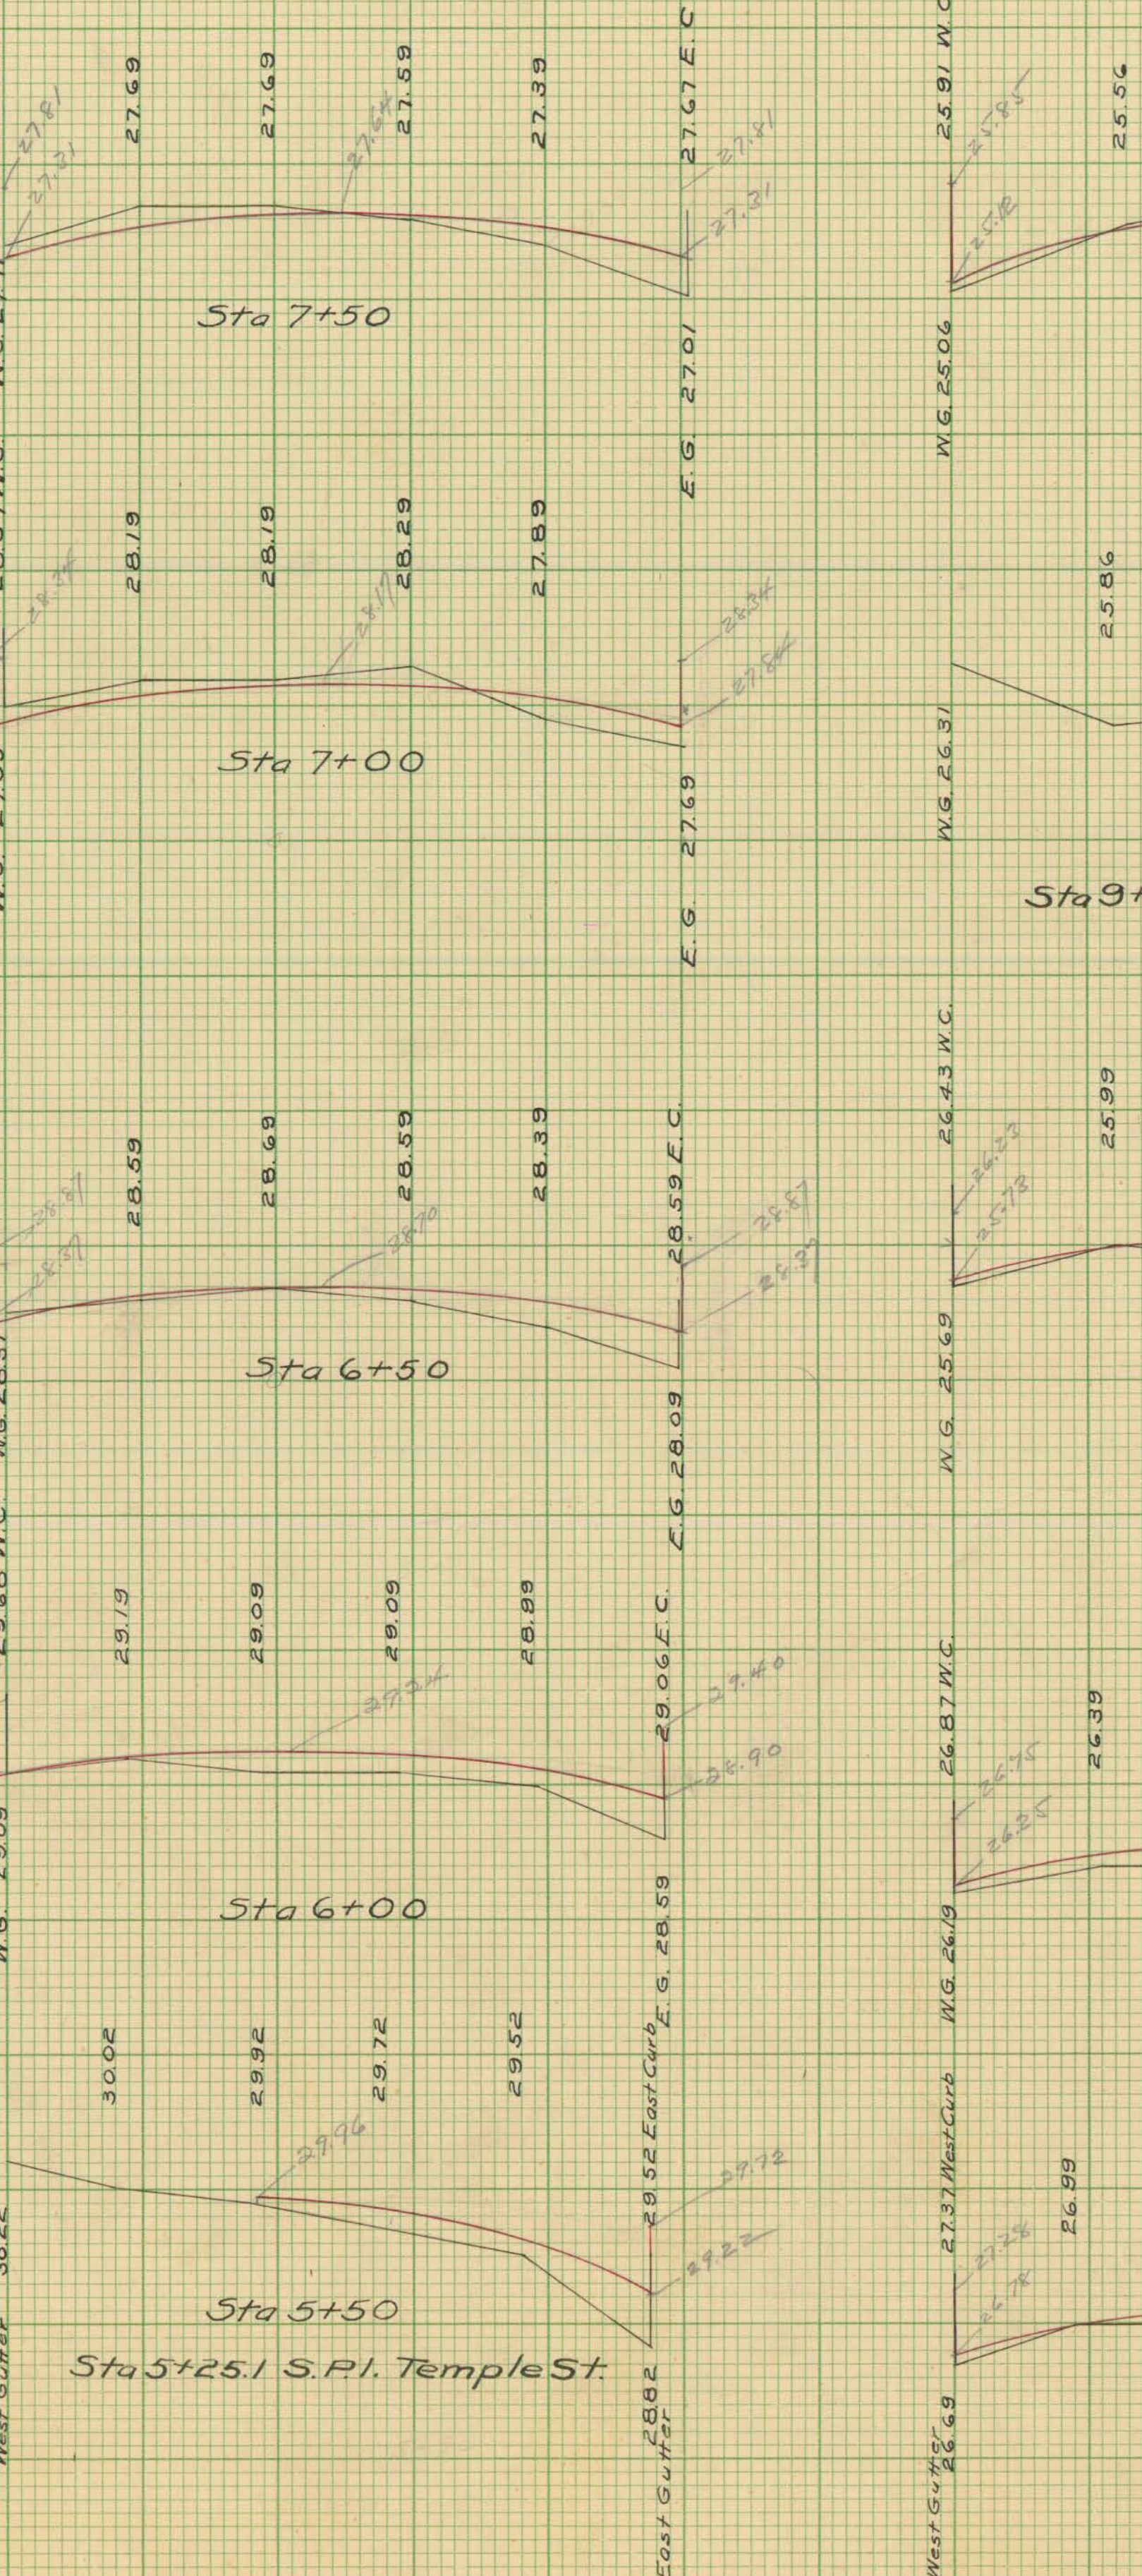
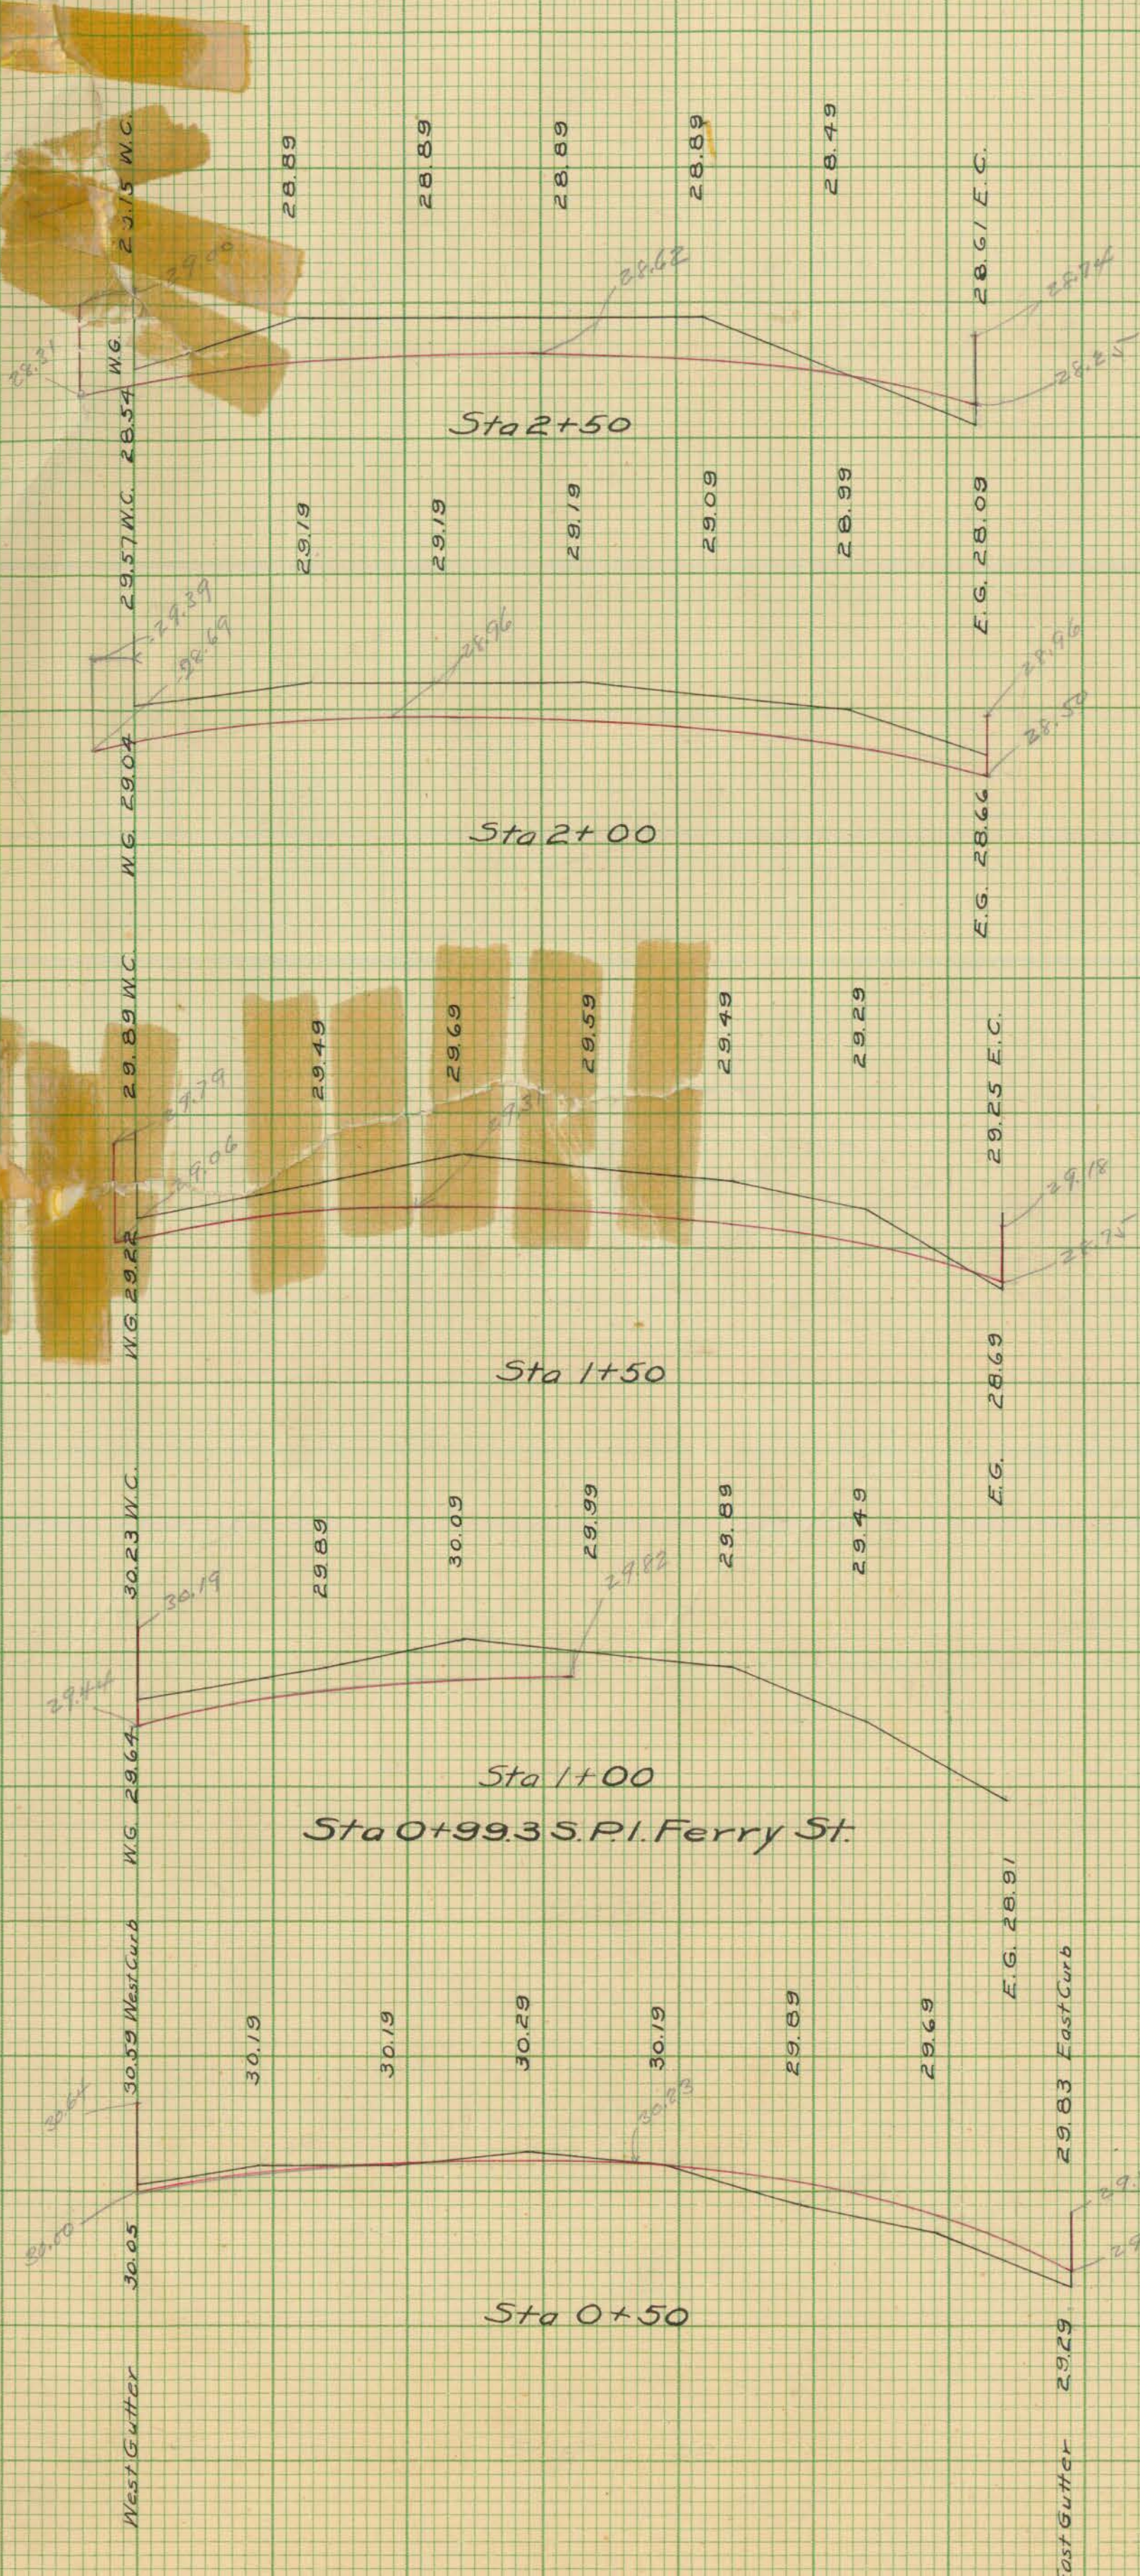


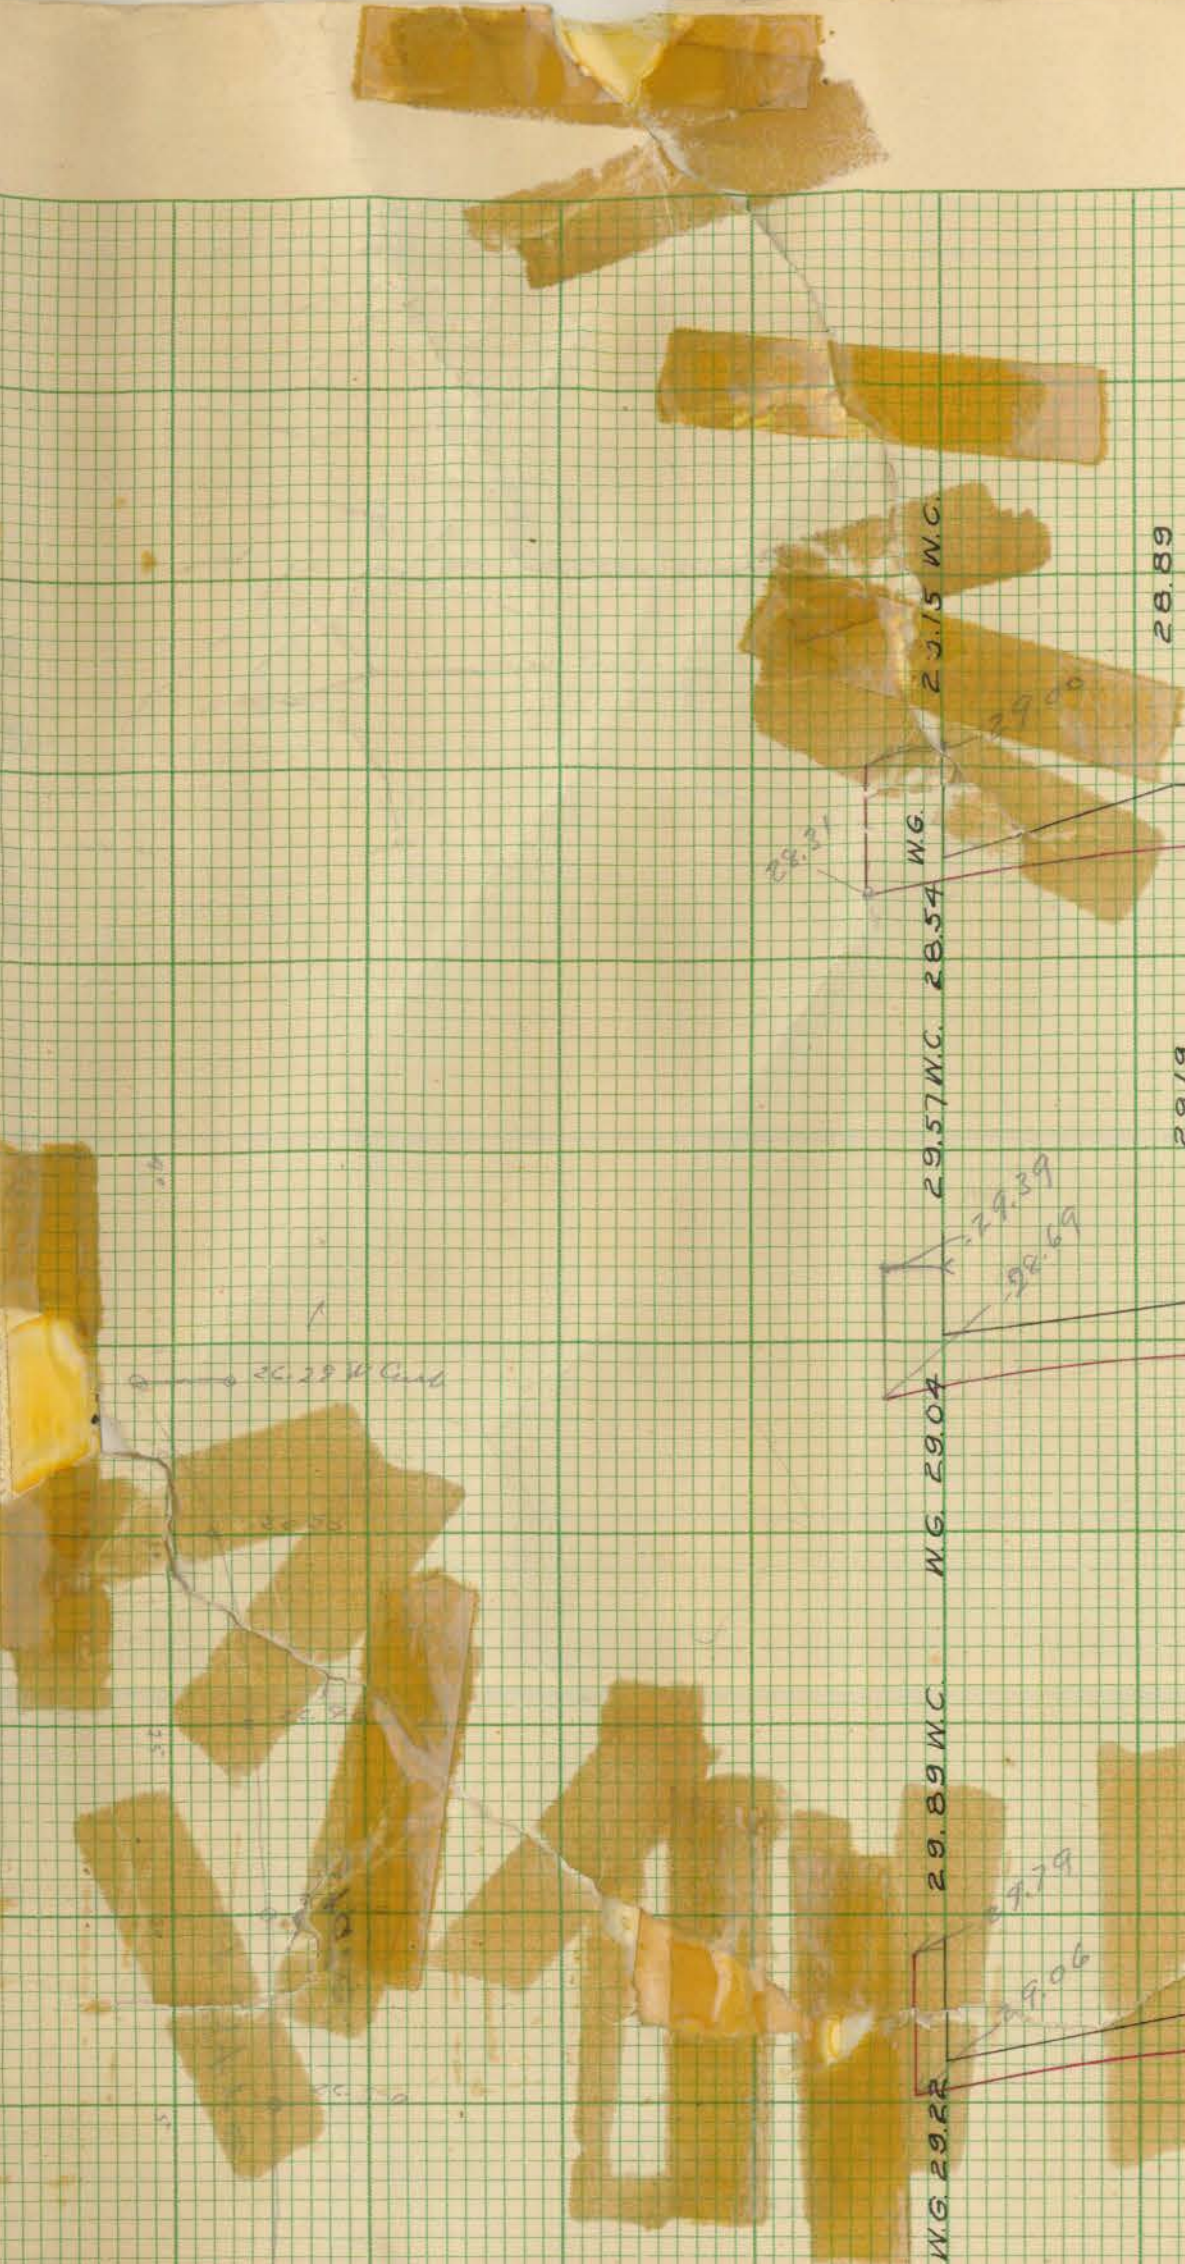

FRONT STREET
STATE STREET TO MORGAN STREET
HORIZONTAL SCALE 1" = 5'
VERTICAL SCALE 1" = 1'
Note: Stations Measured on East Curb
Sta 0+00 at NE Pl. State St.
Note Book #364
See Profile 135-35
FEB. 1913.