MORGAN STREET SECTIONS

MARKET STREET TO FRONT STREET

HORIZONTAL SCALE 1"=5'

VERTICAL SCALE 1"=1'

FEB. 1913.

Note - Sta. 0+00 at S.E.P.C. Market St.
Stations Measured on South Curb

Note Book #364
See Profile 127-9

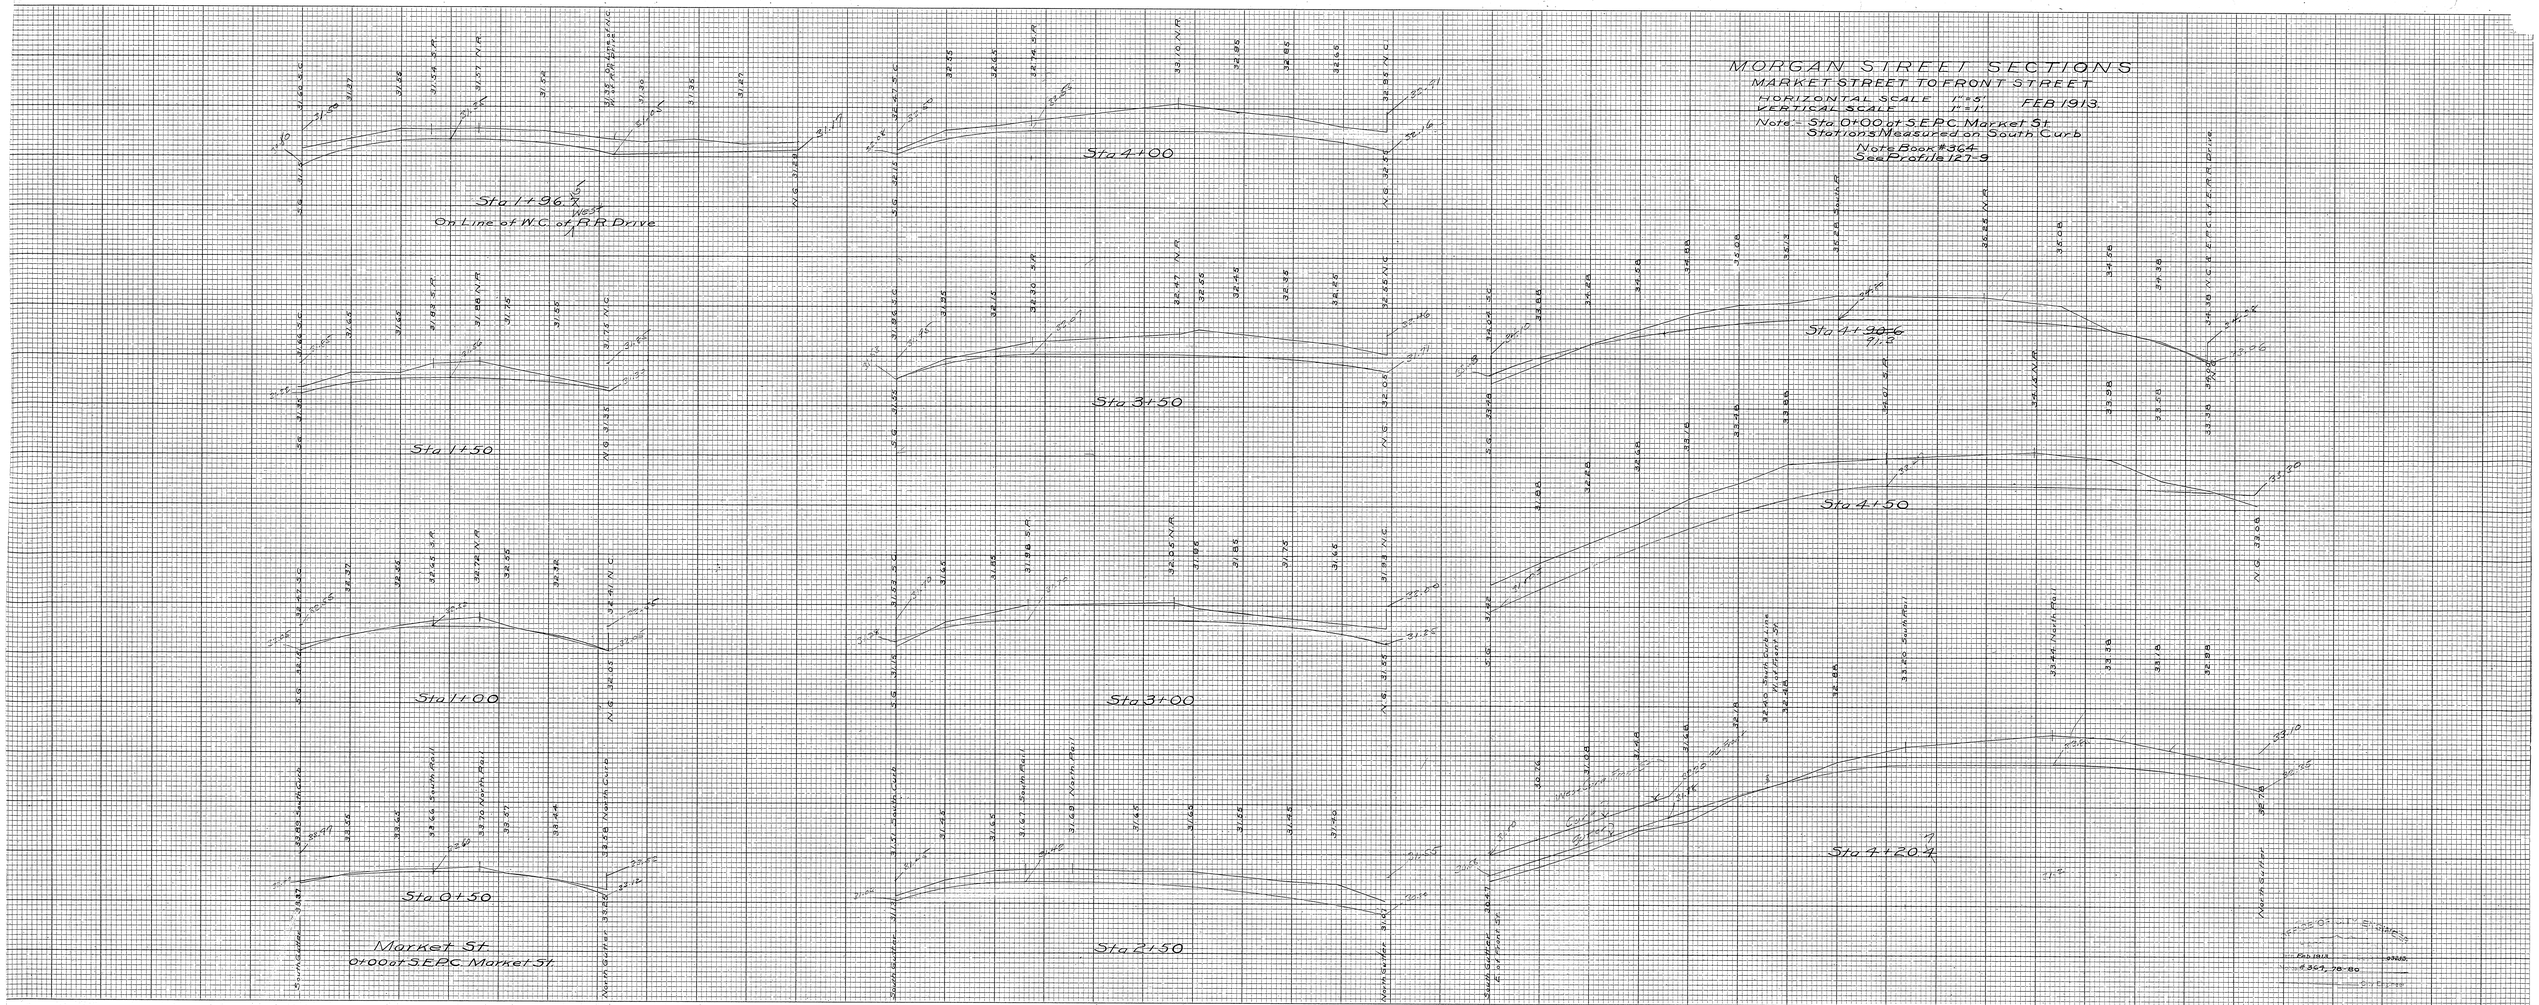

"Stafed" CROSS SECTION PAPER. 10 X 10 - 1 INCH.
EUGENE DIETZGEN Co.

"Stafed" CROSS SECTION PAPER. 10 X 10 - 1 INCH.
EUGENE DIETZGEN Co.

"Stafed" CROSS SECTION PAPER. 10 X 10 - 1 INCH.
EUGENE DIETZGEN Co.