


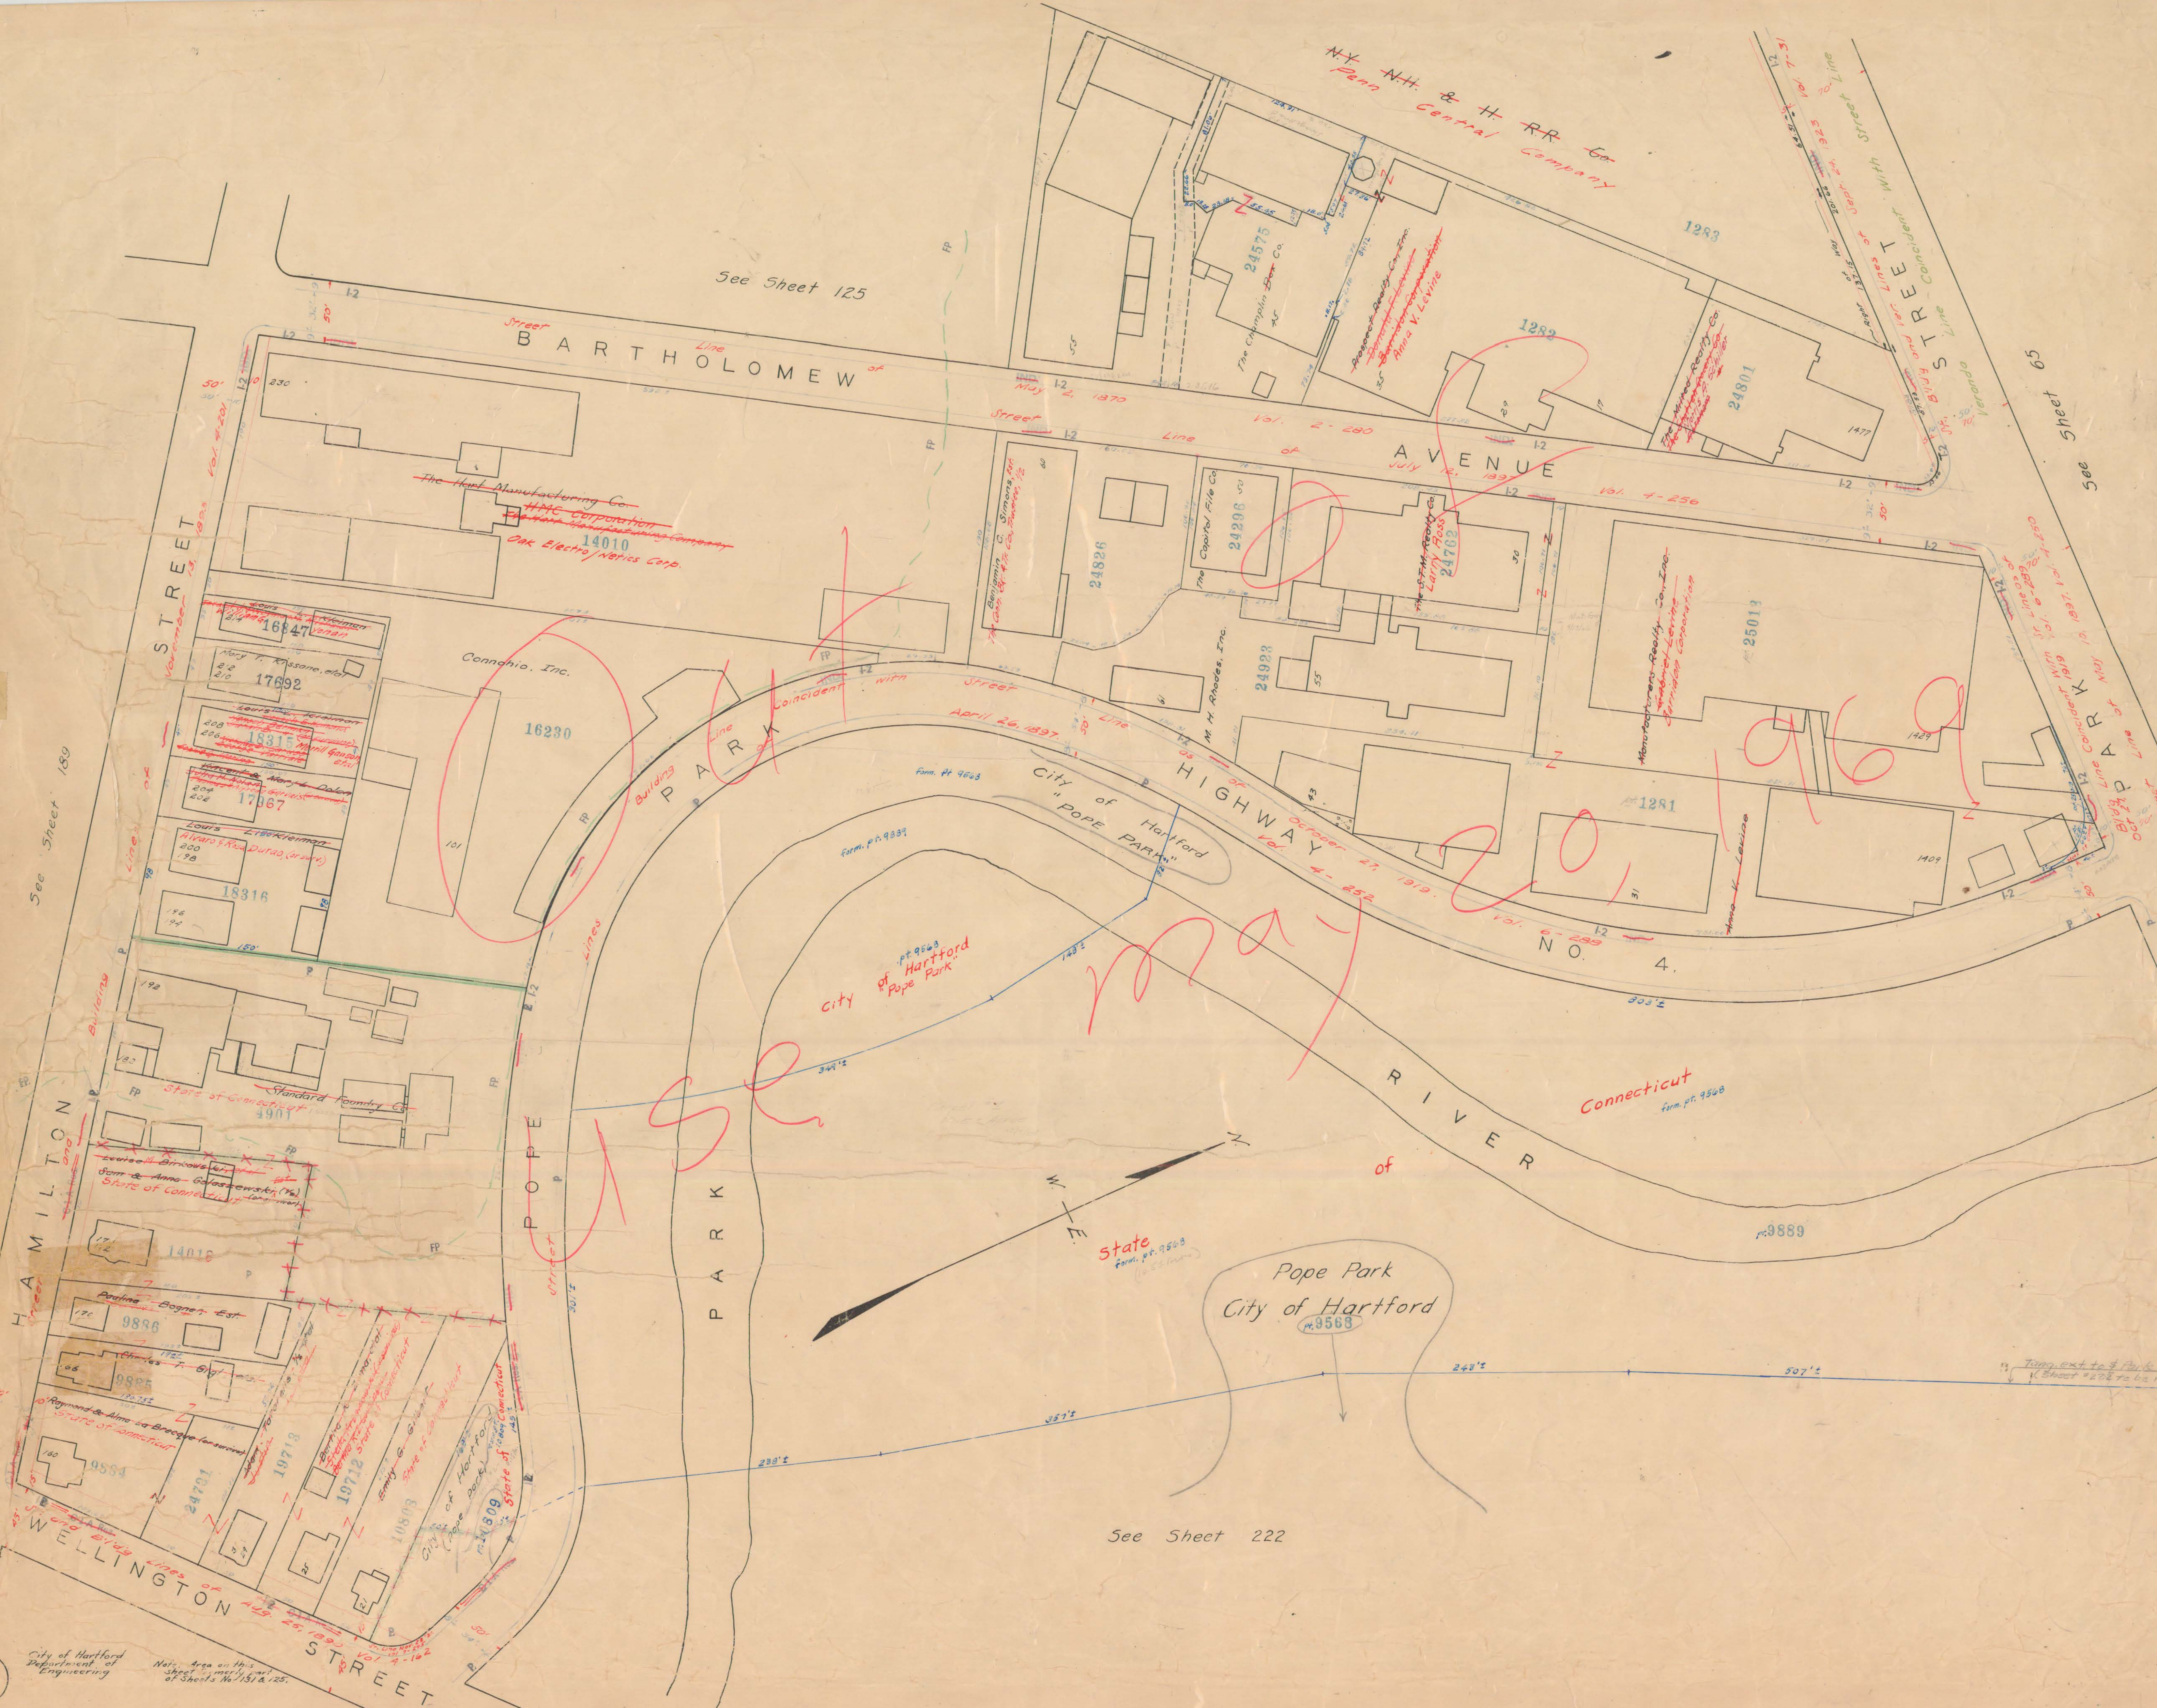

City of Hartford
Department of
Engineering
Note: Area on this map
of Sheets No. 151 & 125.