

Out of Service

July 27 1939

TOWN OF WINDSOR

KENEY PARK


See Sheet No. 221

STREET

See Sheet No. 151

Out of Service, July 27-39

Out of Service

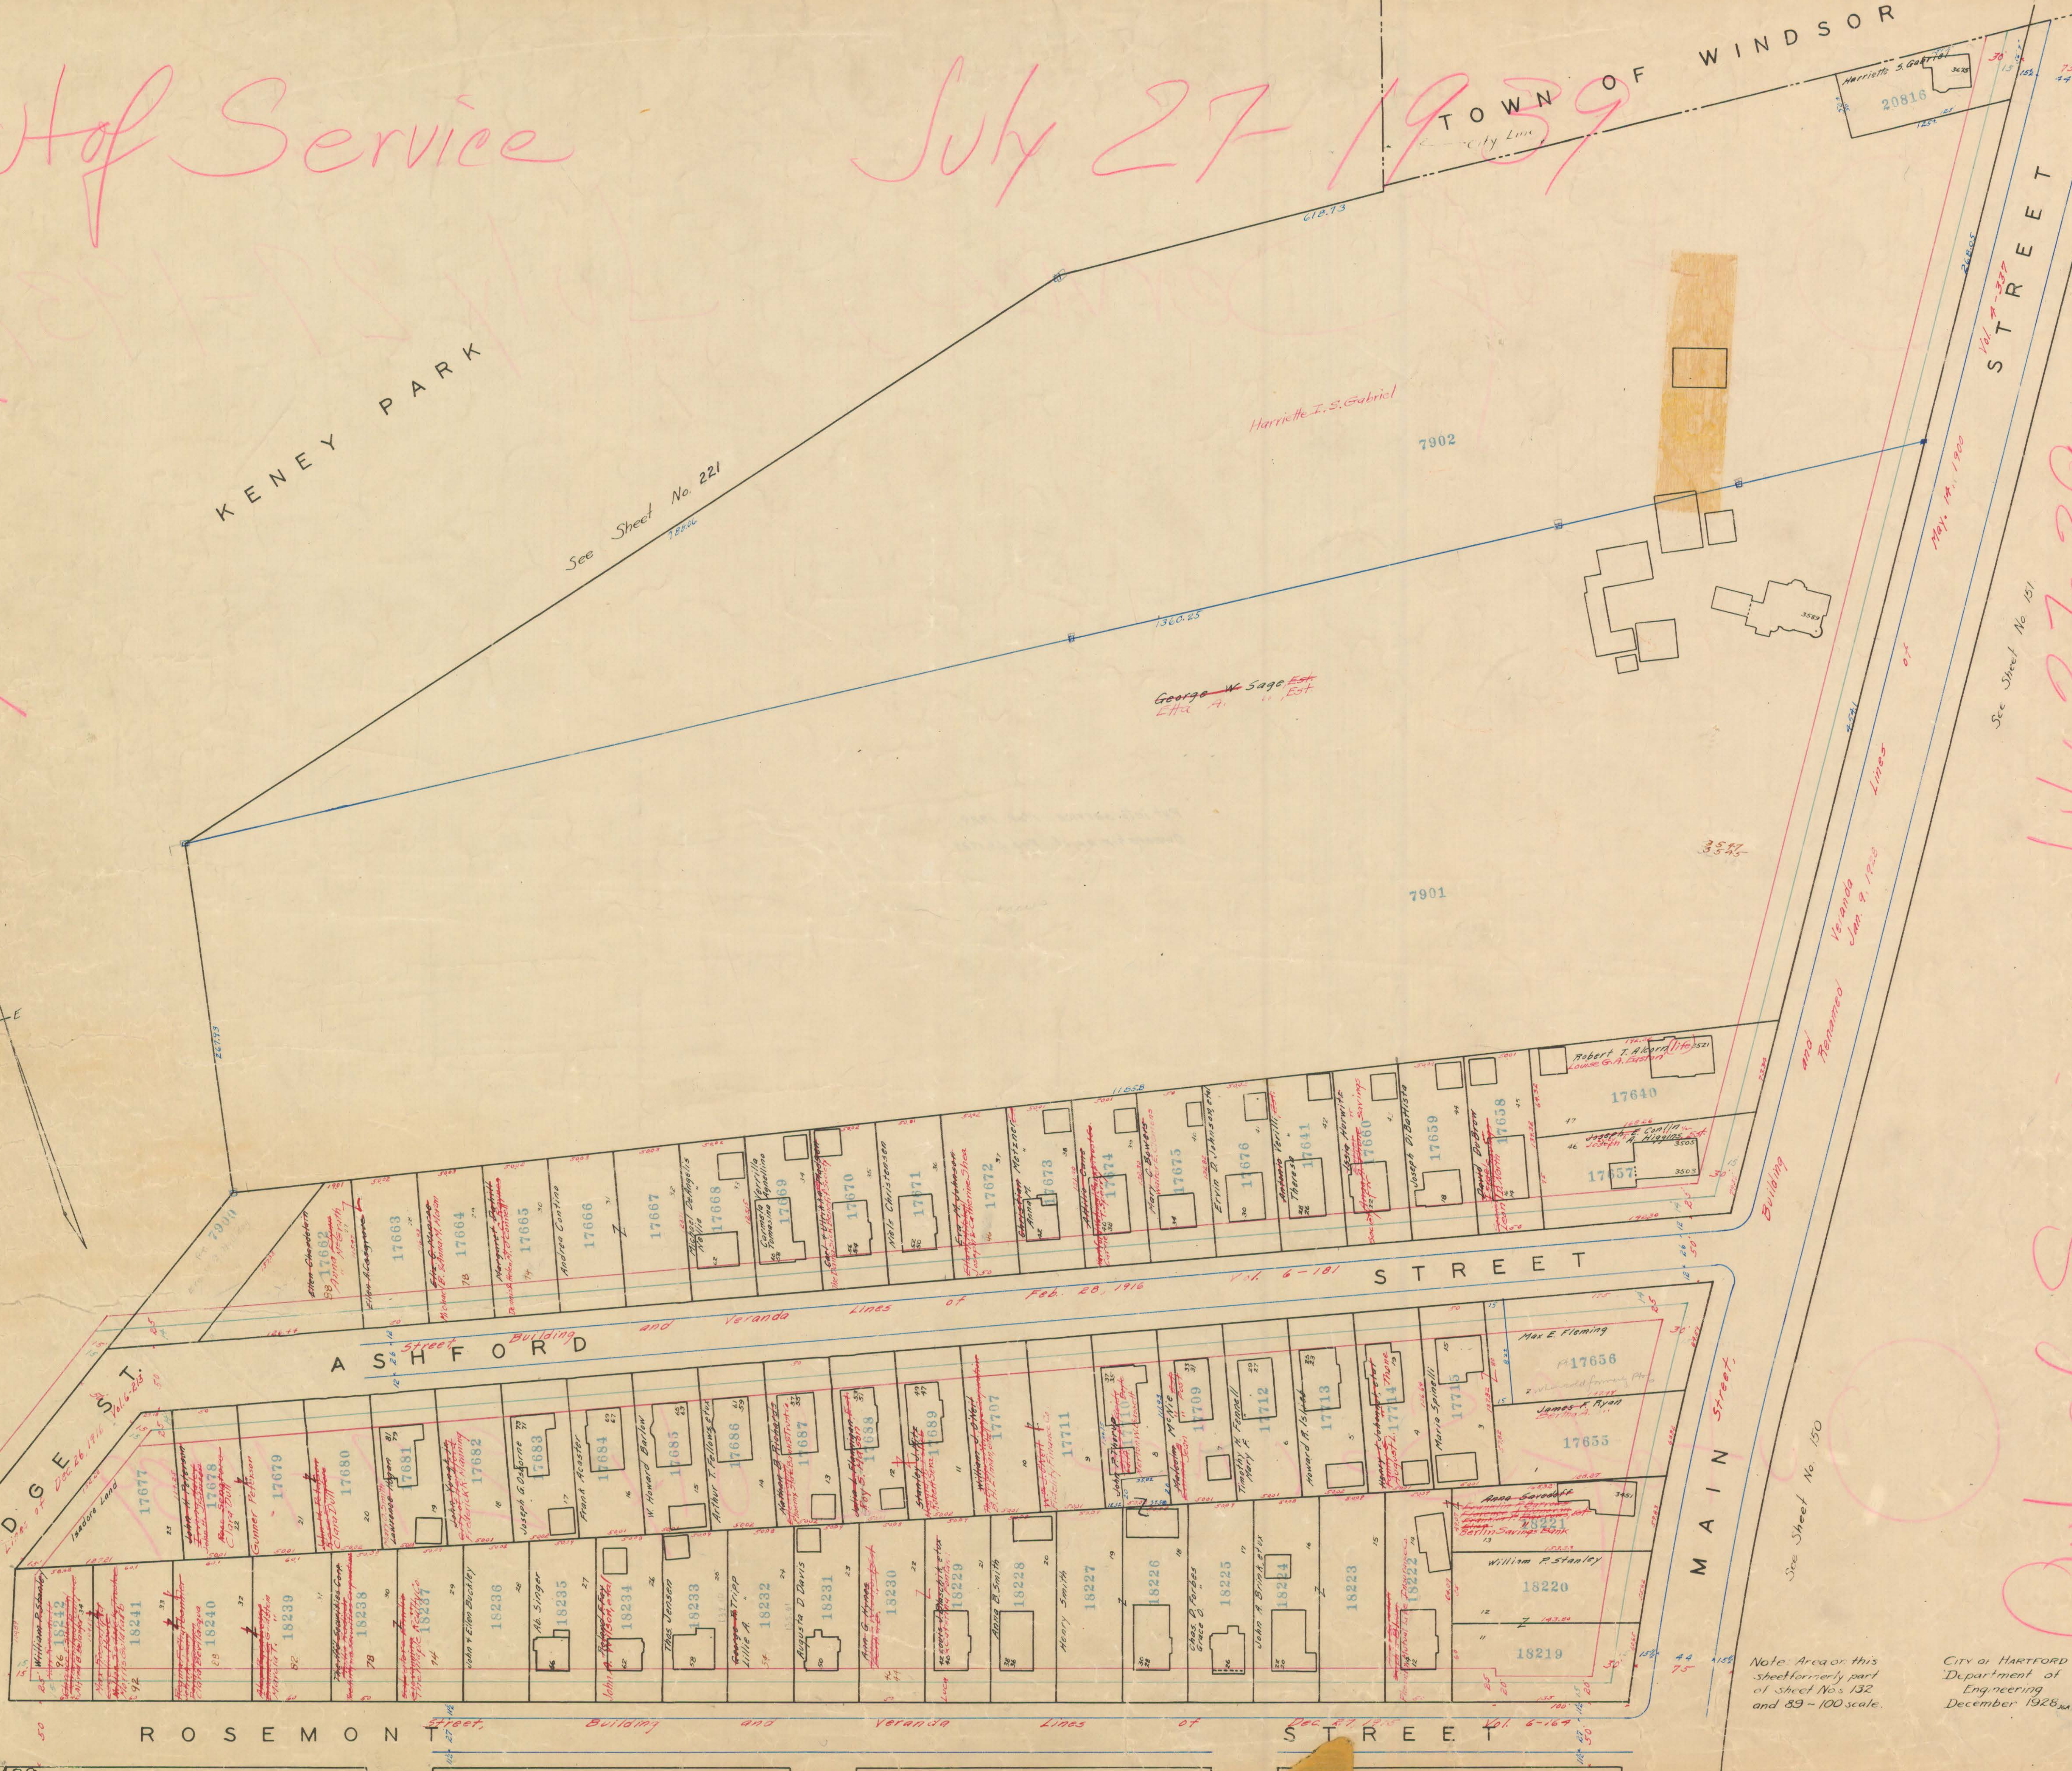

Note: Area on this sheet formerly part of sheet Nos 132 and 89-100 scale.

CITY OF HARTFORD
Department of
Engineering
December 1928