


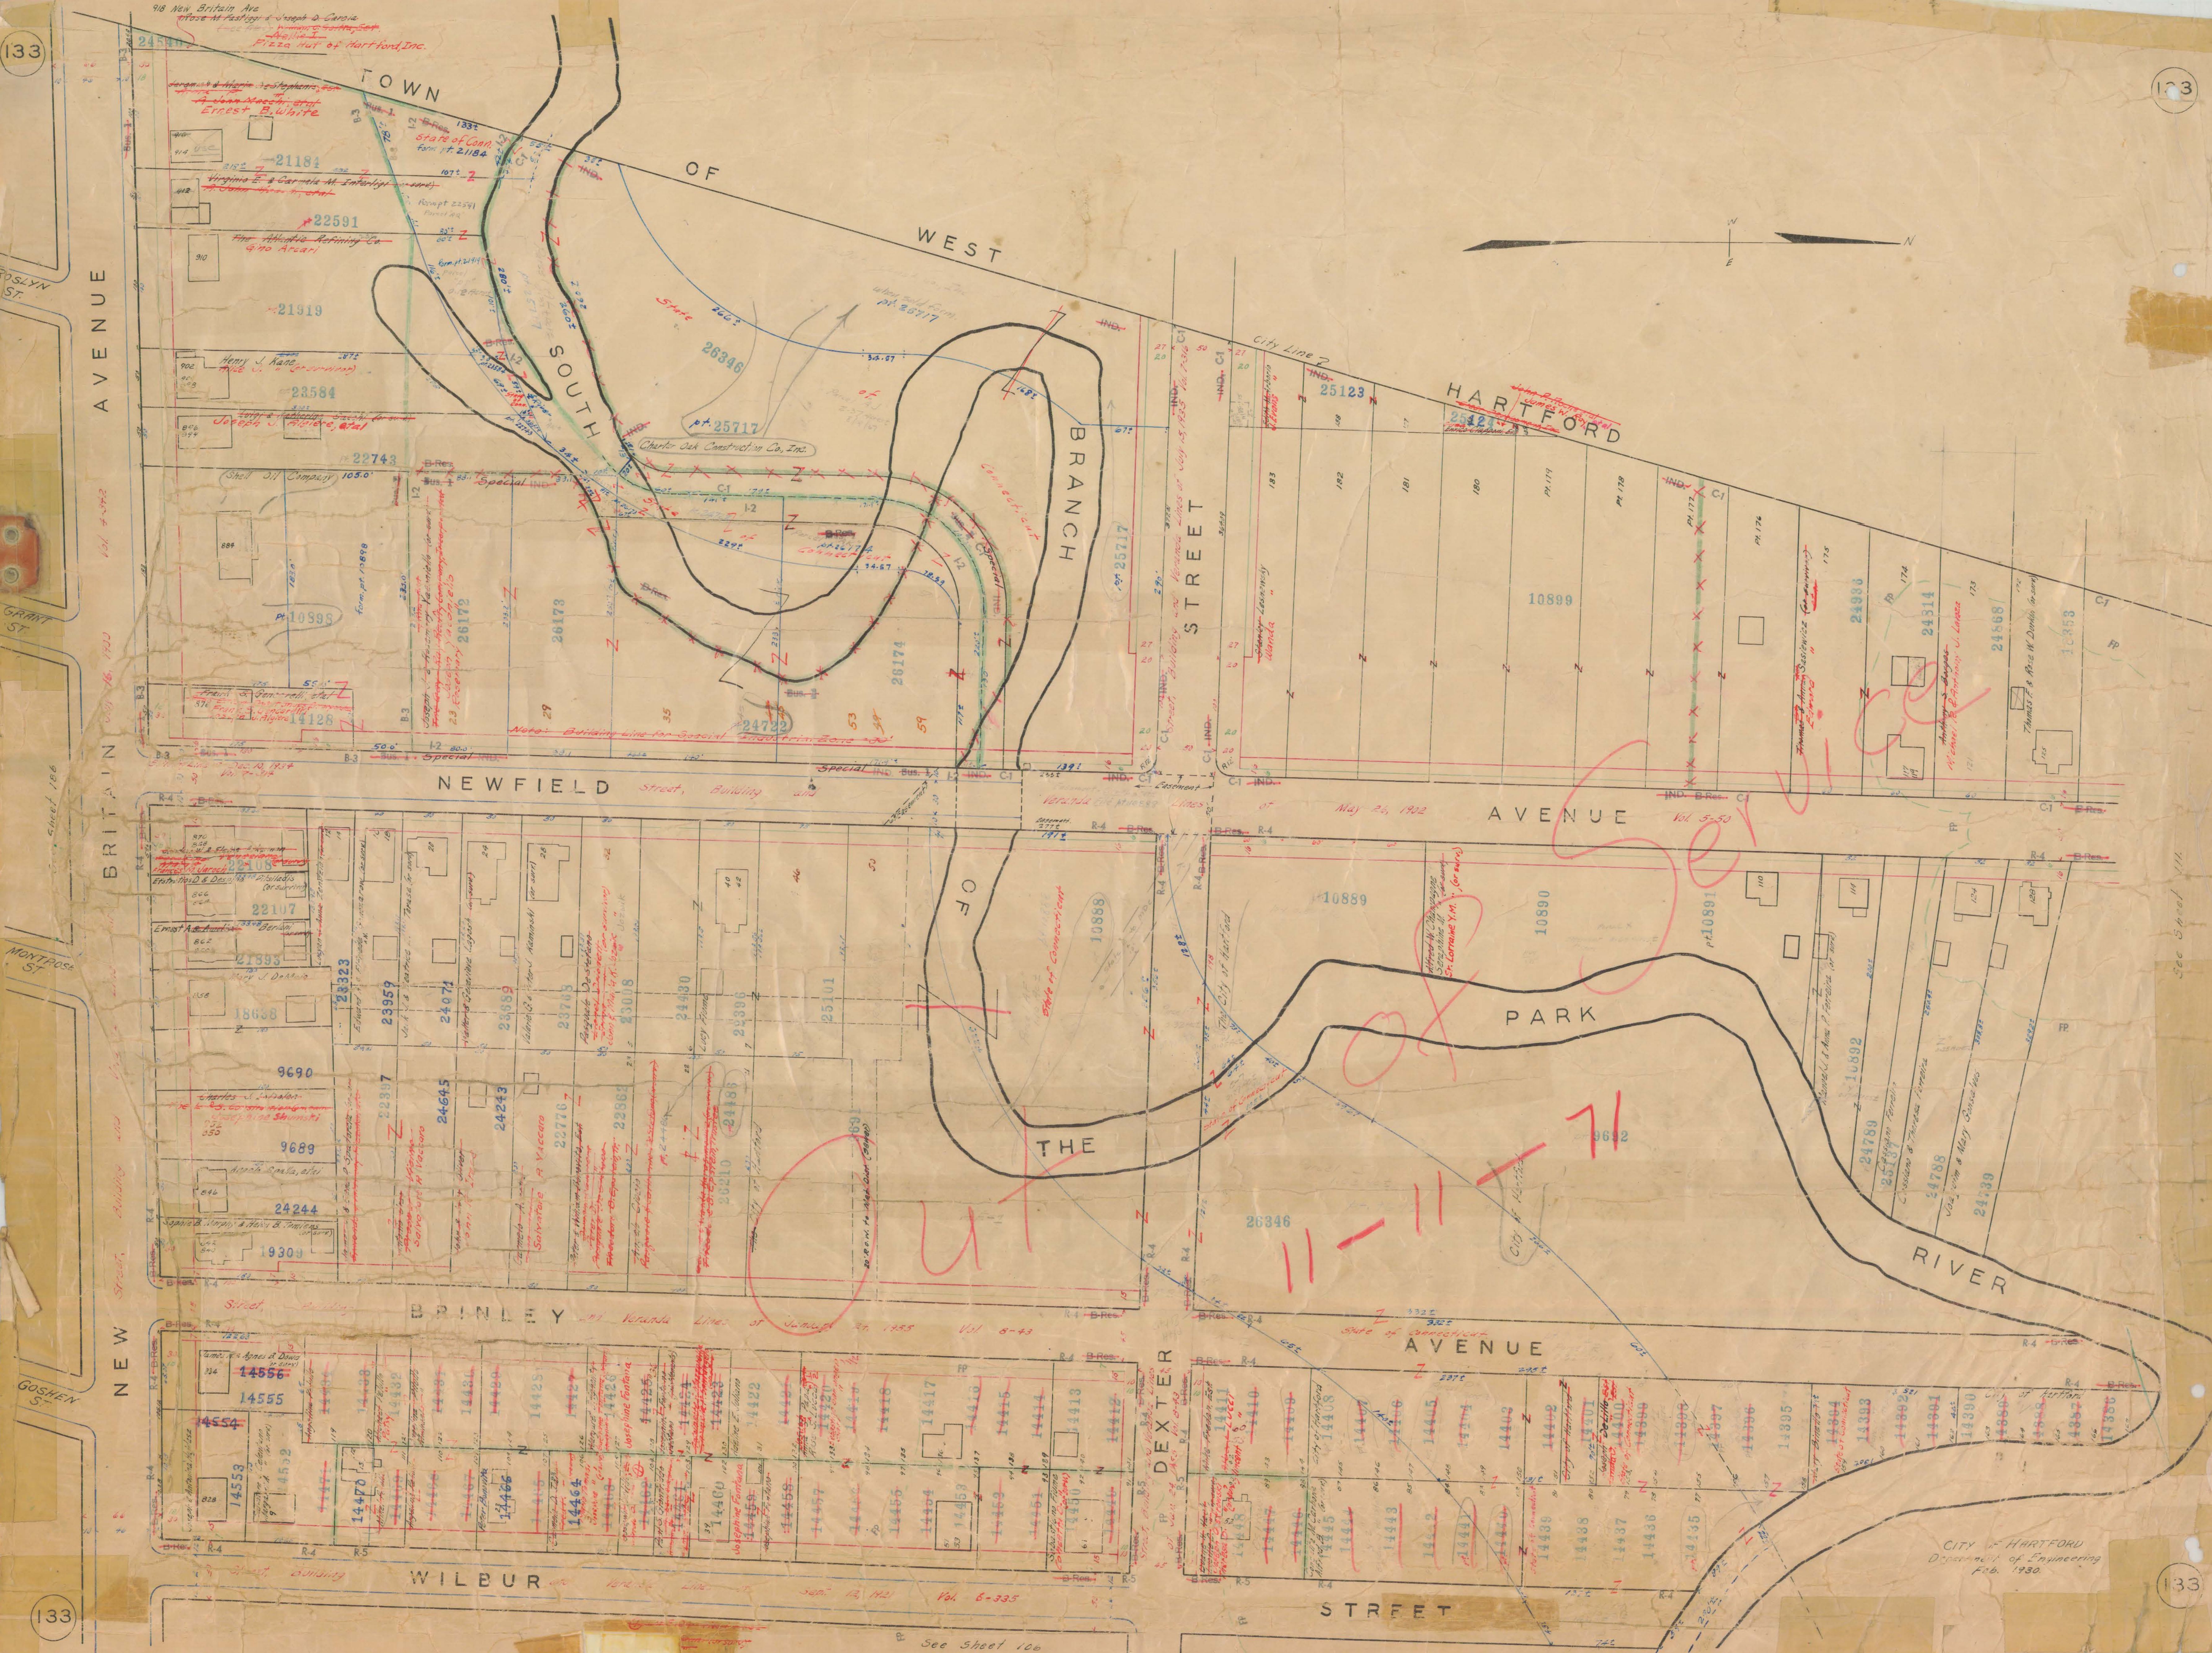

ROSLYN ST

GRANT ST


GOSHEN ST

See Sheet 100

CITY OF HARTFORD
Department of Engineering
Feb. 1930.