


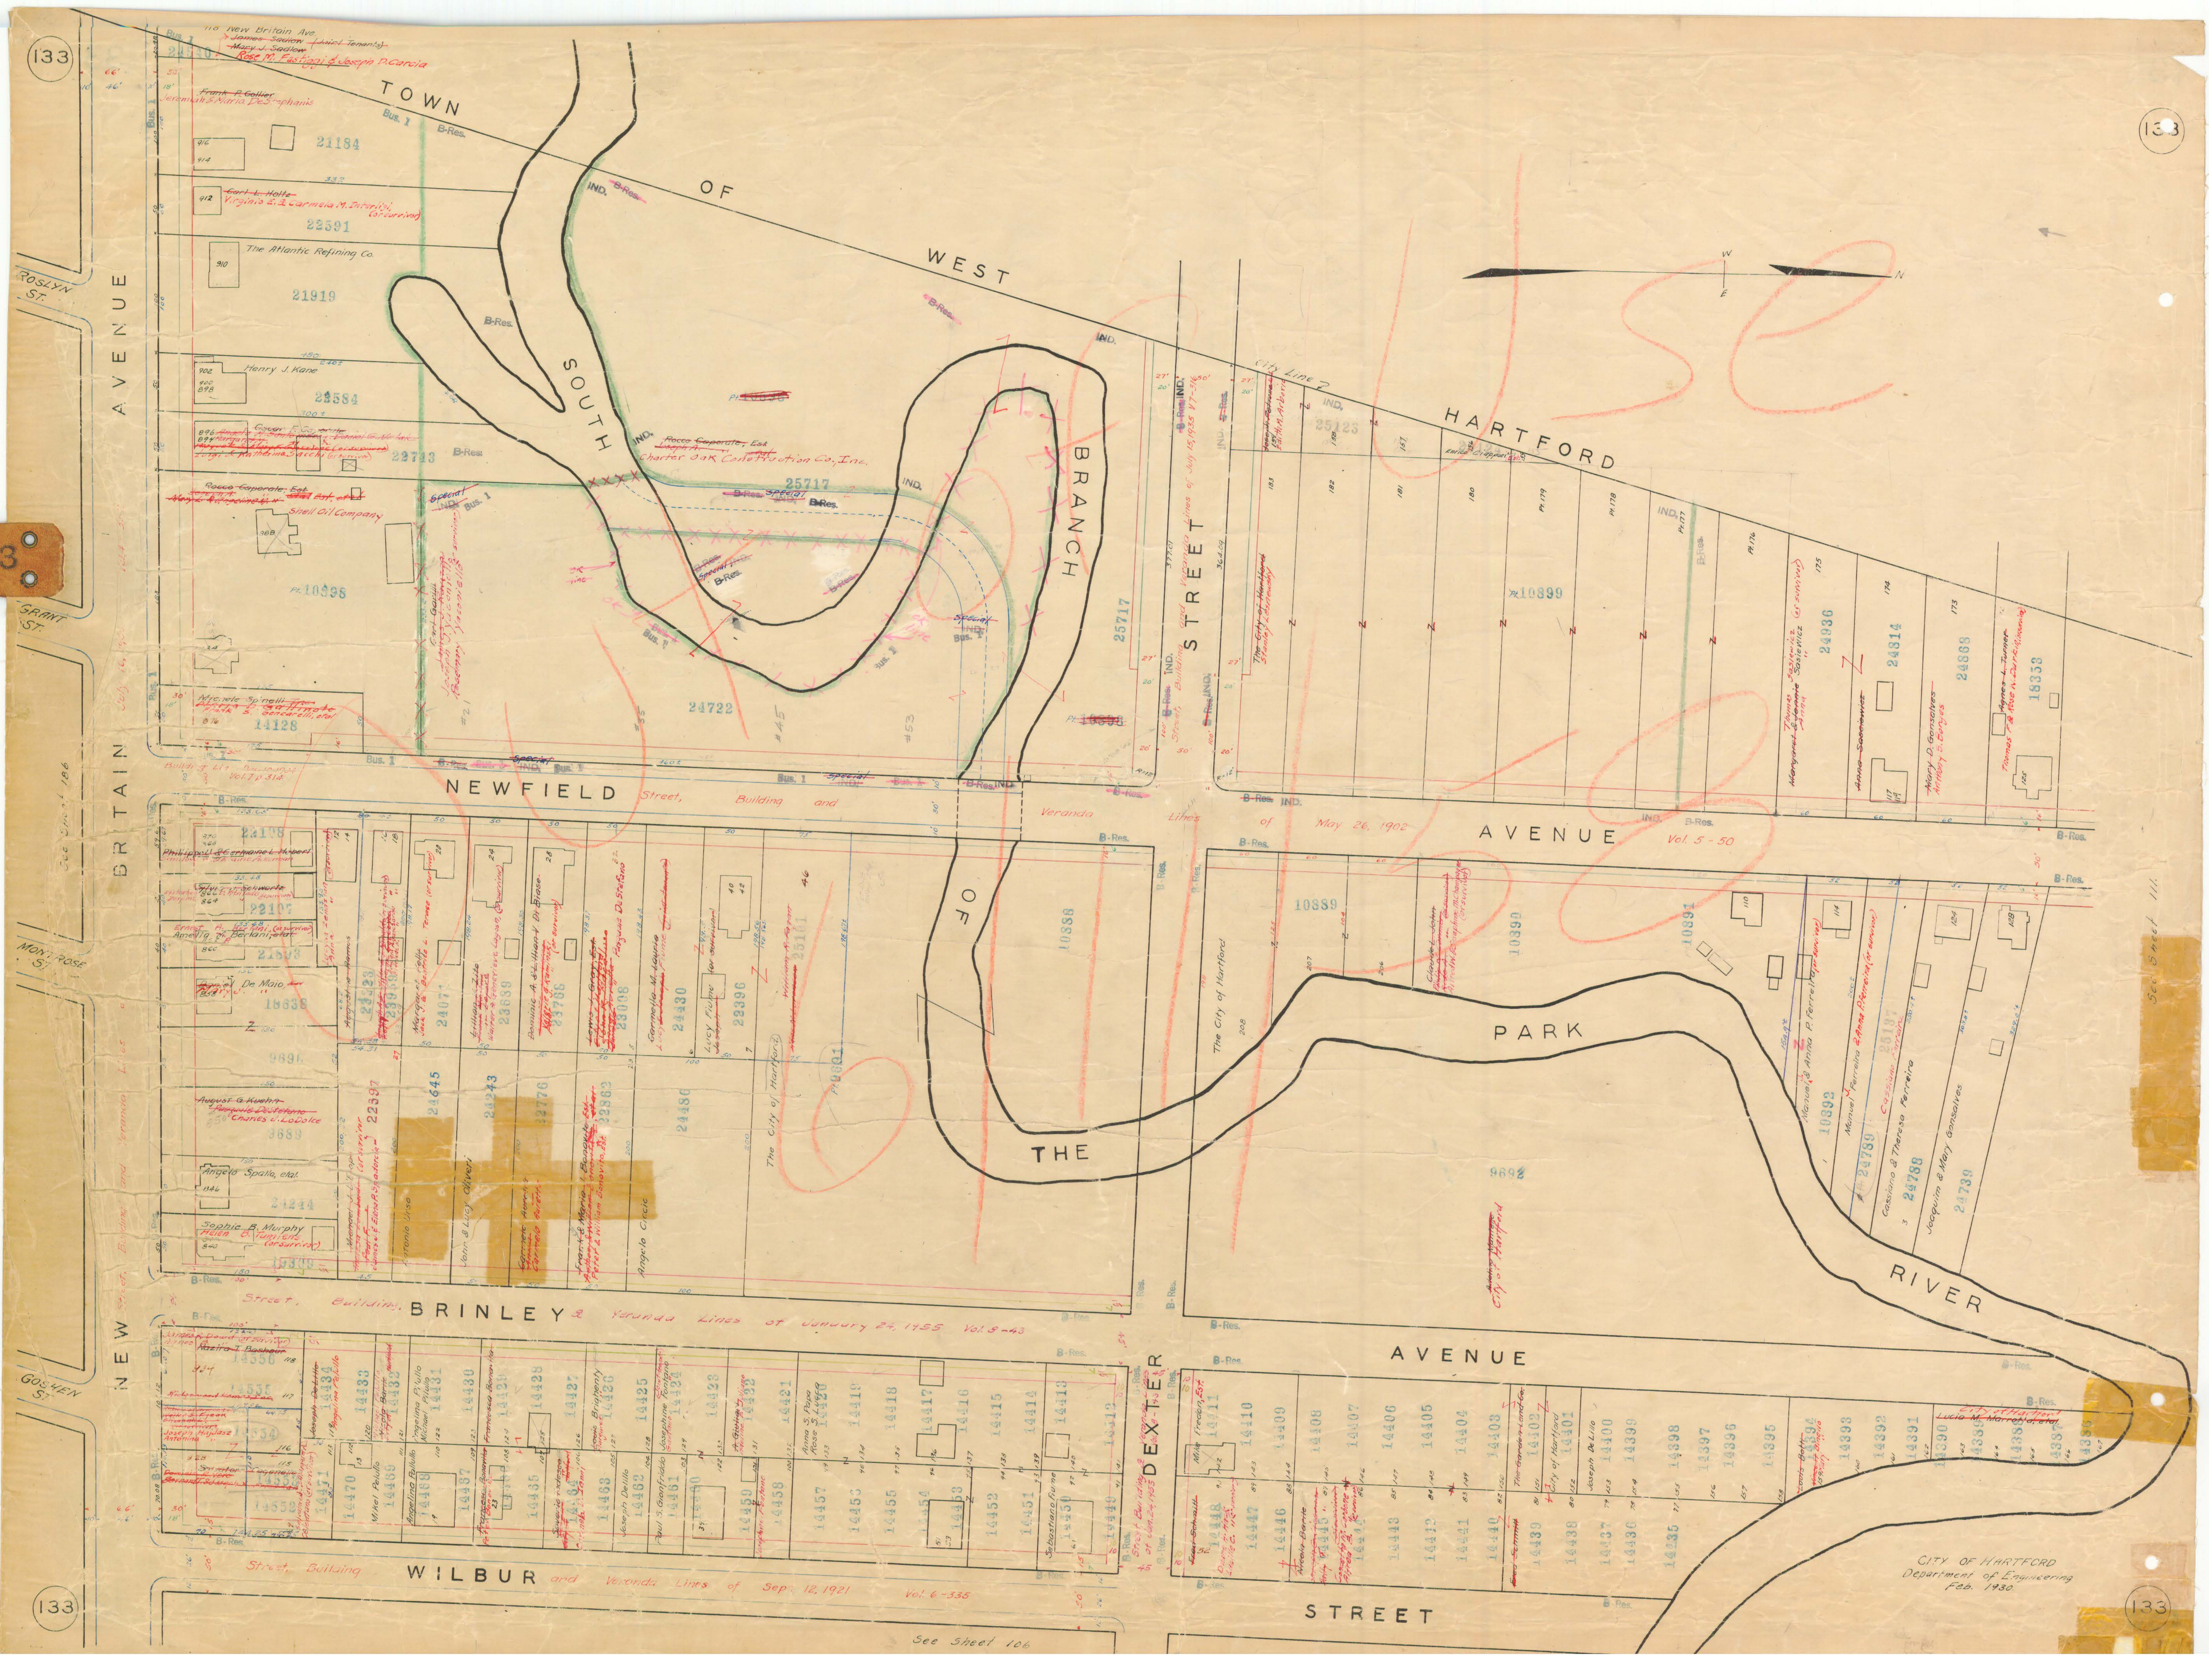

CITY OF HARTFORD
Department of Engineering
Feb. 1930

See Sheet 106

See Sheet 111