131/8

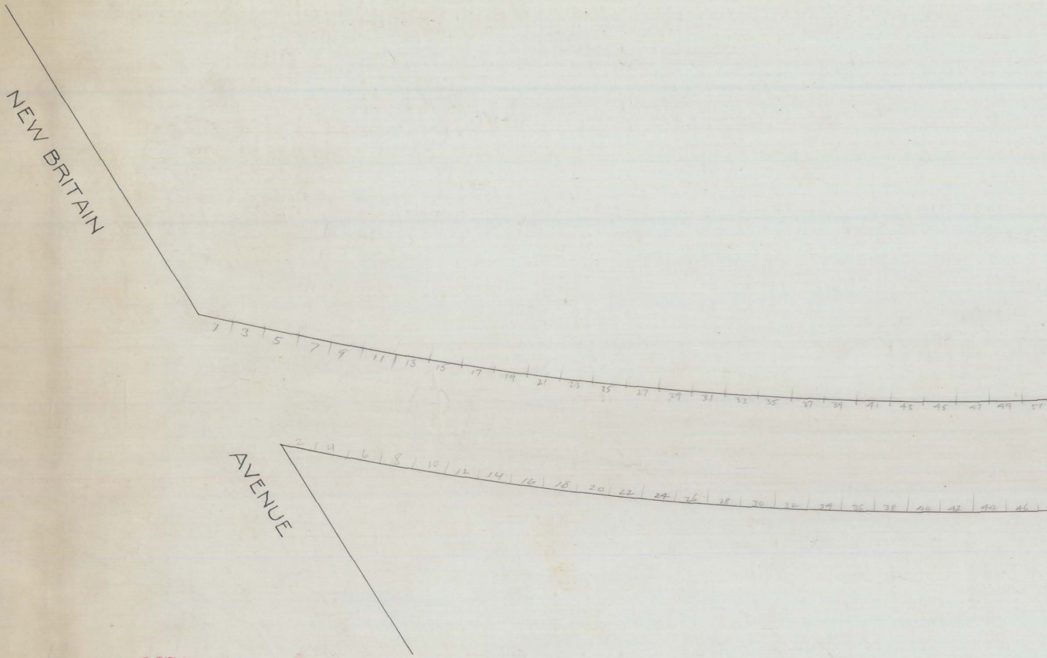
NEW BRITAIN
AVENUE
1 3 5 7 9 11 13 15 17 19 21 23 25 27 29 31 33 35 37 39 41 43 45 47 49 51
2 4 6 8 10 12 14 16 18 20 22 24 26 28 30 32 34 36 38 40 42 44 46

OFFICE OF CITY ENGINEER
HARTFORD, CONN.
Date May-1912 Day Book No. 02975
Notes,
City Engineer

8/131

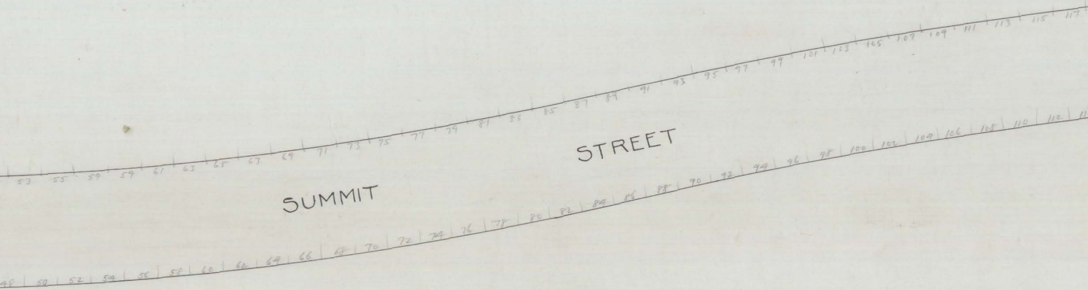
SUMMIT
STREET
53
55
57
59
61
63
65
67
69
71
73
75
77
79
81
83
85
87
89
91
93
95
97
99
101
103
105
107
109
111
113
115
117
48
50
52
54
56
58
60
62
64
66
68
70
72
74
76
78
80
82
84
86
88
90
92
94
96
98
100
102
104
106
108
110
112

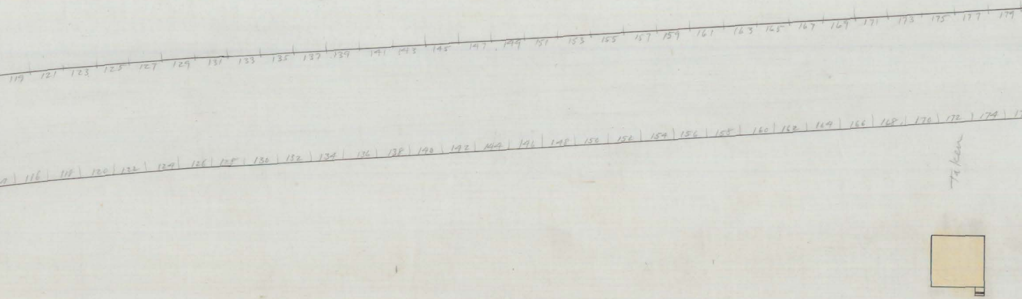

119 121 123 125 127 129 131 133 135 137 139 141 143 145 147 149 151 153 155 157 159 161 163 165 167 169 171 173 175 177 179
116 118 120 122 124 126 128 130 132 134 136 138 140 142 144 146 148 150 152 154 156 158 160 162 164 166 168 170 172 174
Taken

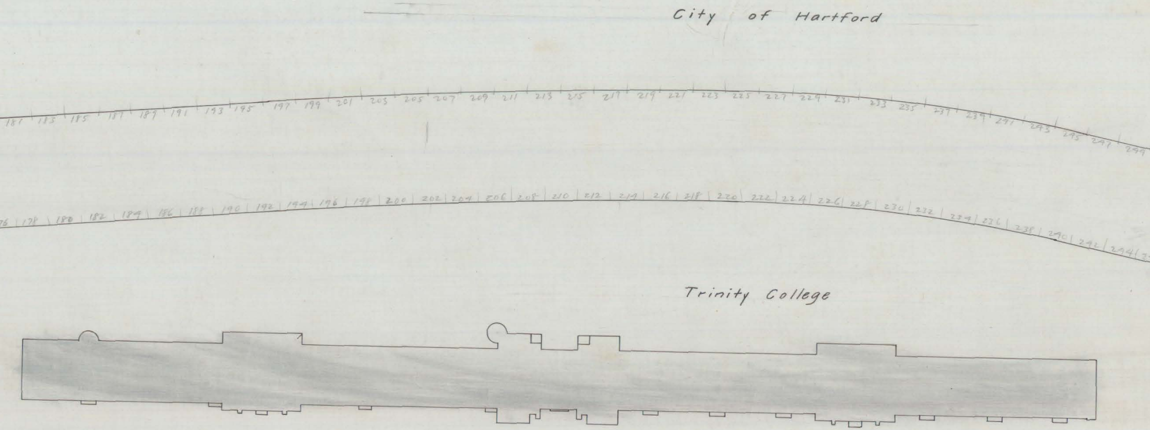
City of Hartford
181 183 185 187 189 191 193 195 197 199 201 203 205 207 209 211 213 215 217 219 221 223 225 227 229 231 233 235 237 239 241 243 245 247 249
176 178 180 182 184 186 188 190 192 194 196 198 200 202 204 206 208 210 212 214 216 218 220 222 224 226 228 230 232 234 236 238 240 242 244
Trinity College

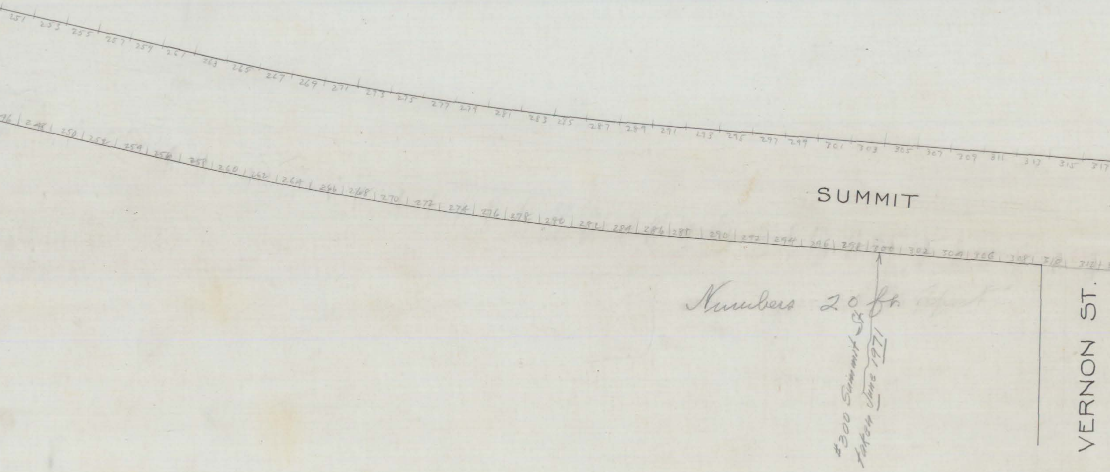
251
253
255
257
259
261
263
265
267
269
271
273
275
277
279
281
283
285
287
289
291
293
295
297
299
301
303
305
307
309
311
313
315
317
246
248
250
252
254
256
258
260
262
264
266
268
270
272
274
276
278
280
282
284
286
288
290
292
294
296
298
300
302
304
306
308
310
312
SUMMIT
VERNON ST.
Numbers 20 ft. apart
#300 Summit St.
Taken June 1971

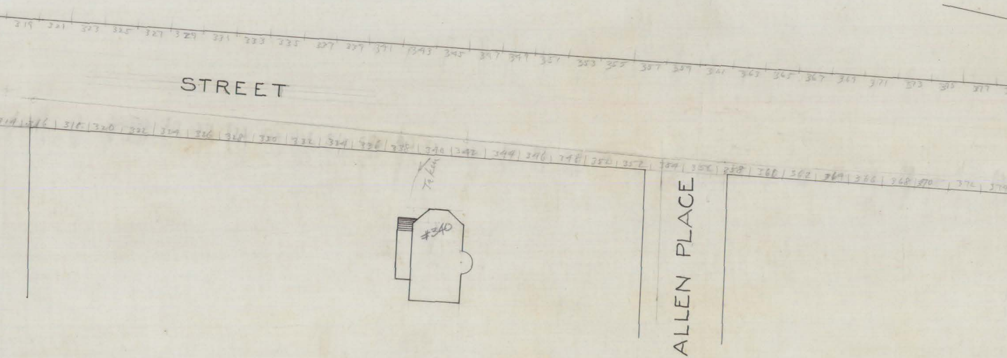
319
321
323
325
327
329
331
333
335
337
339
341
343
345
347
349
351
353
355
357
359
361
363
365
367
369
371
373
375
377
STREET
314
316
318
320
322
324
326
328
330
332
334
336
338
340
342
344
346
348
350
352
354
356
358
360
362
364
366
368
370
372
To Lot
#340
ALLEN PLACE

31.6
12.5
12
66.1

47.7
12
59.7

83-3

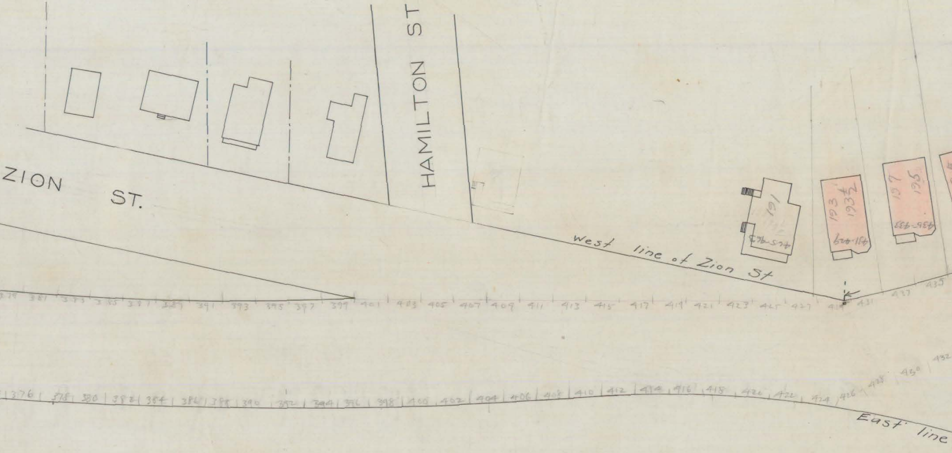
ZION ST.
HAMILTON ST
West line of Zion St
191
425-423
193
193½
431-429
197
195
435-433
379 381 383 385 387 389 391 393 395 397 399 401 403 405 407 409 411 413 415 417 419 421 423 425 427 429 431 433 435
376 378 380 382 384 386 388 390 392 394 396 398 400 402 404 406 408 410 412 414 416 418 420 422 424 426 428 430 432
East line

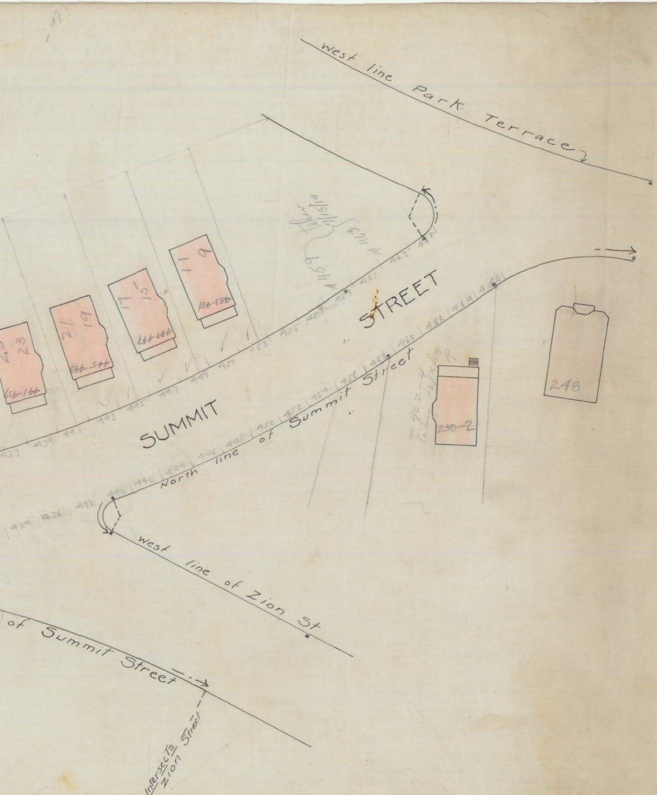

West line Park Terrace
SUMMIT STREET
North line of Summit Street
West line of Zion St
of Summit Street
Intersects Zion Street
23
21
19
17
15
11
9
439-441
443-445
447-449
451-453
248
250-2
437
439
441
443
445
447
449
451
453
455
457
459
461
463
465
434
436
438
440
442
444
446
448
450
452
454
456
458
460
462
464
466
459
463

131/80