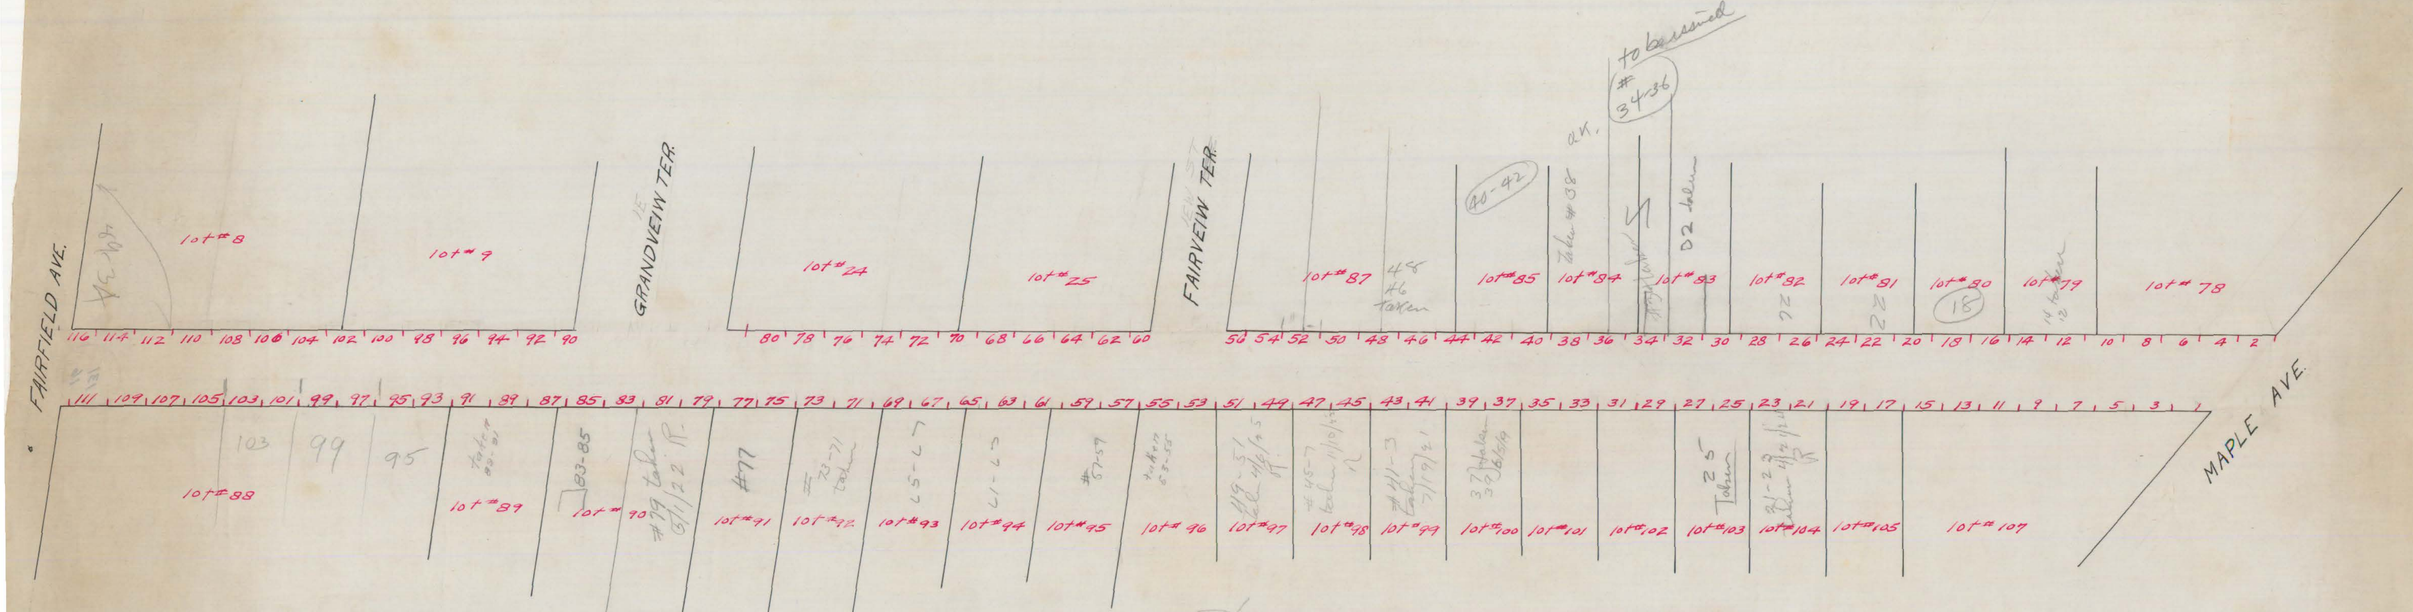

Scale 1 inch = 50 feet

Numbers 25' apart

OFFICE OF CITY ENGINEER
HARTFORD, CONN.
Date Sept. 1912
Name R.N. Clark
03043