Form 6 A No. 14278.

BERLIN CONSTRUCTION COMPANY

SHEET No. 11 of ..... SHEETS.

BILL OF MATERIAL

ORDER No. 2946 October 25 1911

REV 11-1-11

ITEM	No. Pcs.	DESCRIPTION	LENGTH Ft.	LENGTH In.	SHIPMENTS
44	16	Cast Iron Railing Posts, per sketch.			

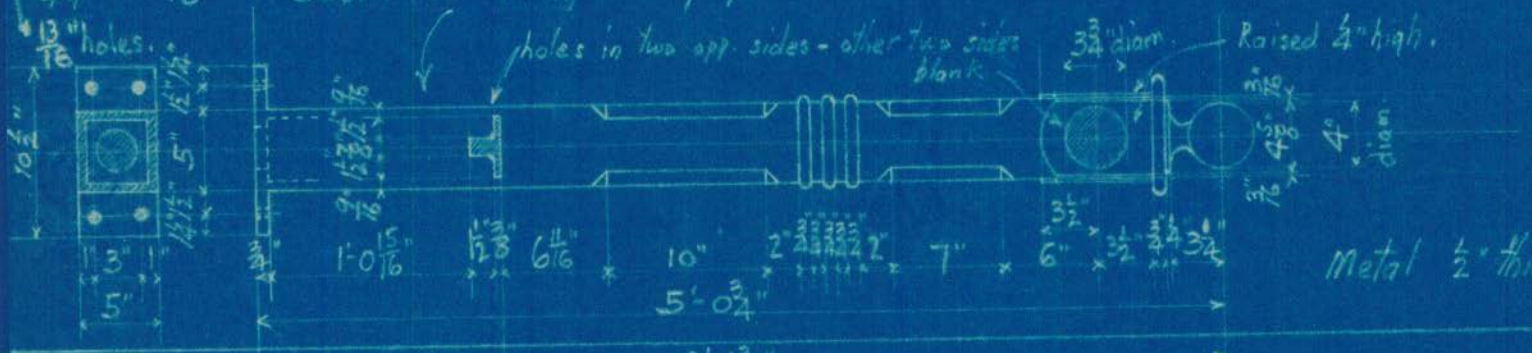

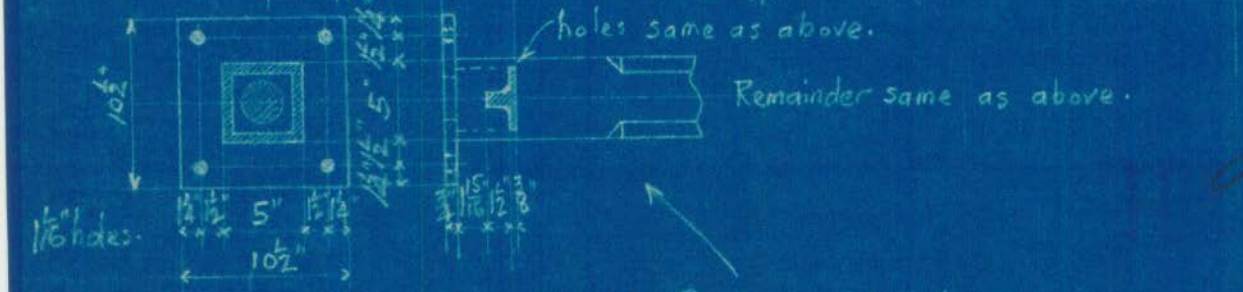

Shipment to Berlin Nov 7 1911

45 1 Cast Iron Railing Post, per sketch

Ship Direct.

(REVISED 11-1-11 Holes in base of Item No 44)