
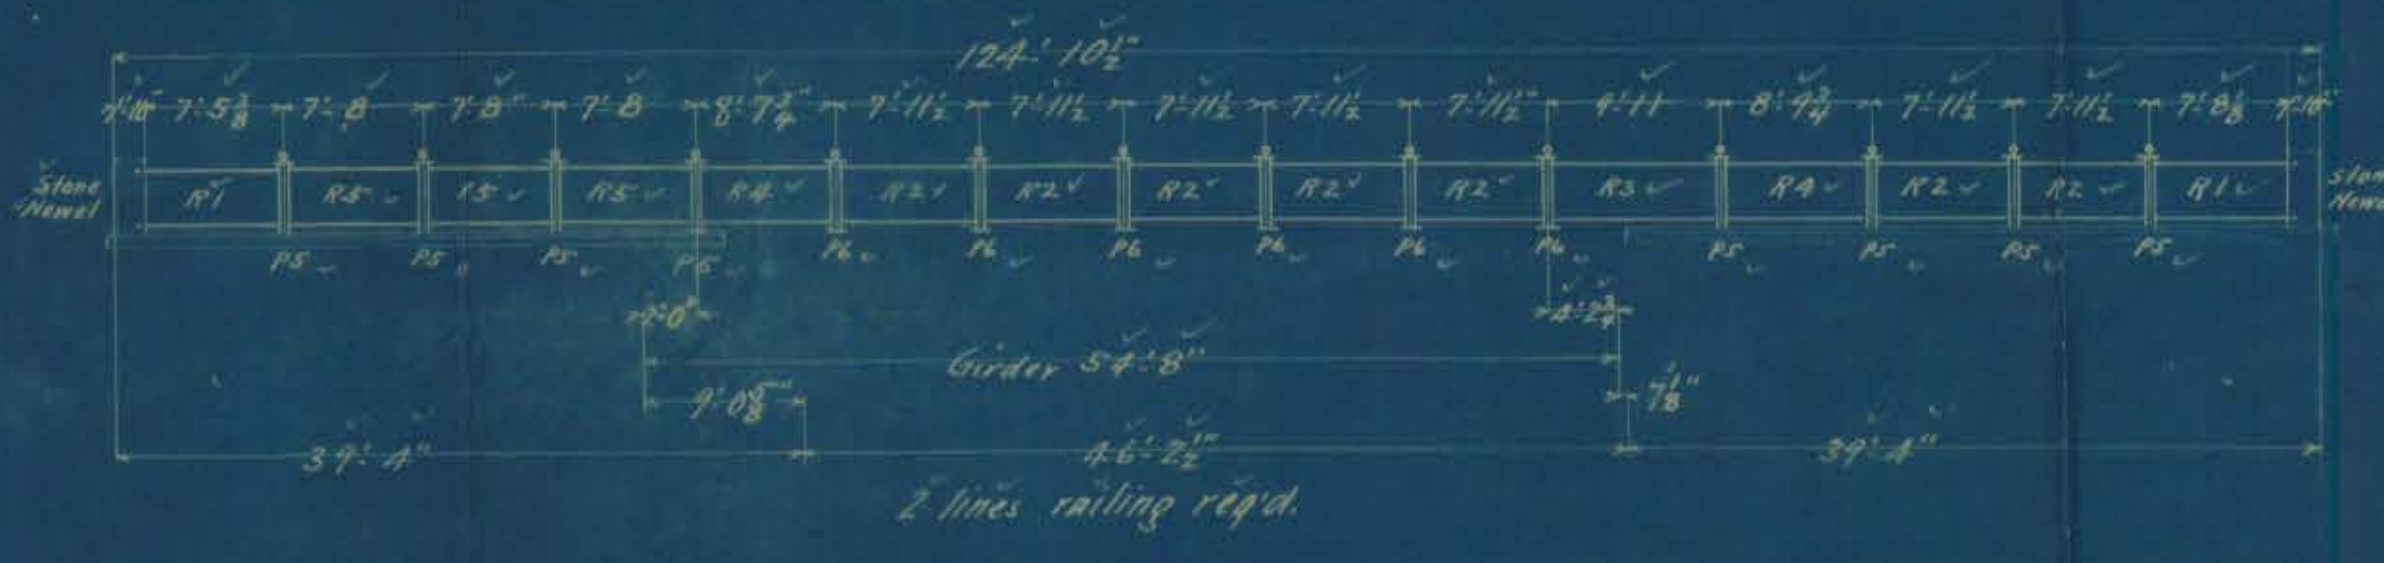
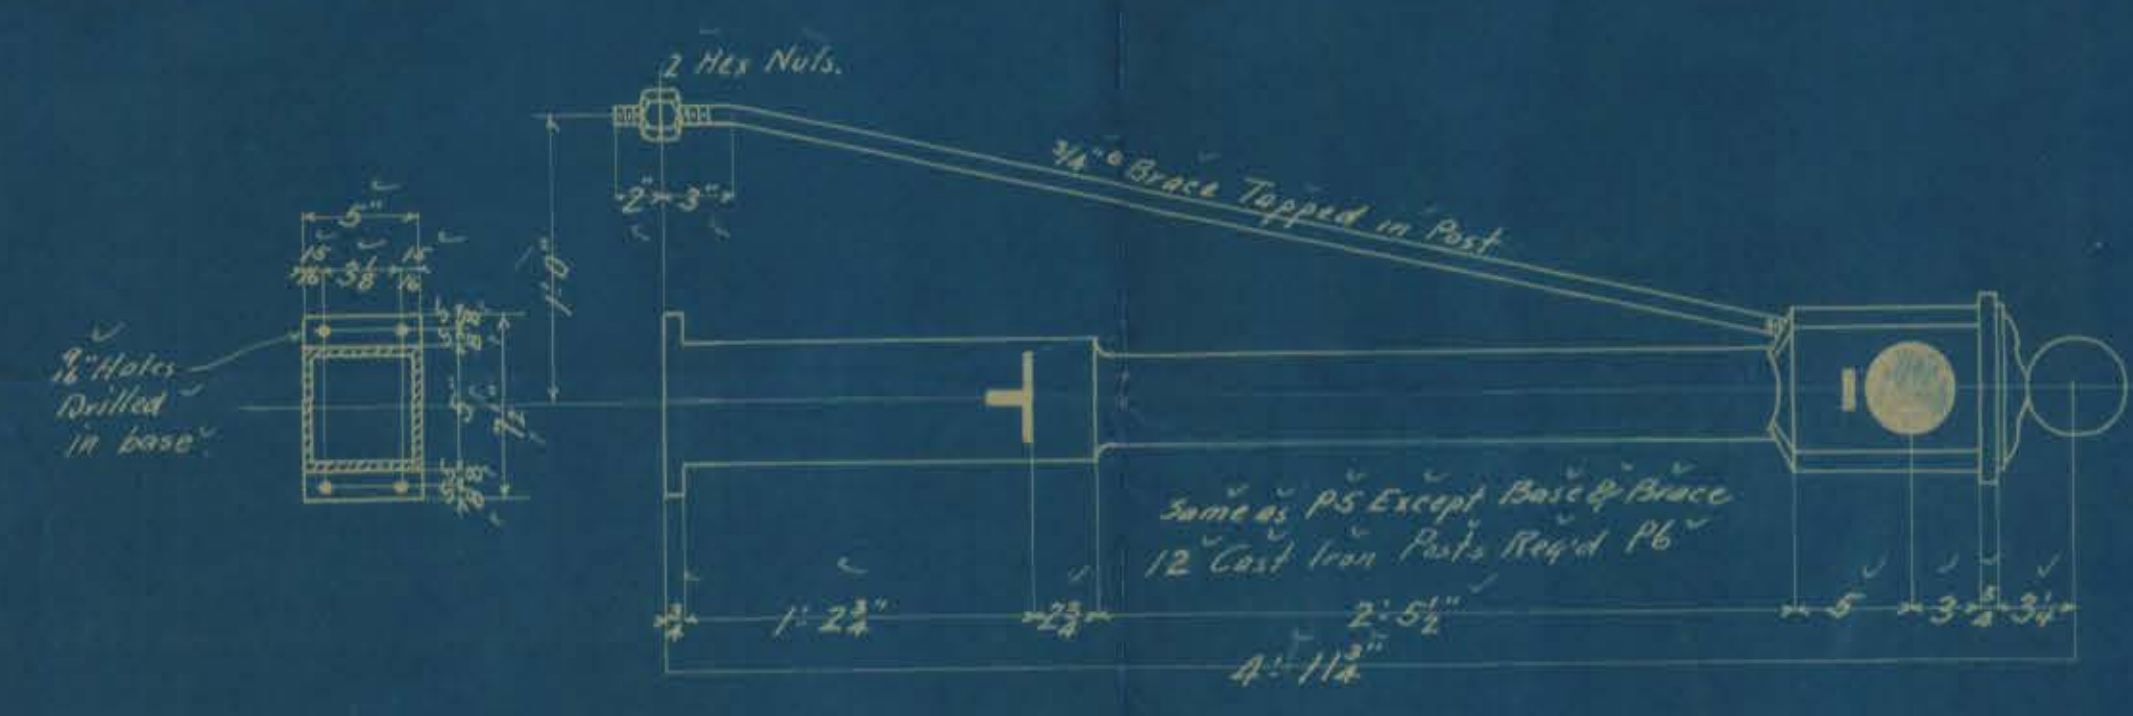
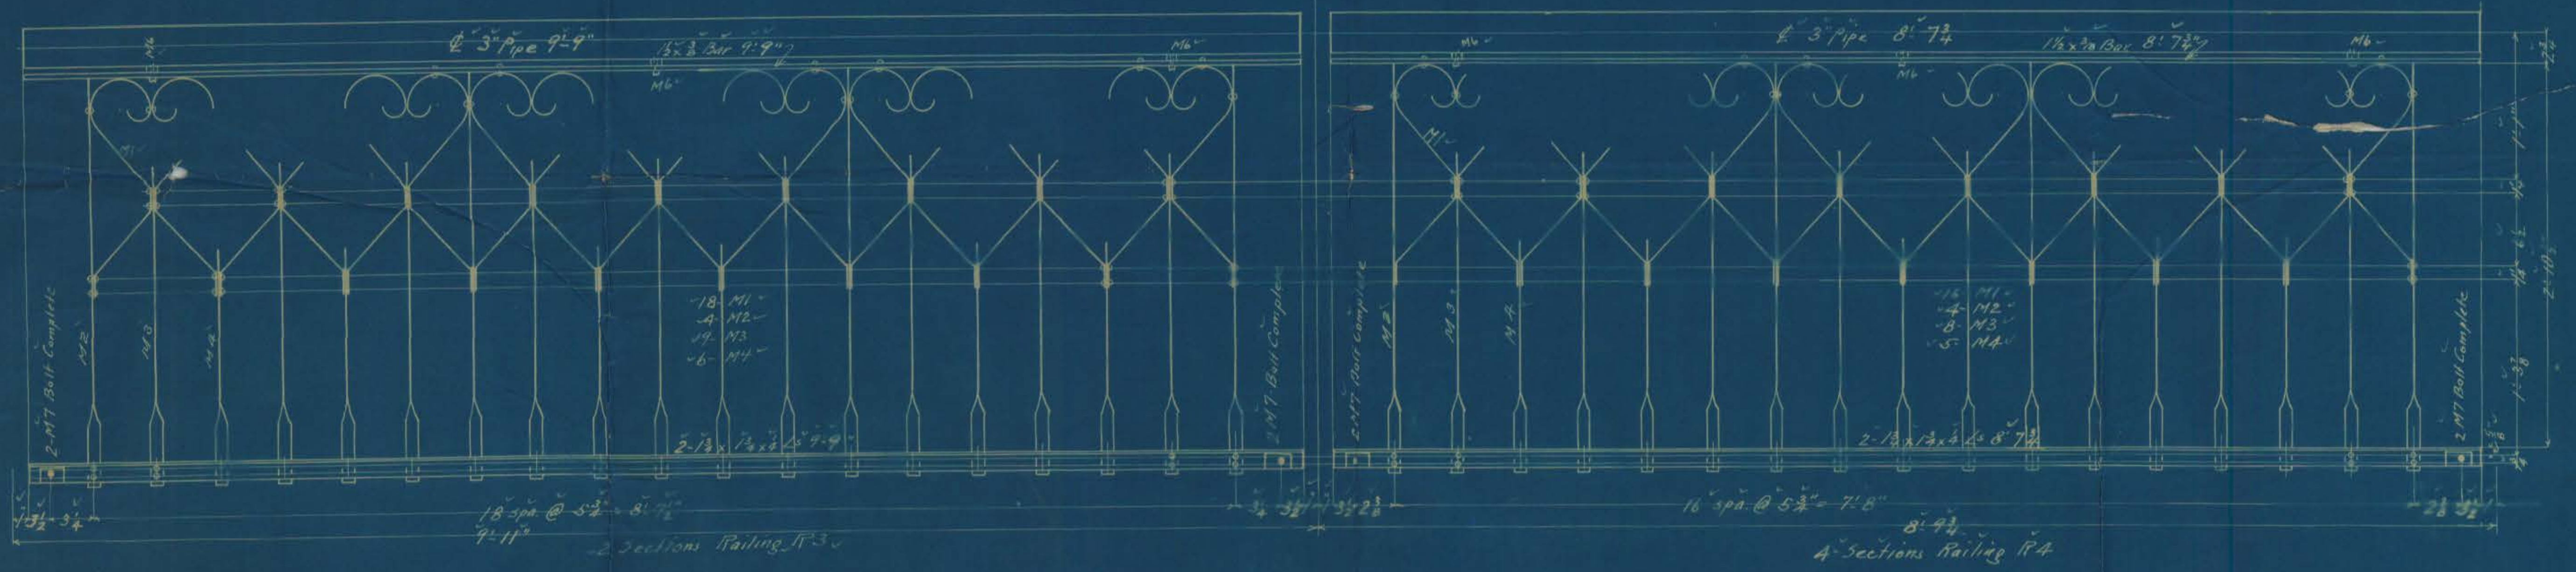


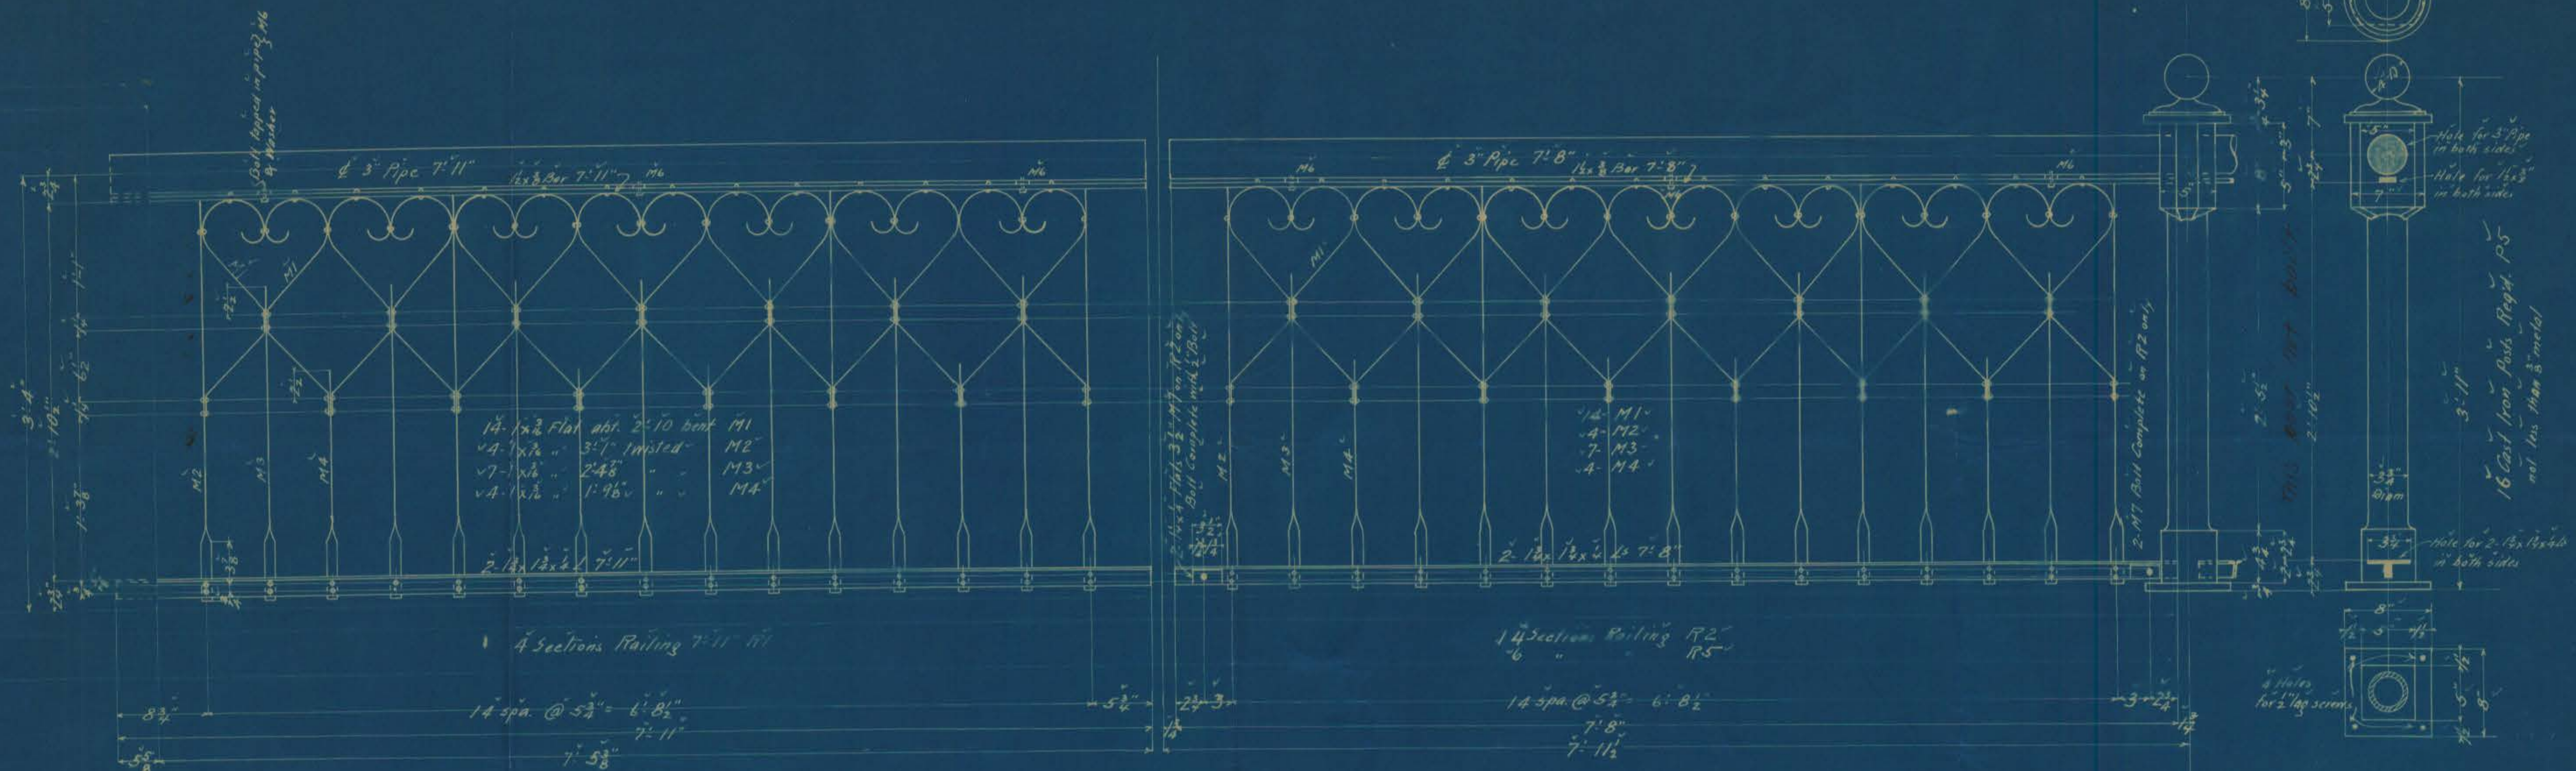

FOR APPROVAL
 RAILING
 HIGHWAY BRIDGE AT ALBANY AVENUE
 OVER TRACKS OF
 CENTRAL NEW ENGLAND RAILROAD CO.
 HARTFORD CONN.
 BERLIN CONSTRUCTION COMPANY.
 CONTRACT No 1092
 DRAWN BY G.G. DATE 28 Aug '05
 CHECKED BY J.W. Sweeney DATE August 22 '05
 SCALE
 SHEET No. 5 OF SHEETS.

All Rivets 3/8"
 All Bolts 1/2"
 Paint 1 Coat Detroit Graphite Co's
 Superior Graphite Paint 2-501 in shop.