


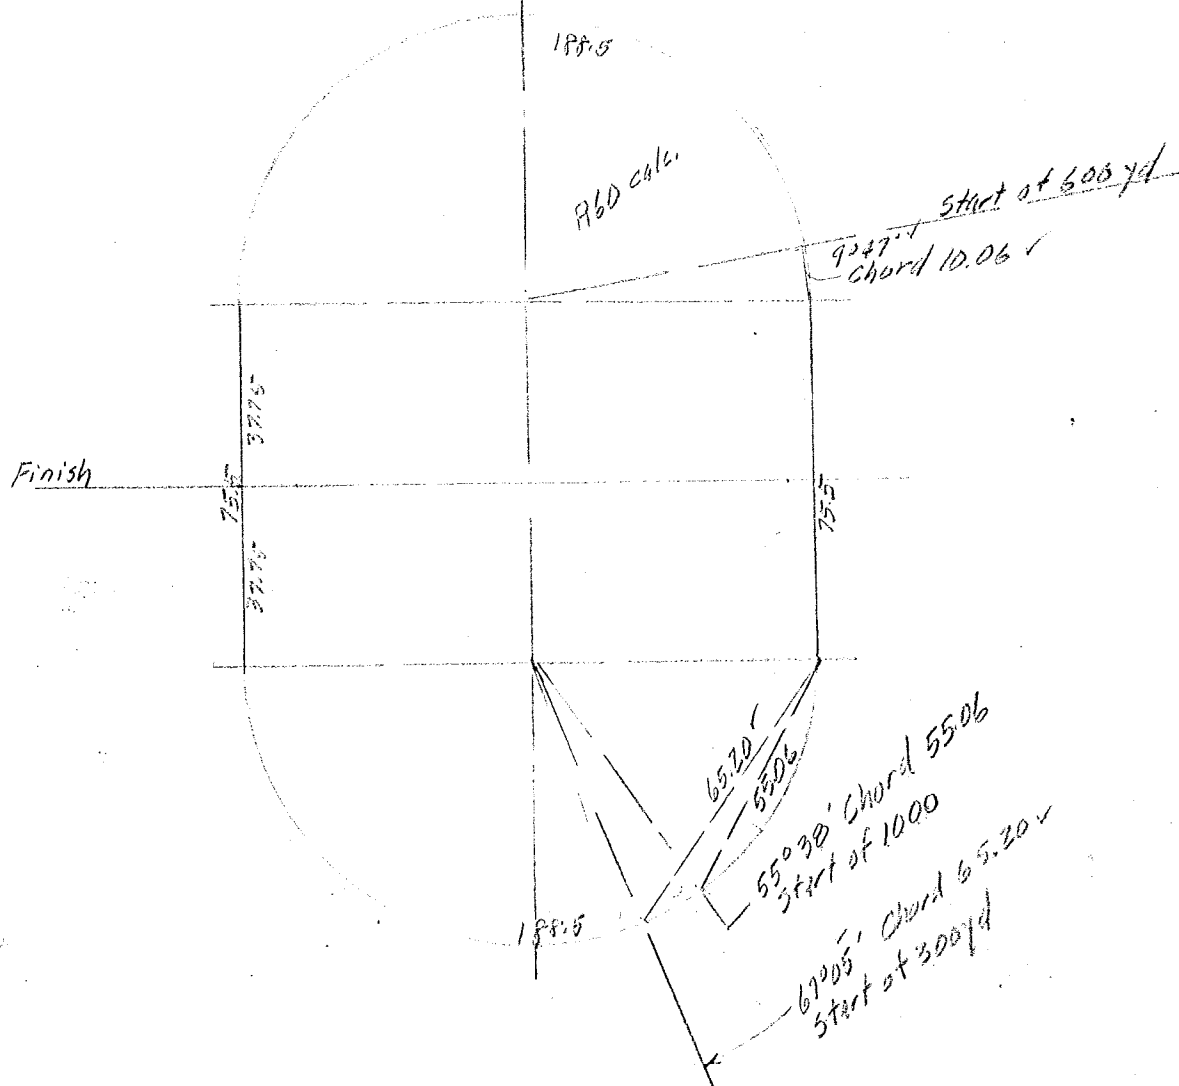

300 yd. = 1 lap plus distance to finish line

600 yd. = 3 laps " " " "

1000 yd. = 5 laps " " " "

STATE ARMORY TRACK