

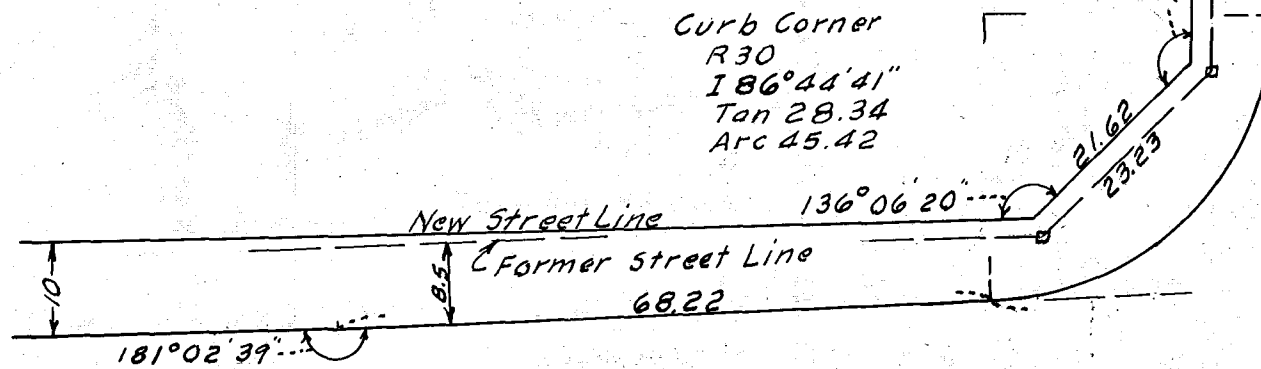


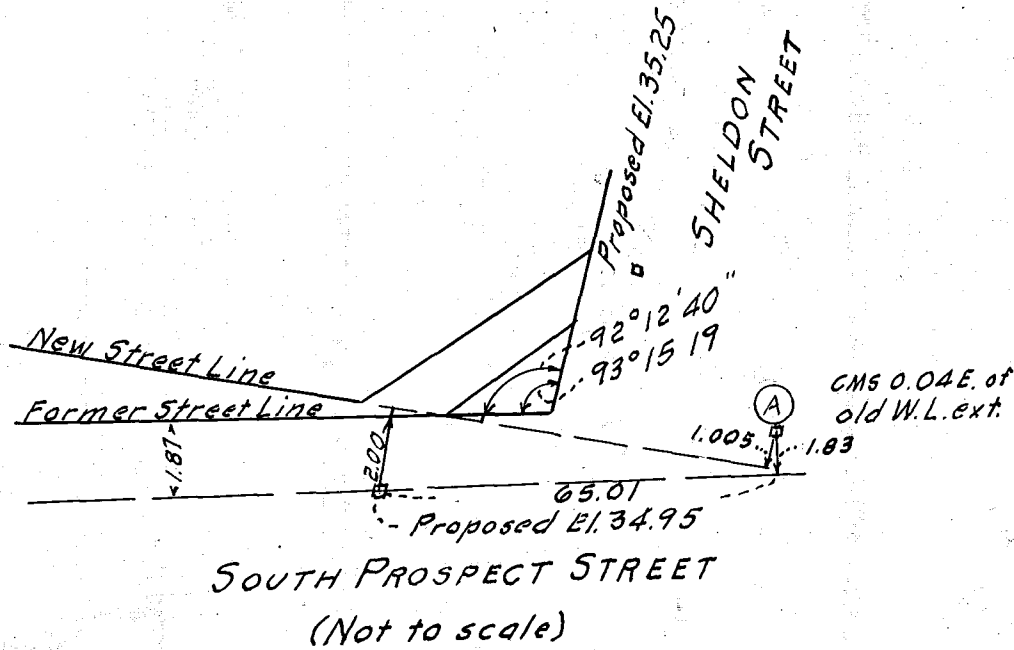

SOUTH PROSPECT STREET

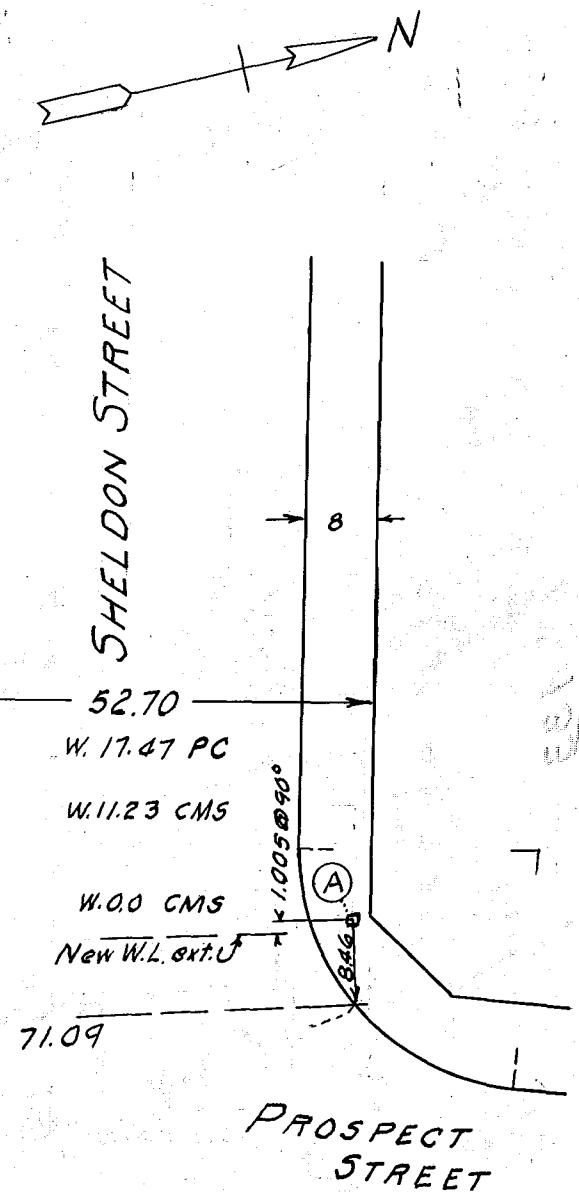

CITY OF HARTFORD

DEPARTMENT OF ENGINEERING

SCALE 1" = 20' NOVEMBER 1962

DAYBOOK No. 09741