




1892.

Ties - in No 308
p 74

CHARTER OAK AVE

BUCKINGHAM ST

CAPITOL AVE

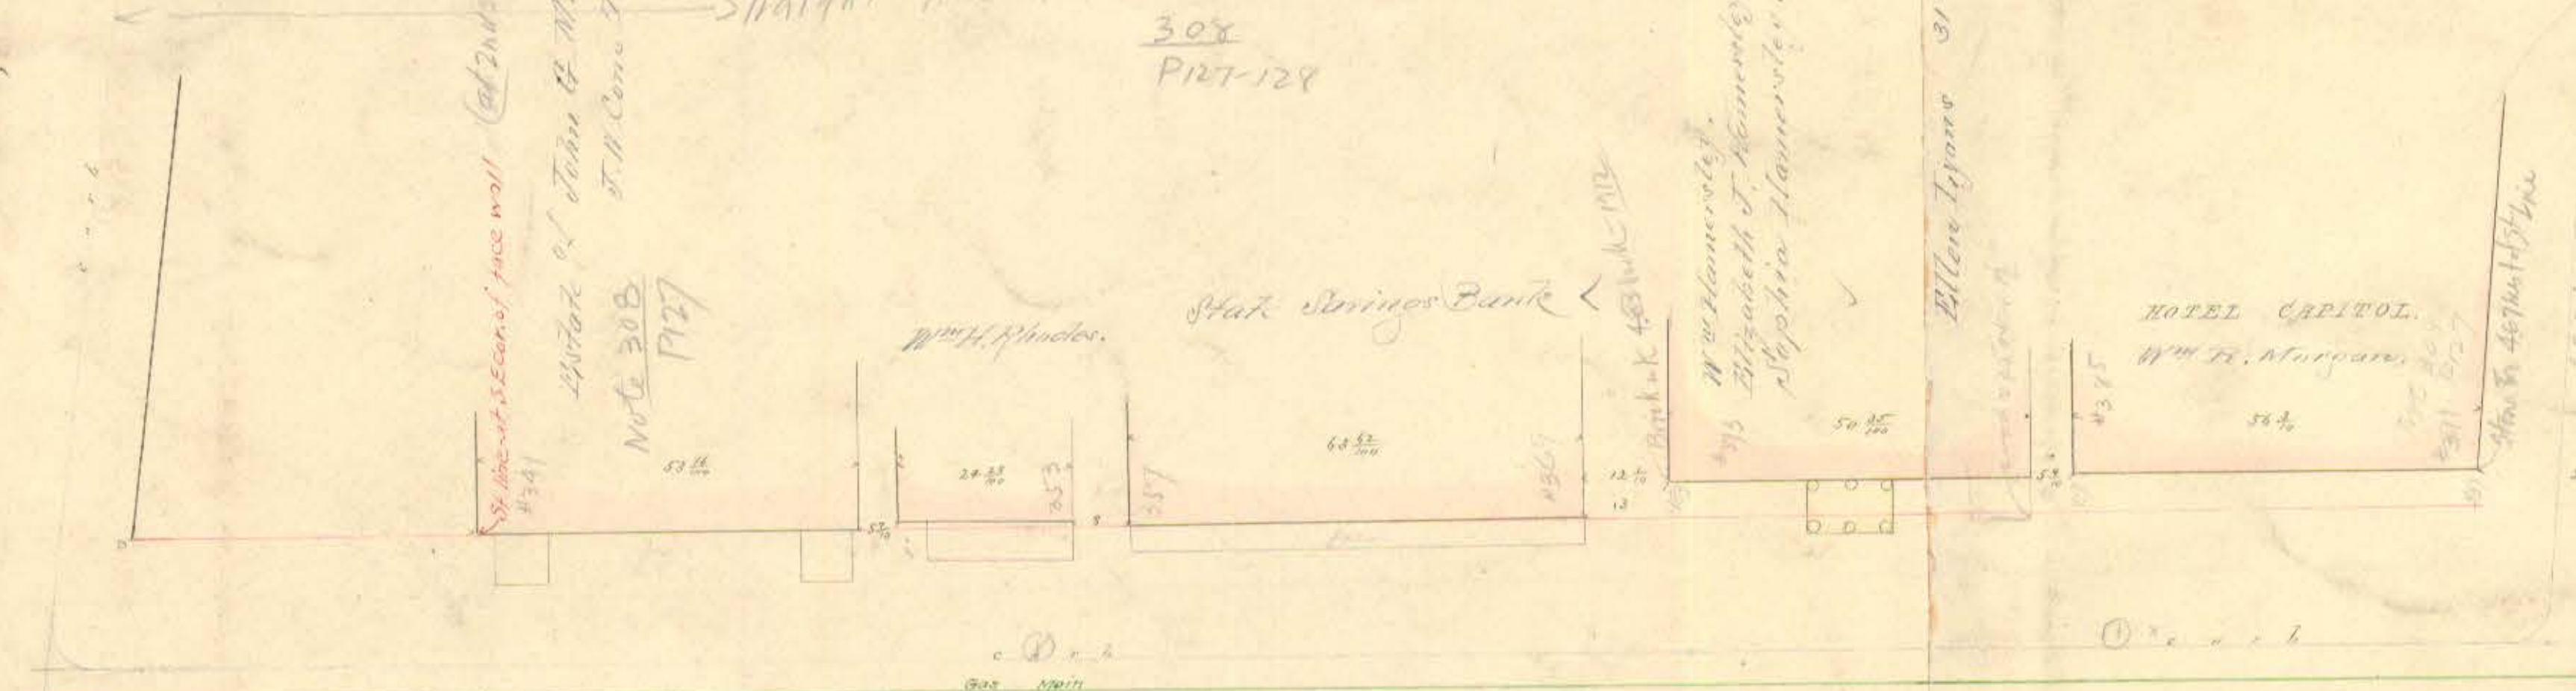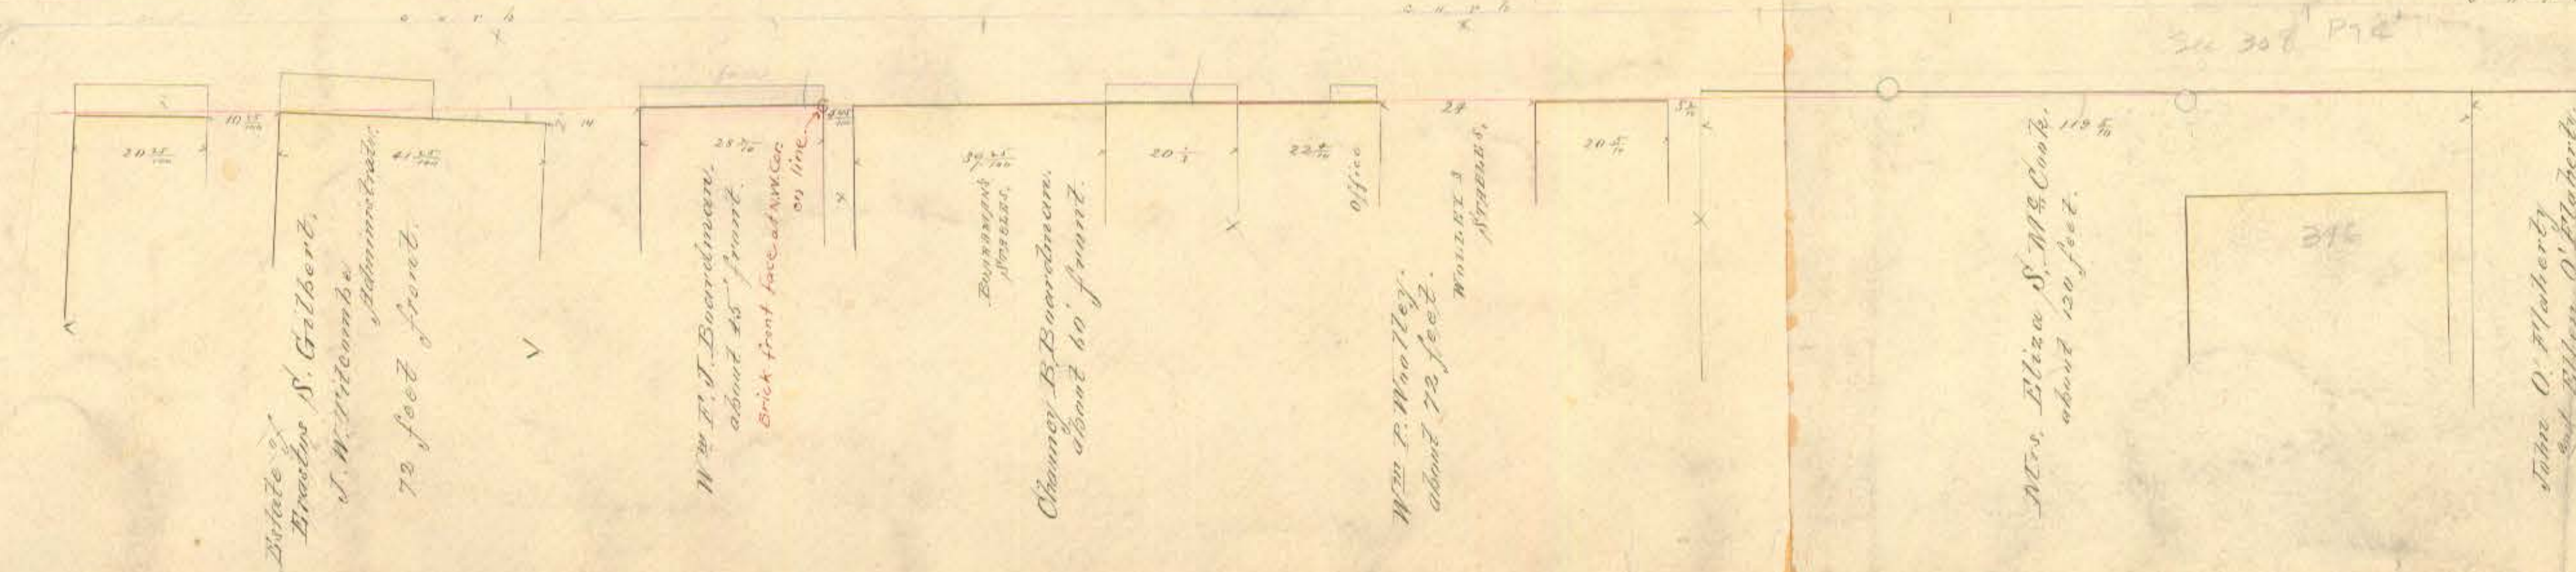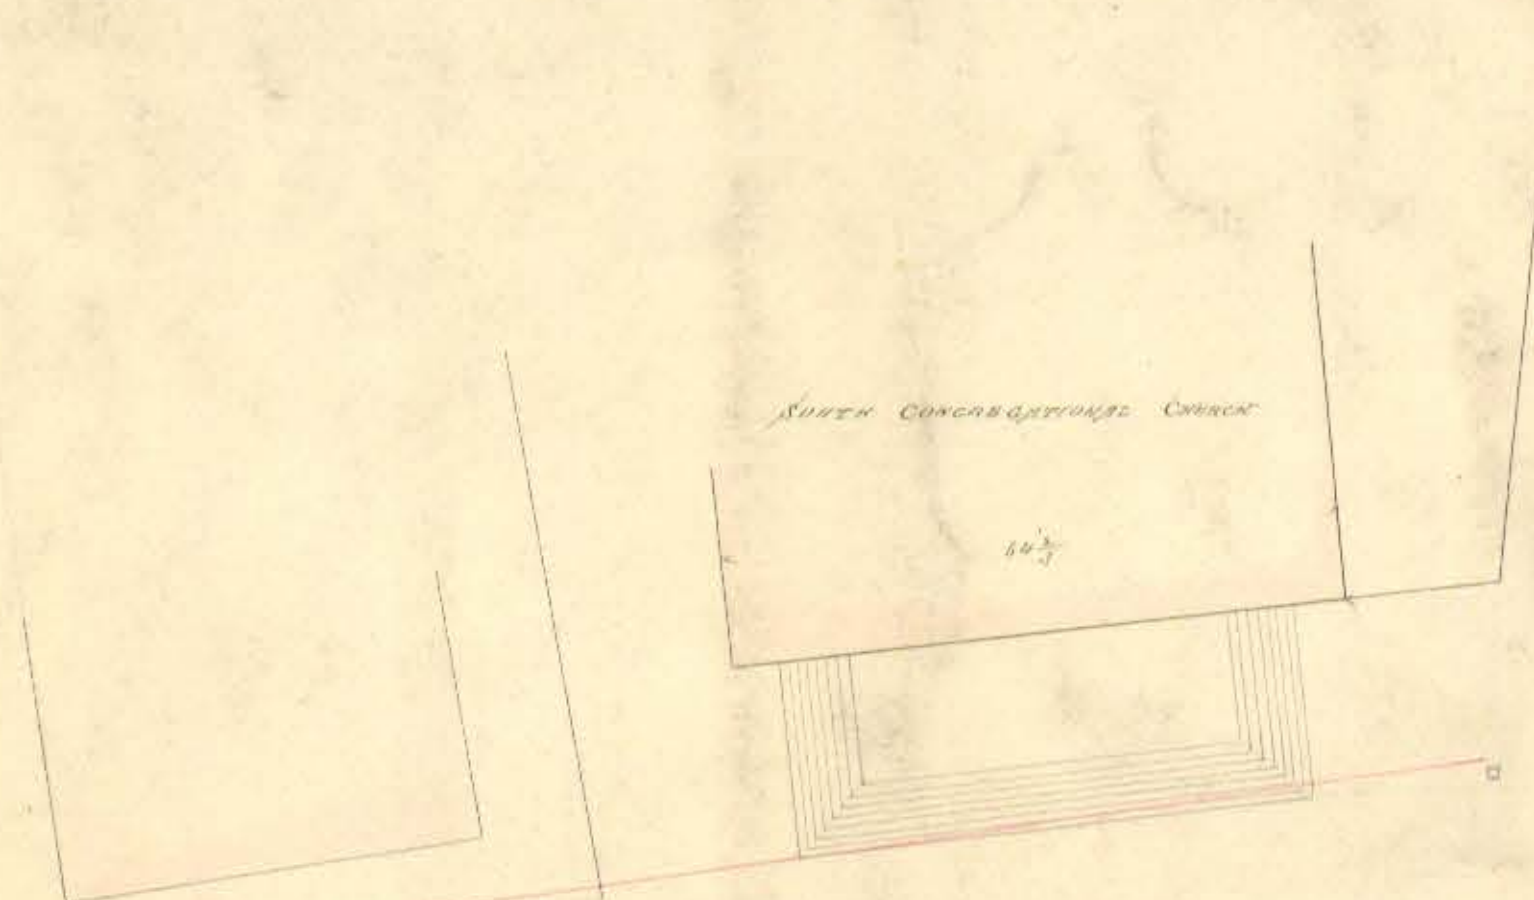

Straight line to Park River
308
P127-128

Note 308
P127

25 feet
Elizabeth J. Hamerly and
Stephen Hamerly

Ellen Lyons 31 ft

67 feet 4 inches front