


TORWOOD STREET

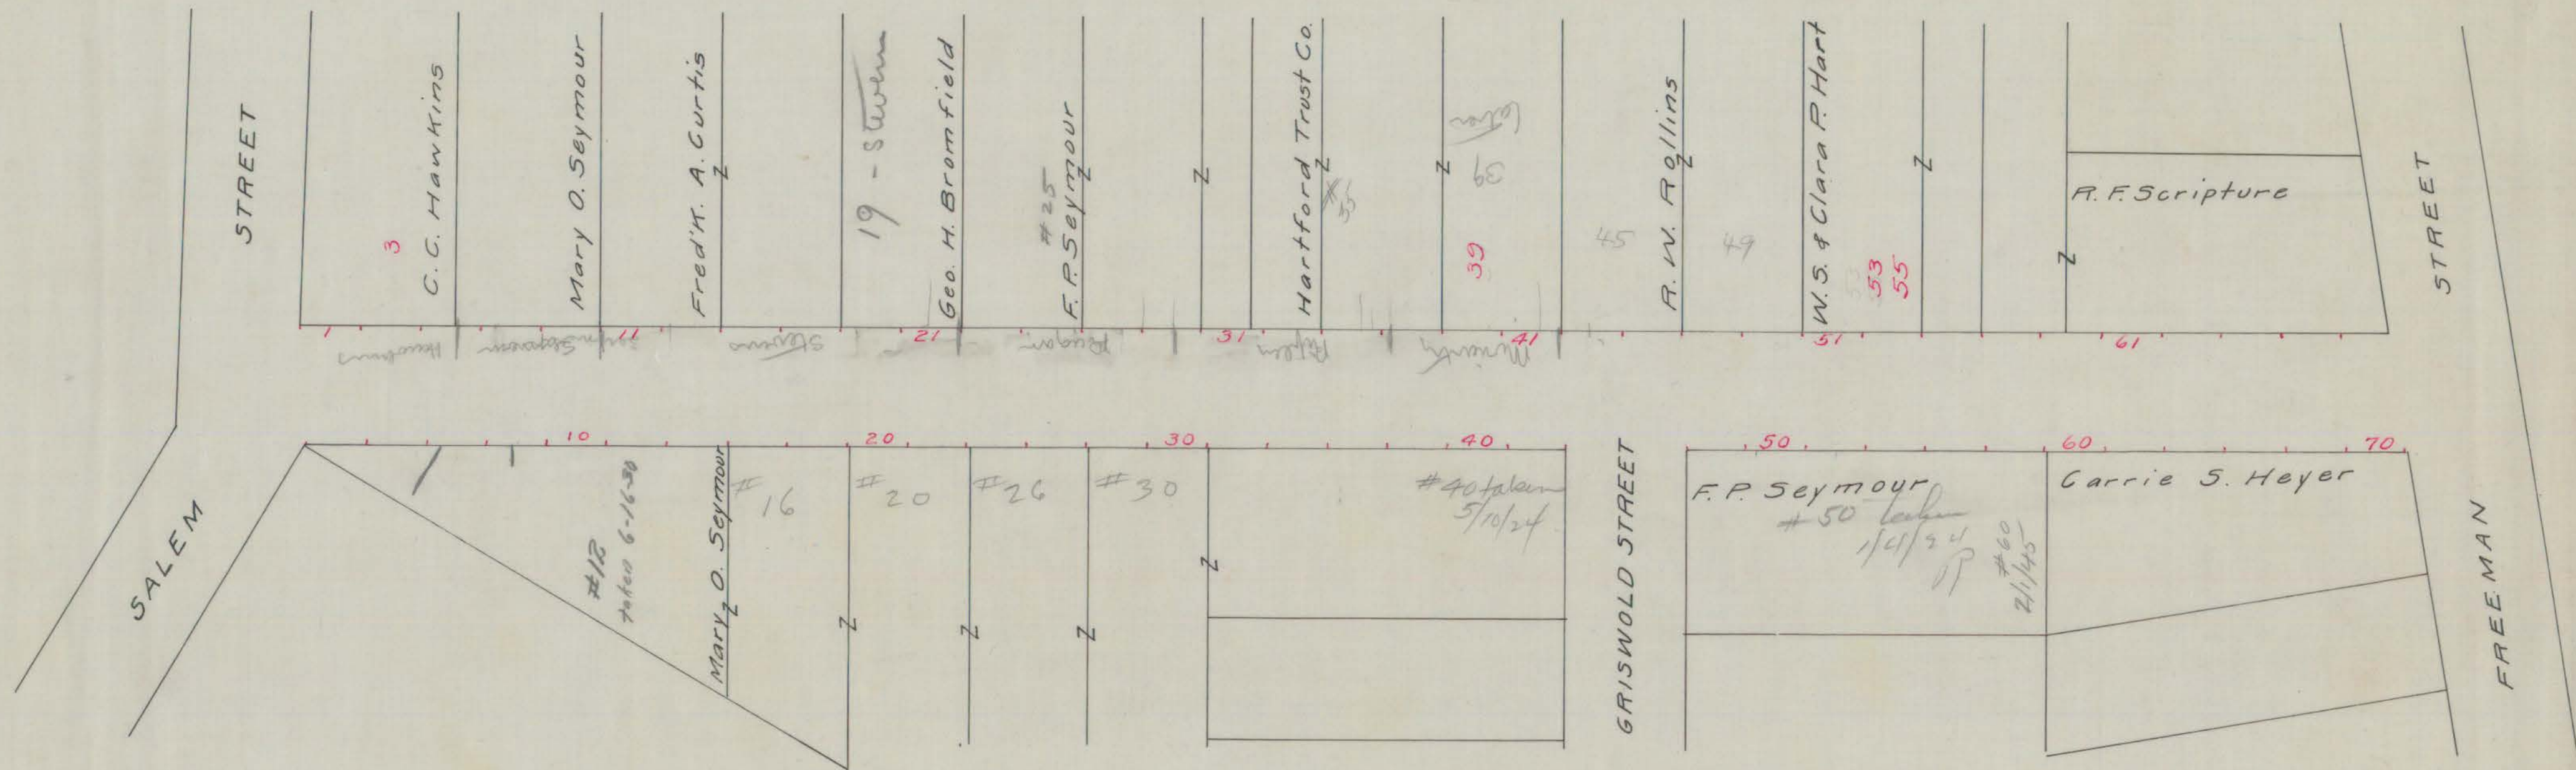

Scale 1" = 50 Numbers 25
Numbered