


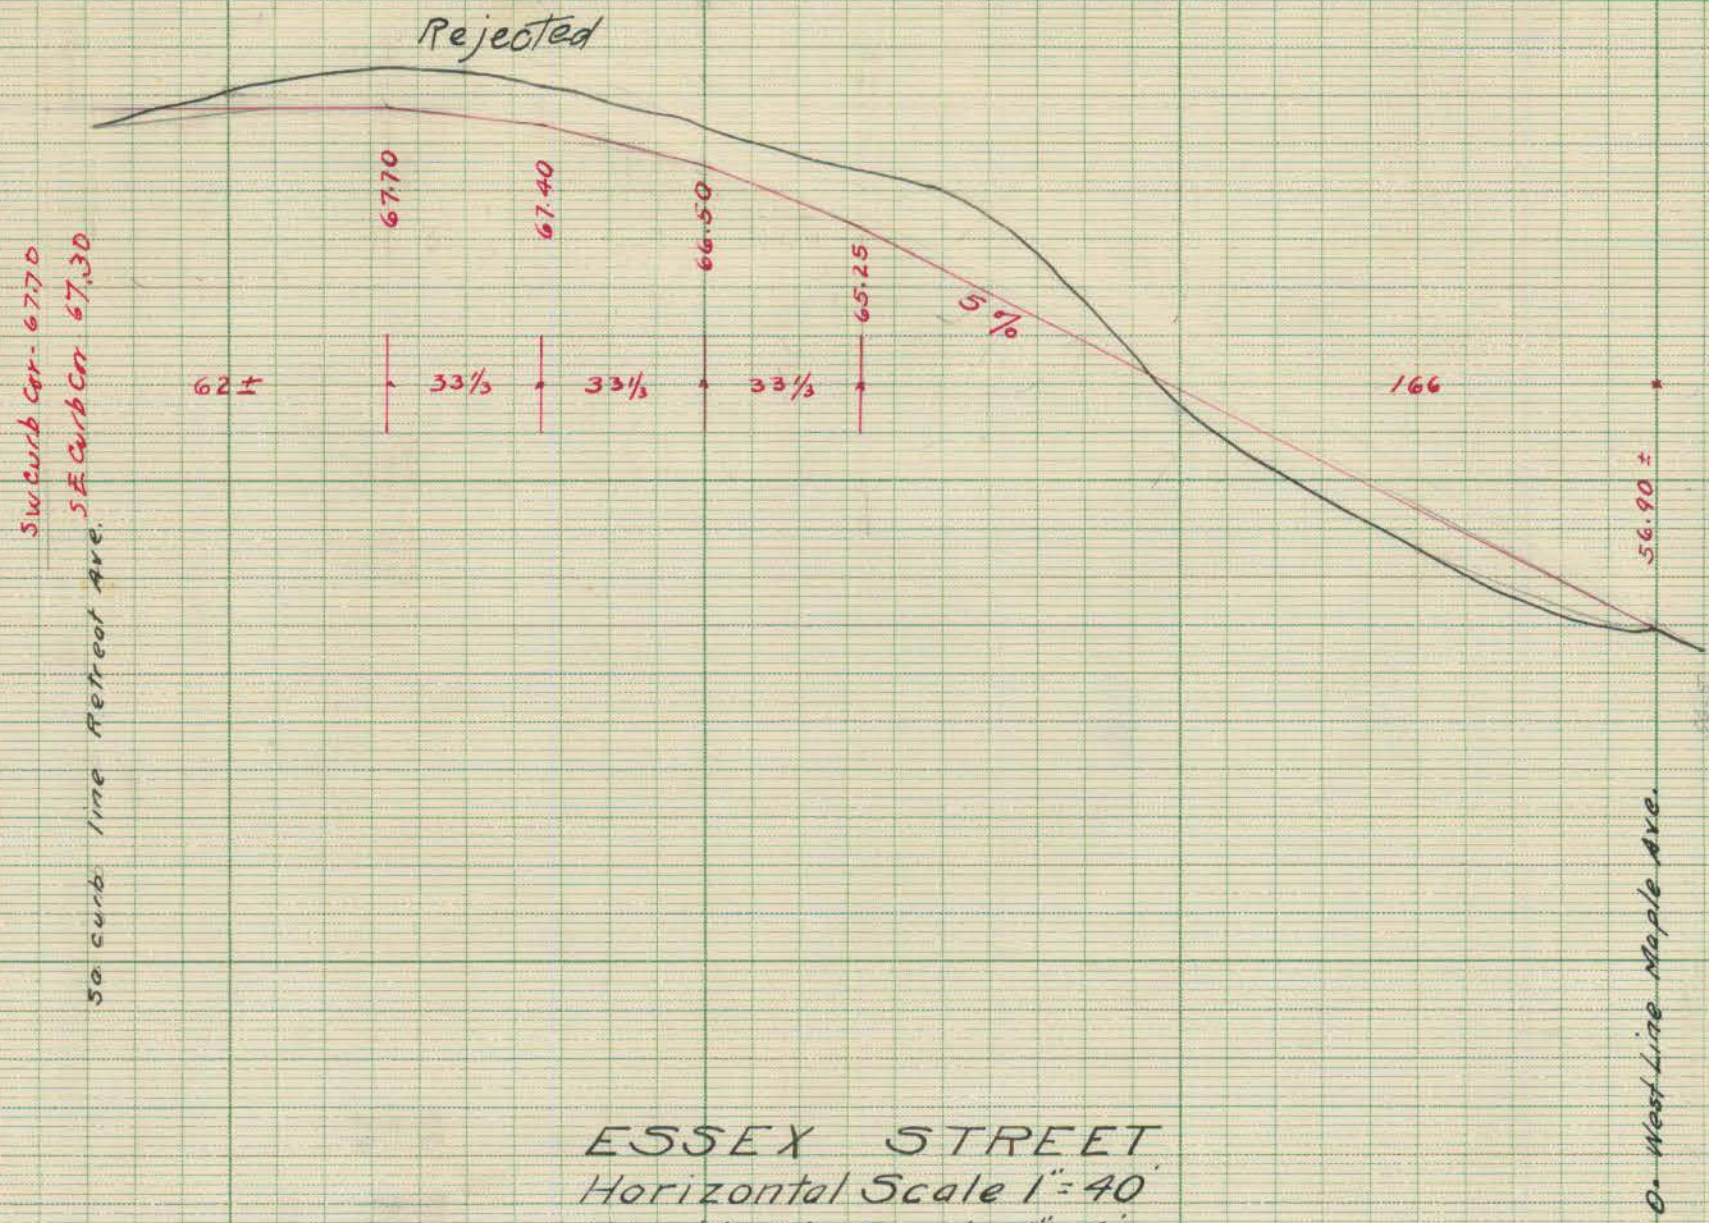

ESSEX STREET
Horizontal Scale 1" = 40'
Vertical Scale 1" = 4'

Note! See profile 02697-149 for new location of Essex St - 0/July-1911
7A

OFFICE OF CITY ENGINEER
HARTFORD, CONN.
Mar. 1910
316
02413
City Engineer

"Perfect" PROFILE CLOTH
PLATE A.