





VINE STREET

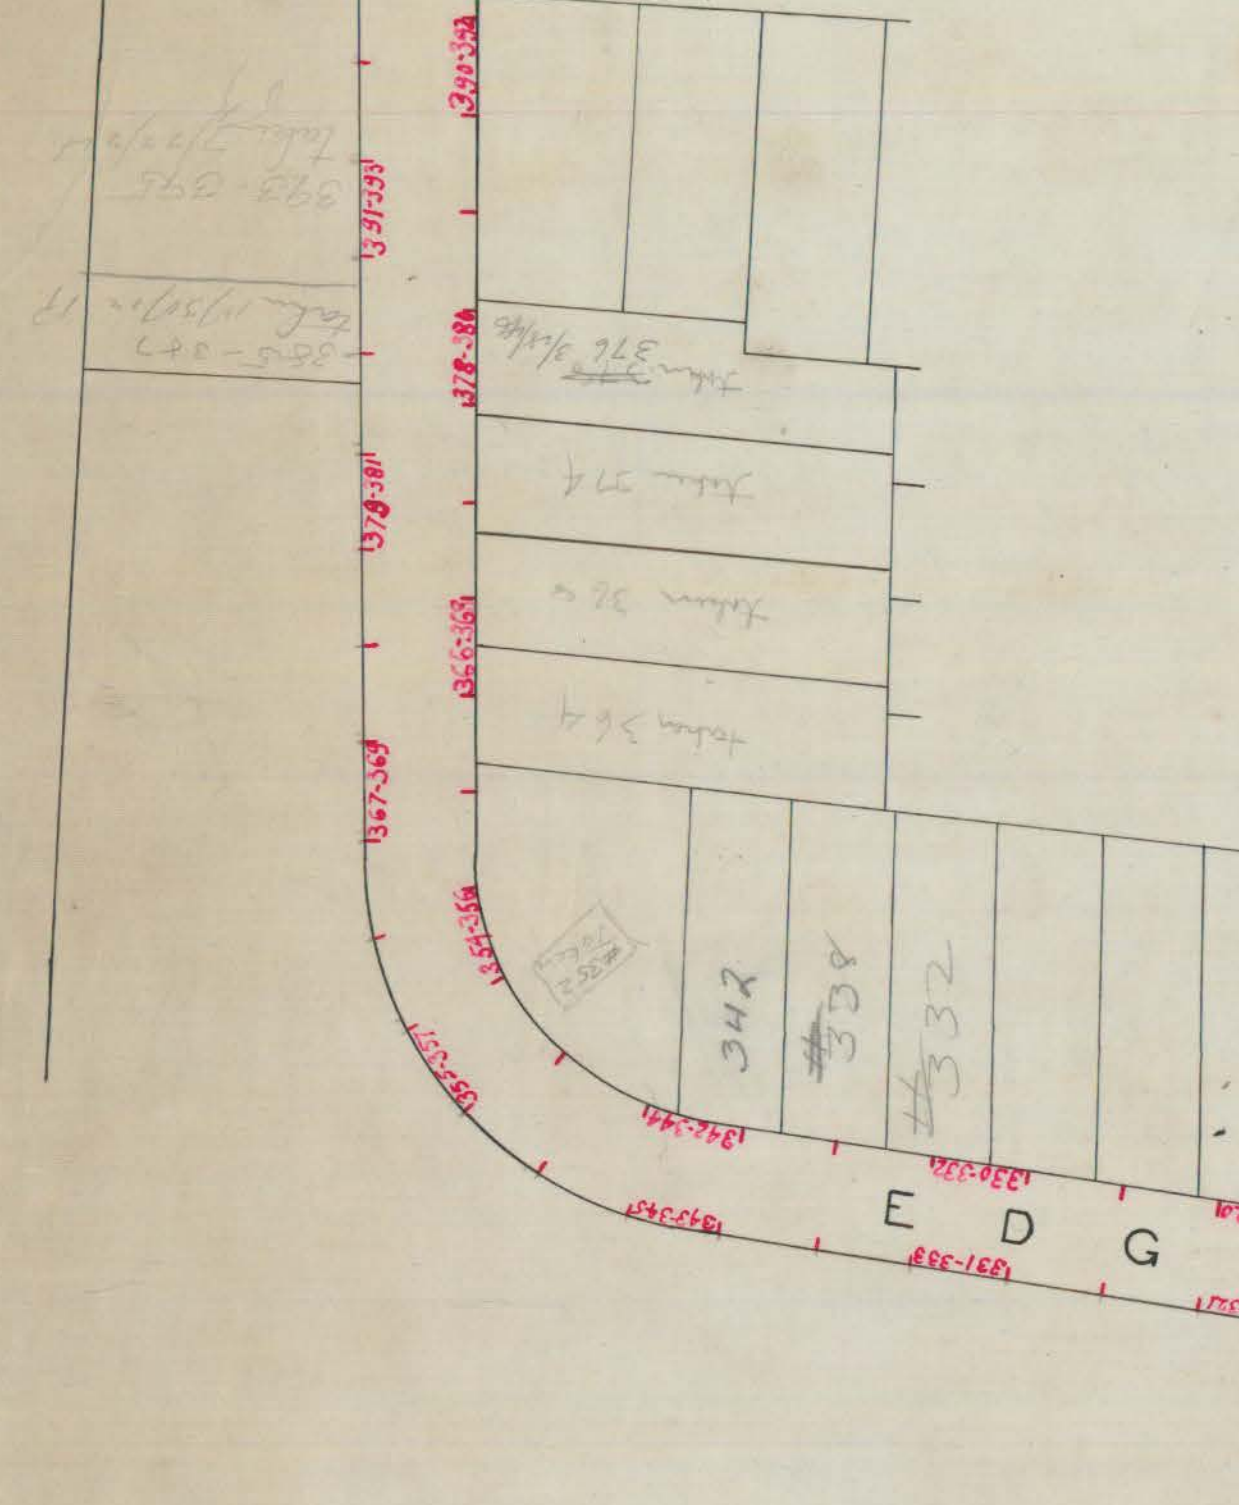


CAPEN ST.

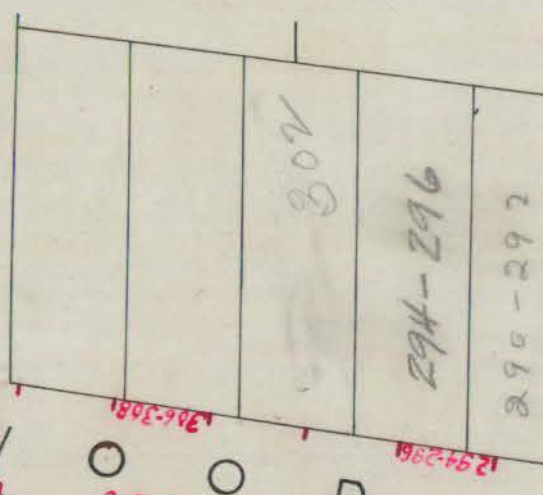




MANSFIELD ST.

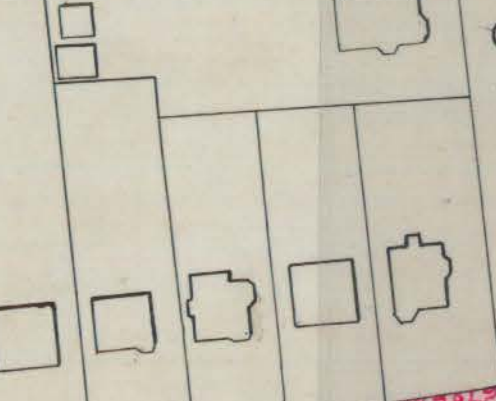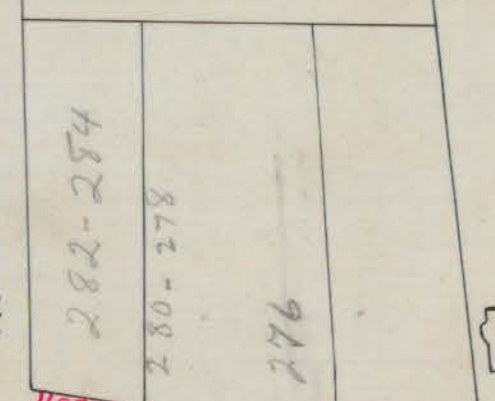


RAYMOND ST.

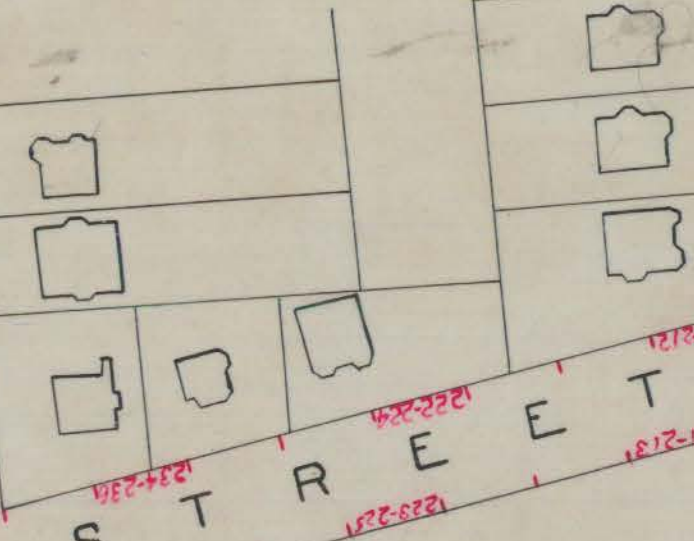

GREENFIELD STREET

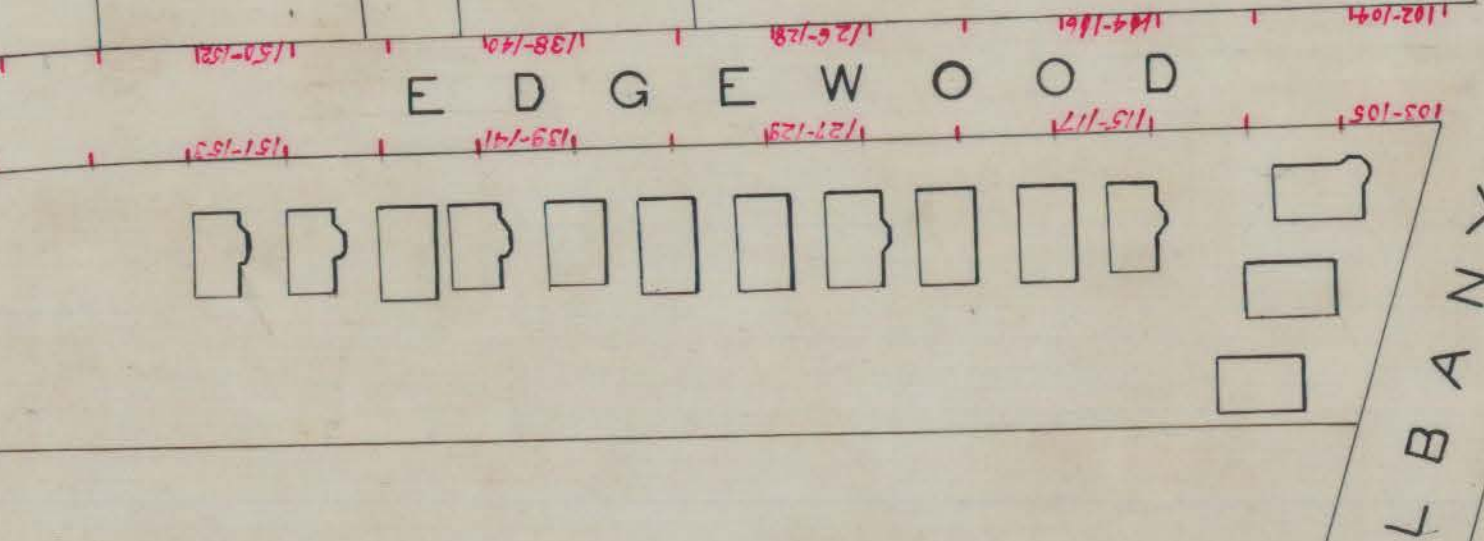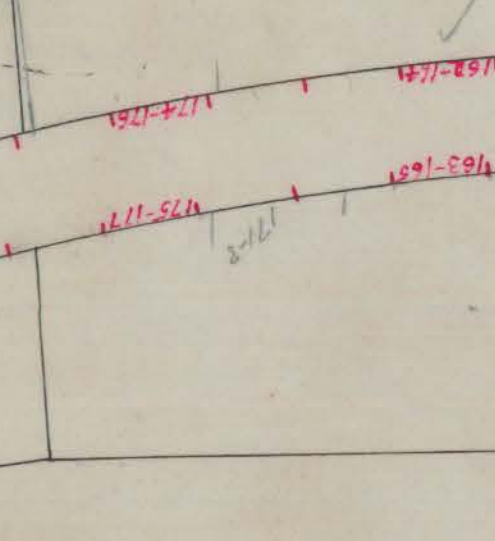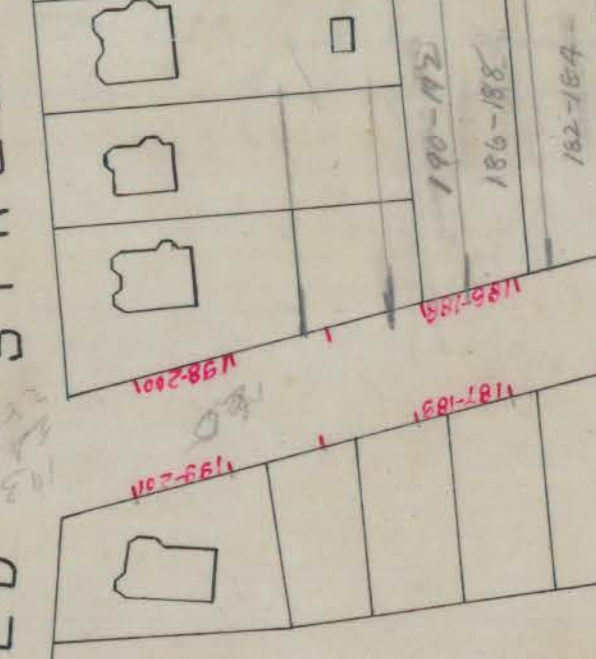

ALBANY AVENUE

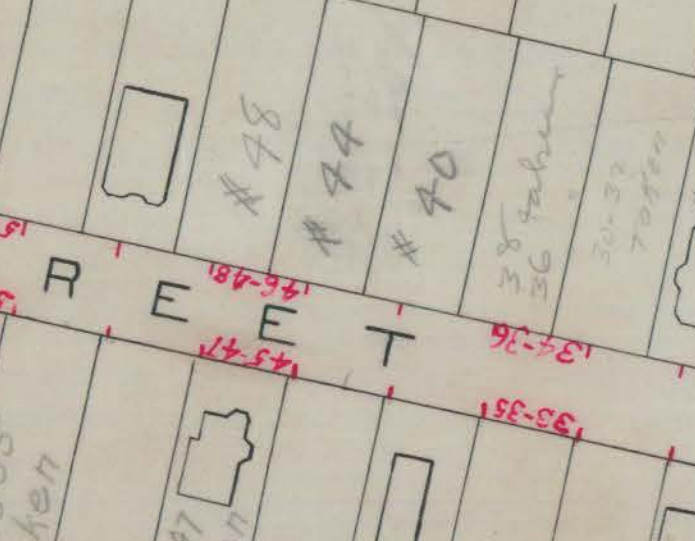

HOMESTEAD AVE.

Scale 100 Feet to an Inch.

Feb. '10.

02402