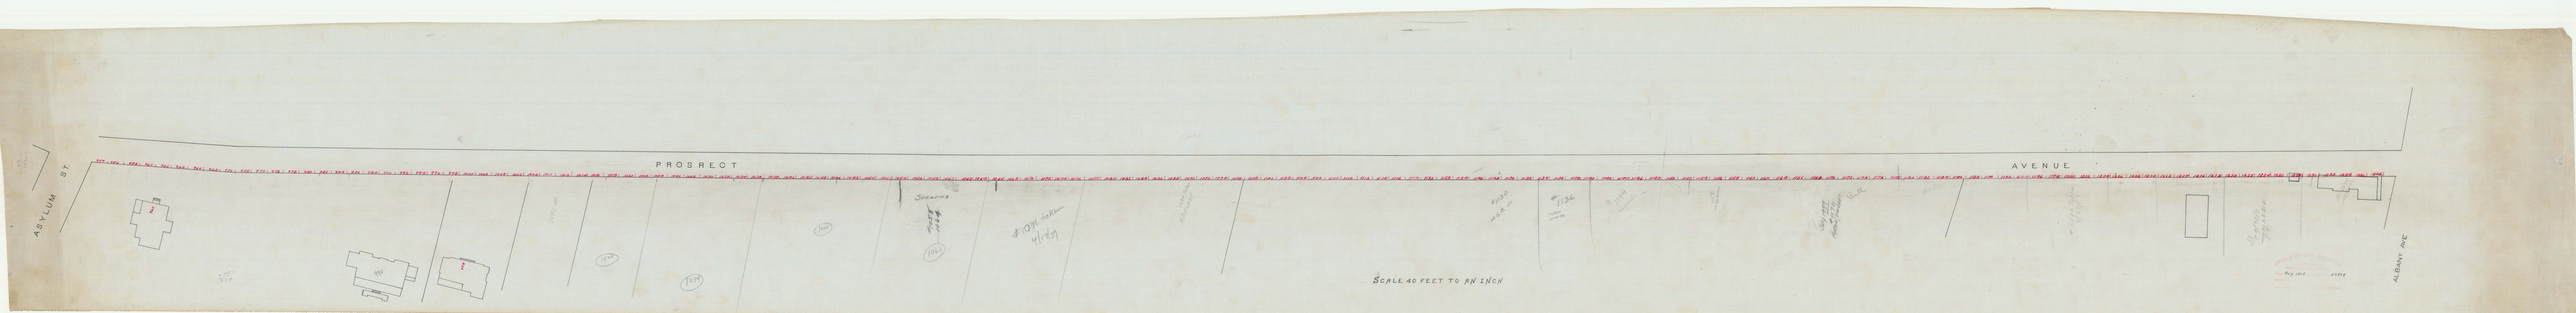
ASYLUM ST.
PROSPECT
AVENUE
ALBANY AVE.
SCALE 40 FEET TO AN INCH