


02672


336 - 49

R.N.C.

Vol 5 p306

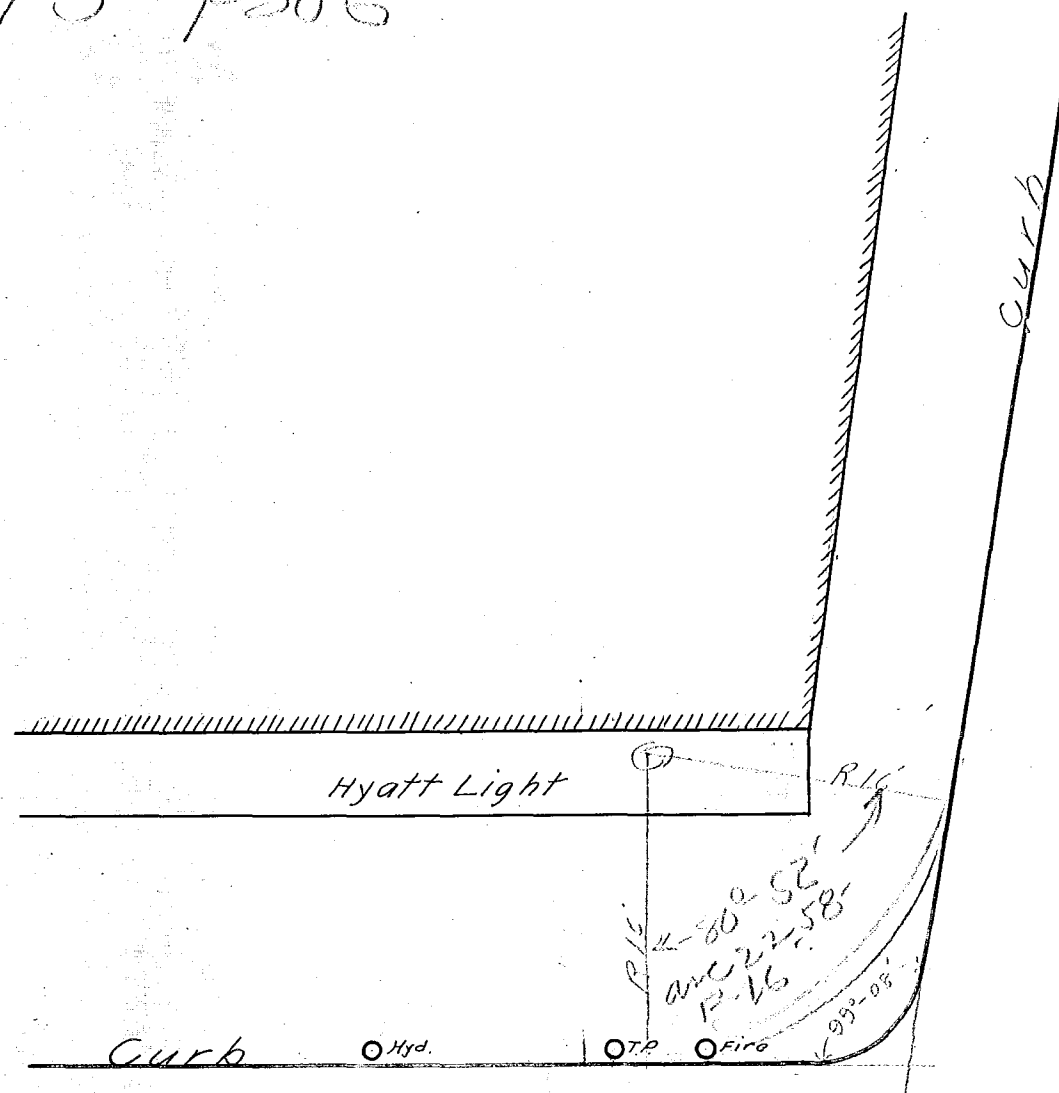


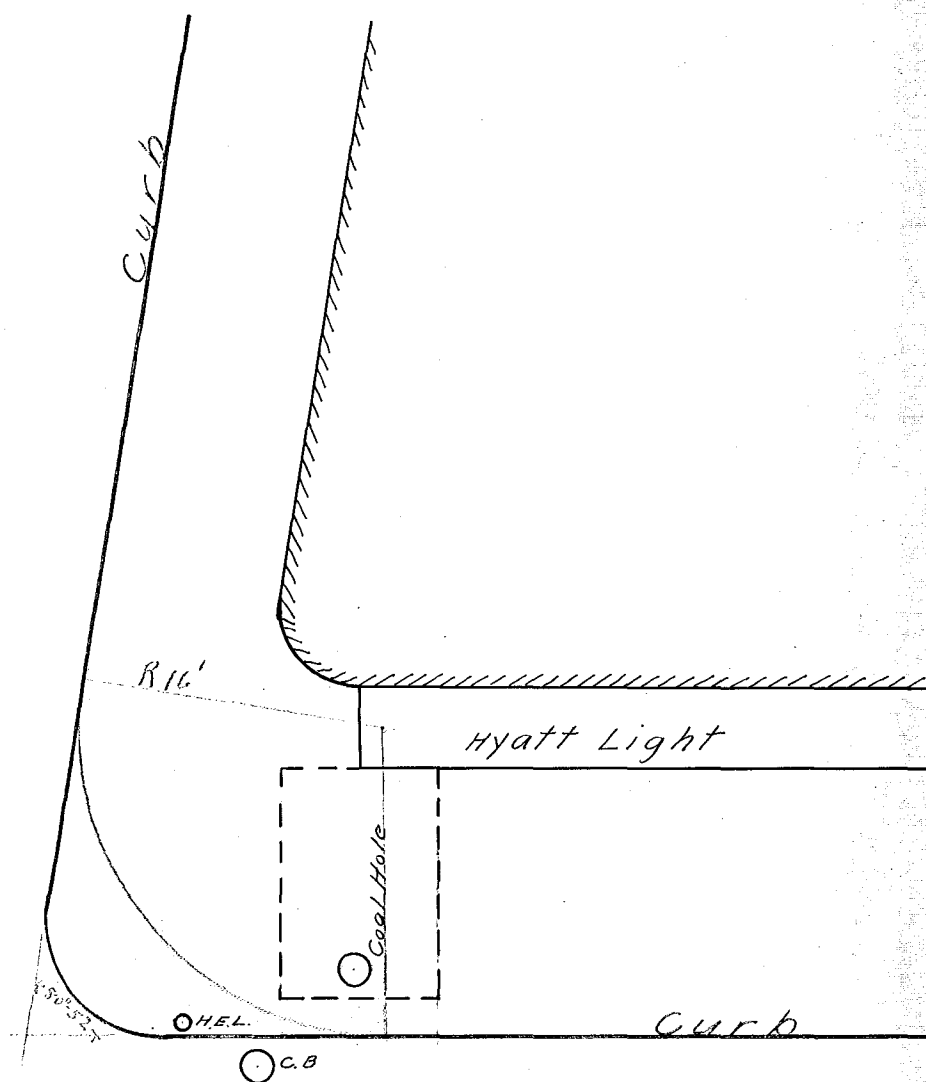

MAIN ST.