PROFILE OF FRONT STREET

STATE STREET TO MORGAN STREET
SHOWING CURBS, DOORS & WINDOWS
HORIZONTAL SCALE 1" = 20'
VERTICAL SCALE 1" = 2'. FEB 1913
Note - West Side Shown in Black, East in Green.
Stations Measured on East Curb
Note Book #364
New Grade in Red

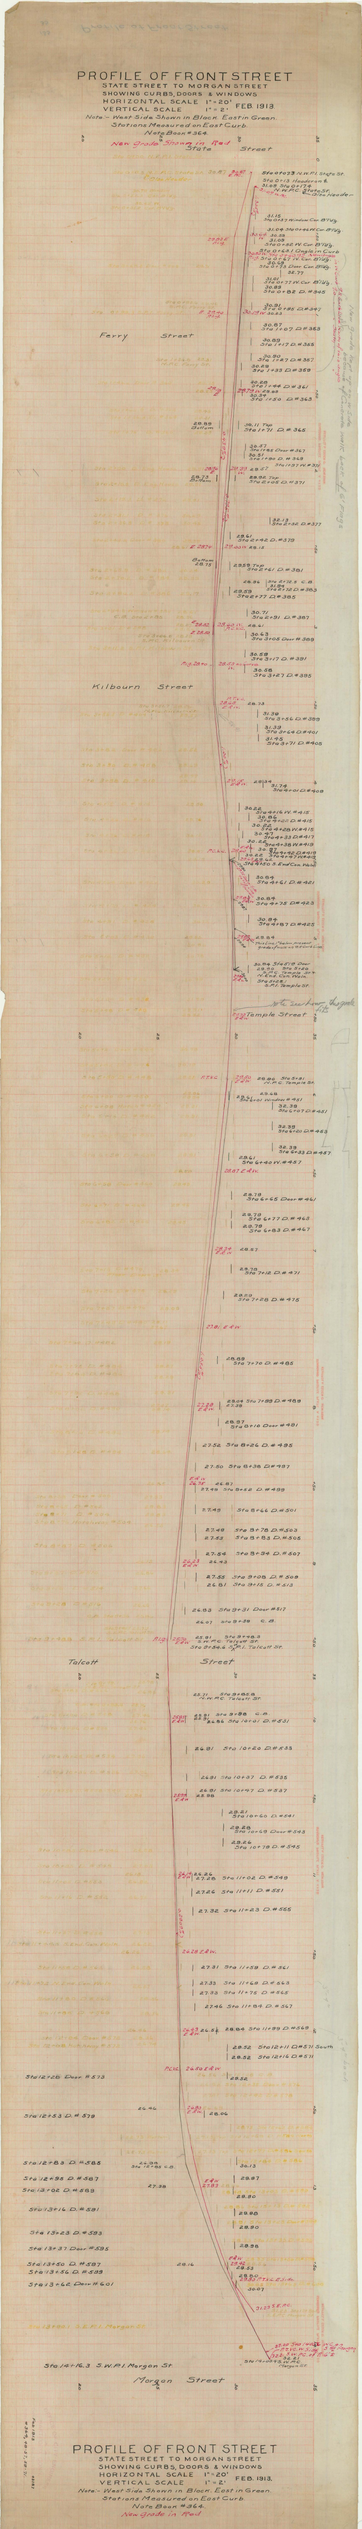

PROFILE OF FRONT STREET
STATE STREET TO MORGAN STREET
SHOWING CURBS, DOORS & WINDOWS
HORIZONTAL SCALE 1" = 20'
VERTICAL SCALE 1" = 2'. FEB 1913.
Note - West Side Shown in Black, East in Green.
Stations Measured on East Curb
Note Book #364.
New Grade in Red