


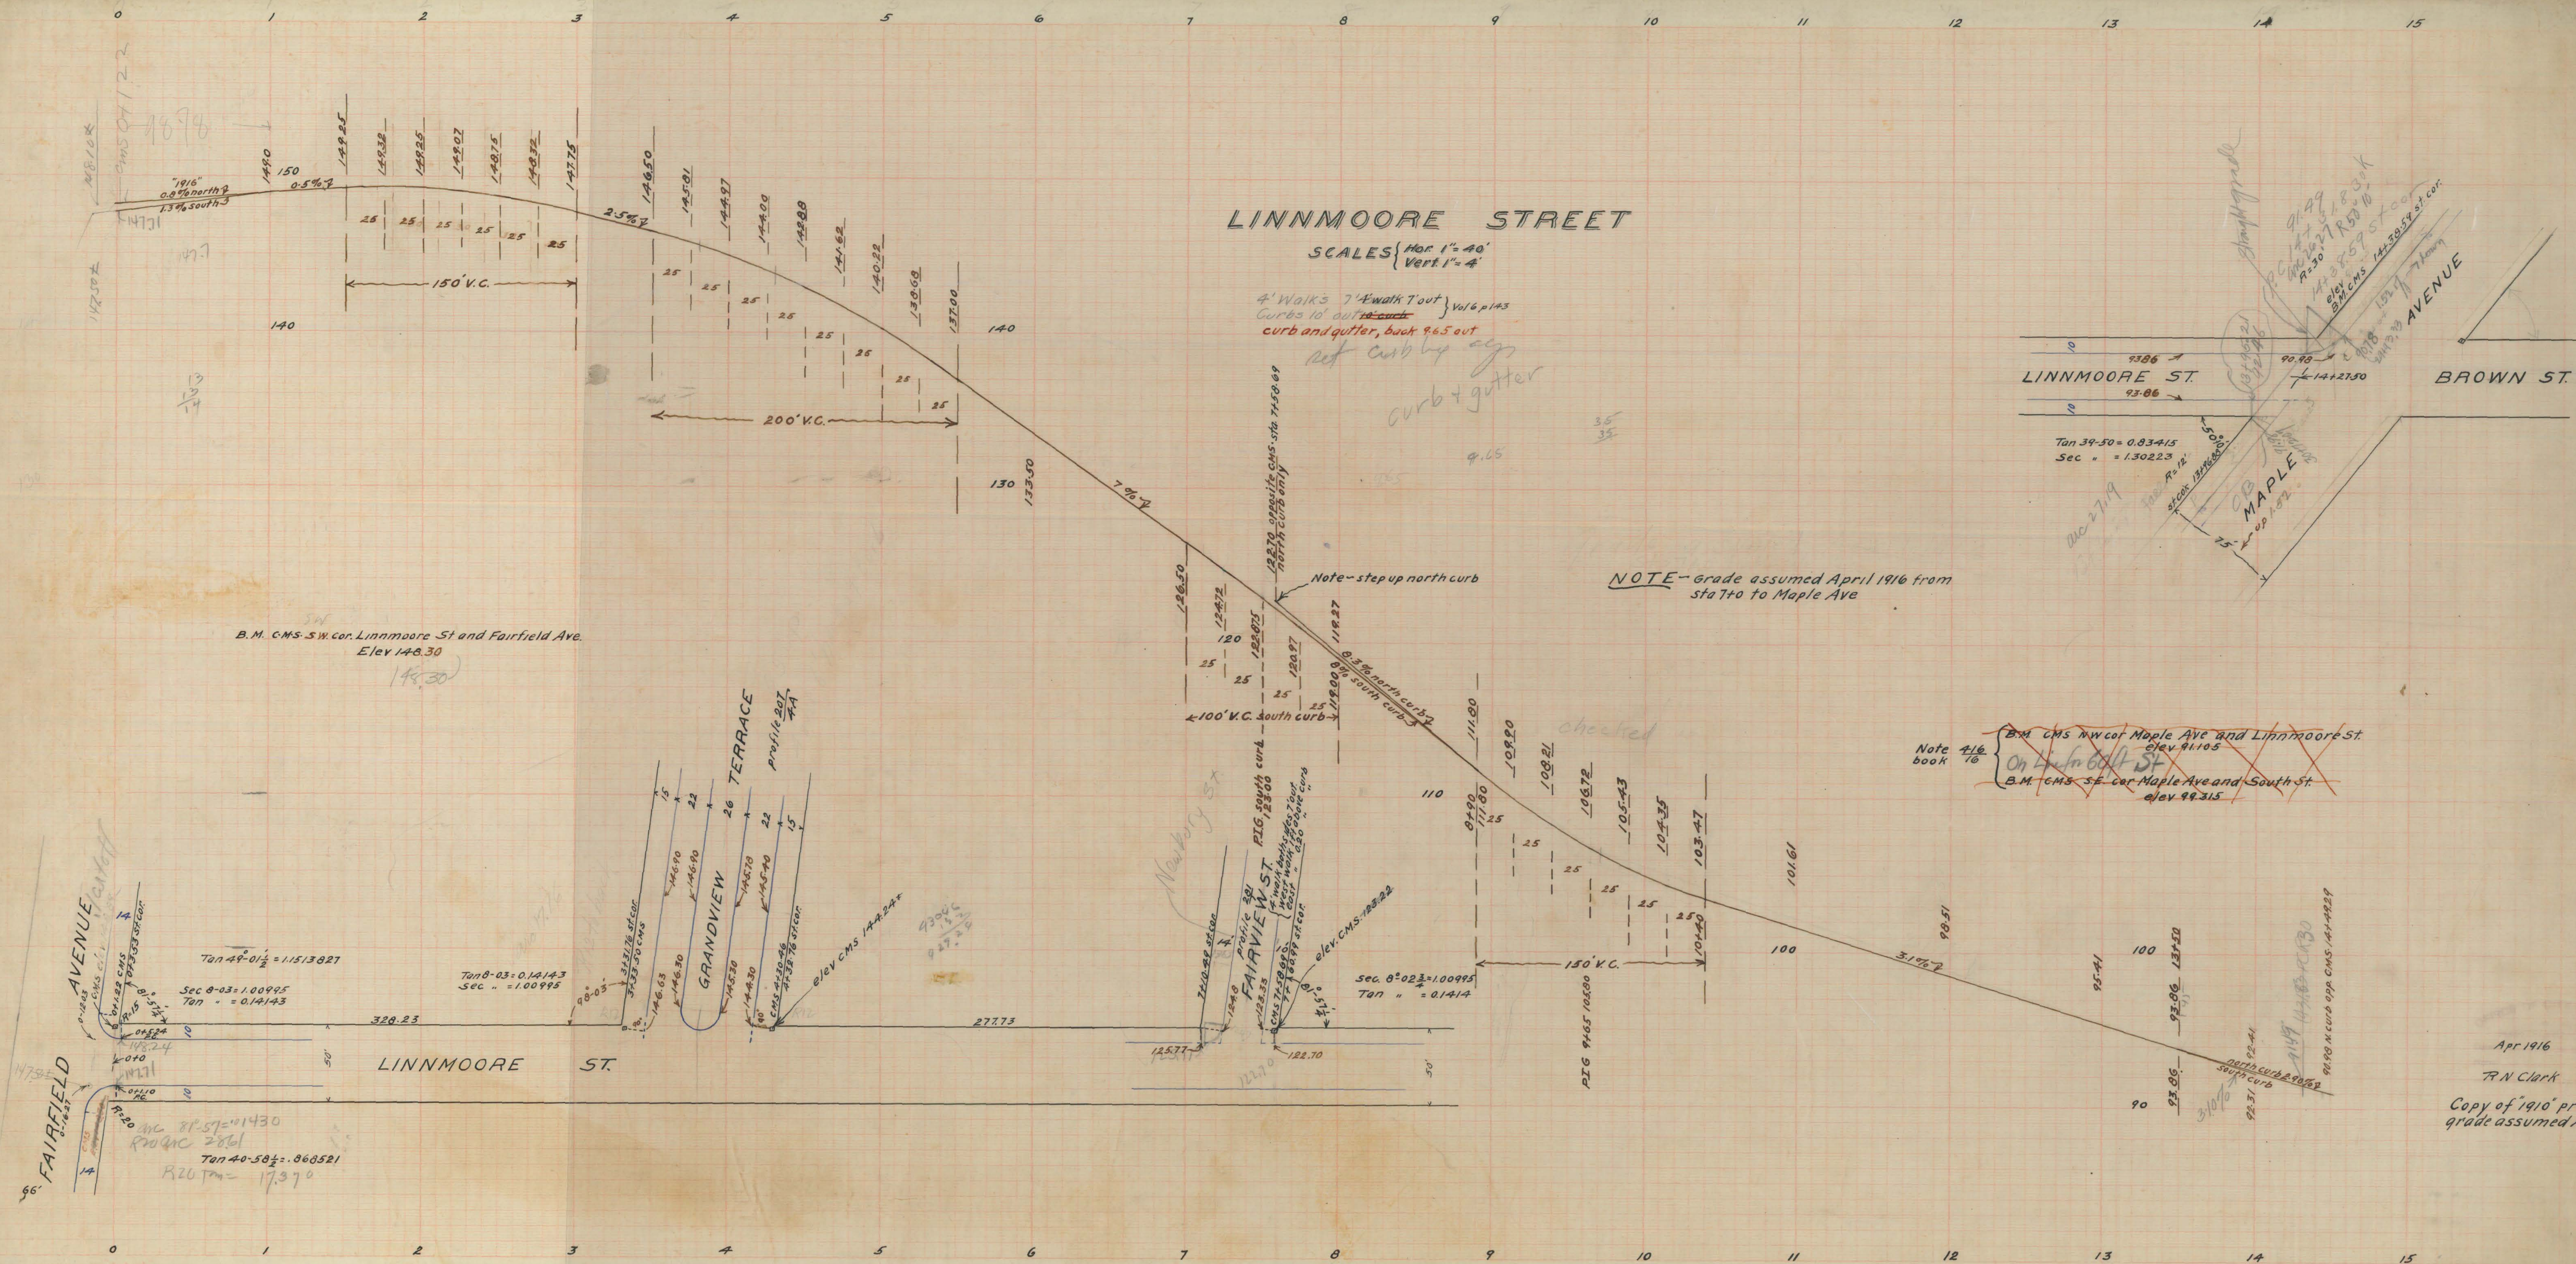

Apr 1916 02400
R N Clark
Copy of "1910" profile show
grade assumed April 1916