


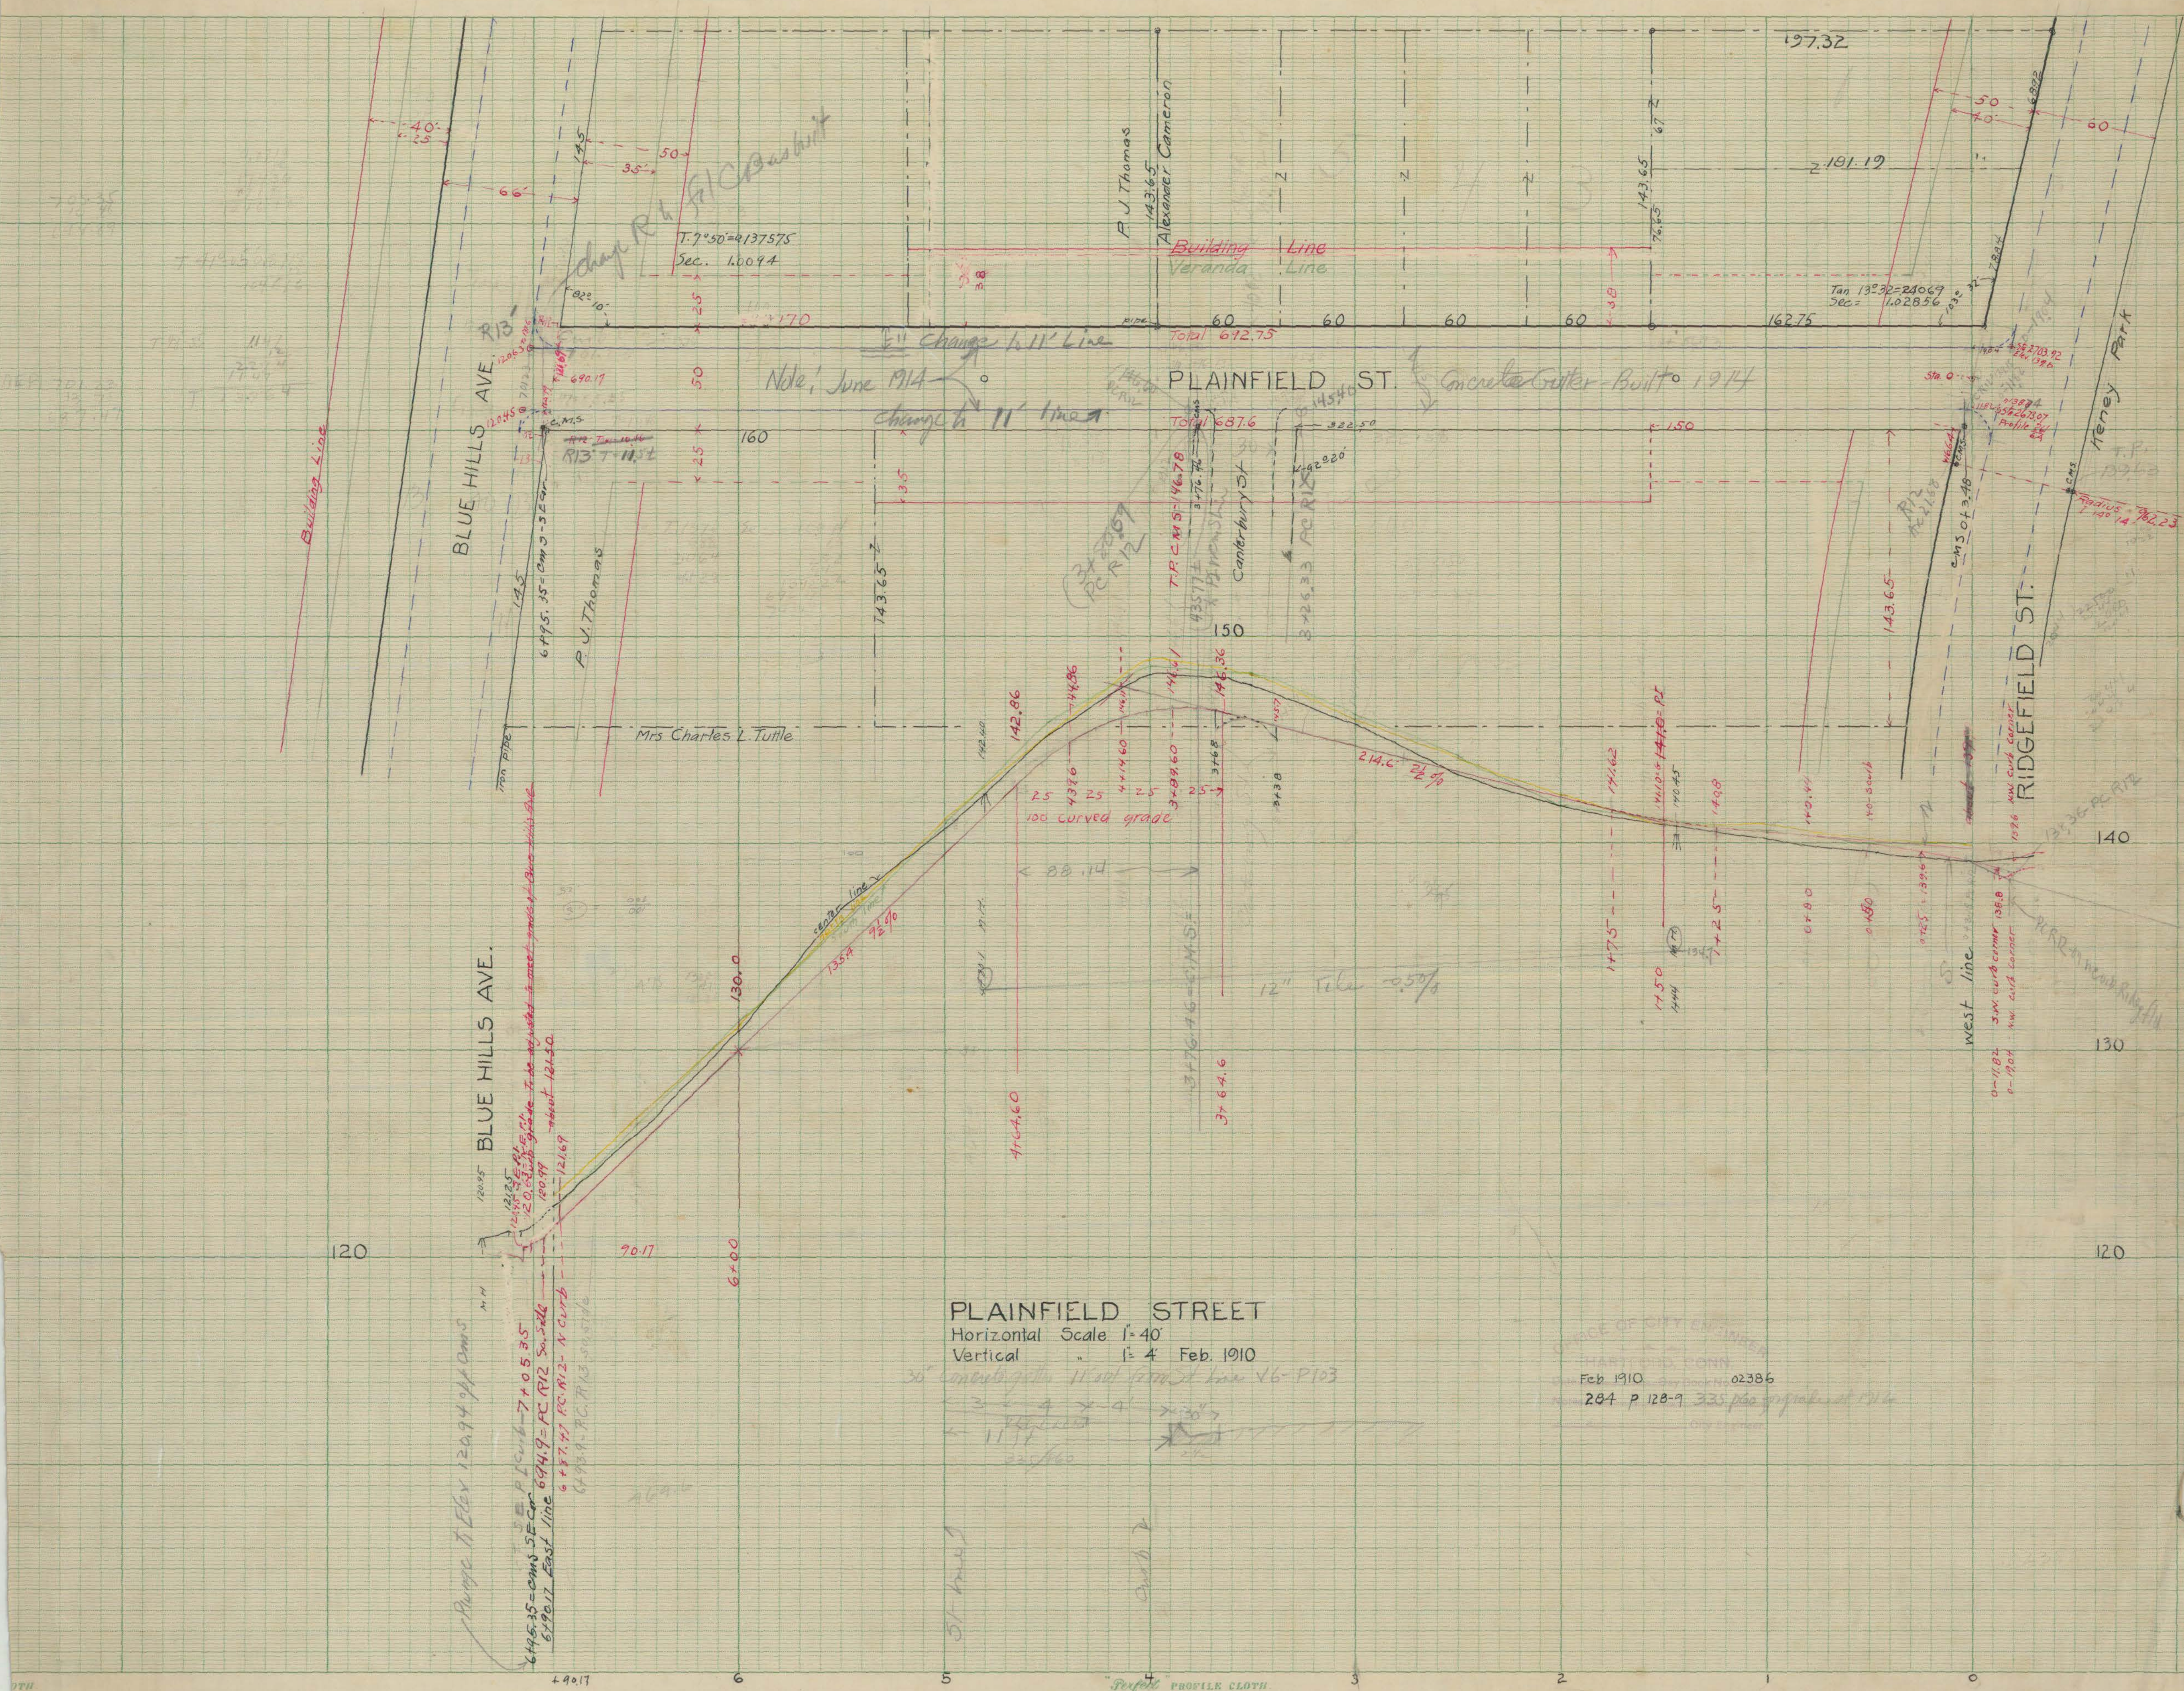

PLAINFIELD STREET

Horizontal Scale 1"=40'

Vertical Scale 1"=4'

Feb. 1910

30' concrete gutter 11' total from St. line V6-P103



