

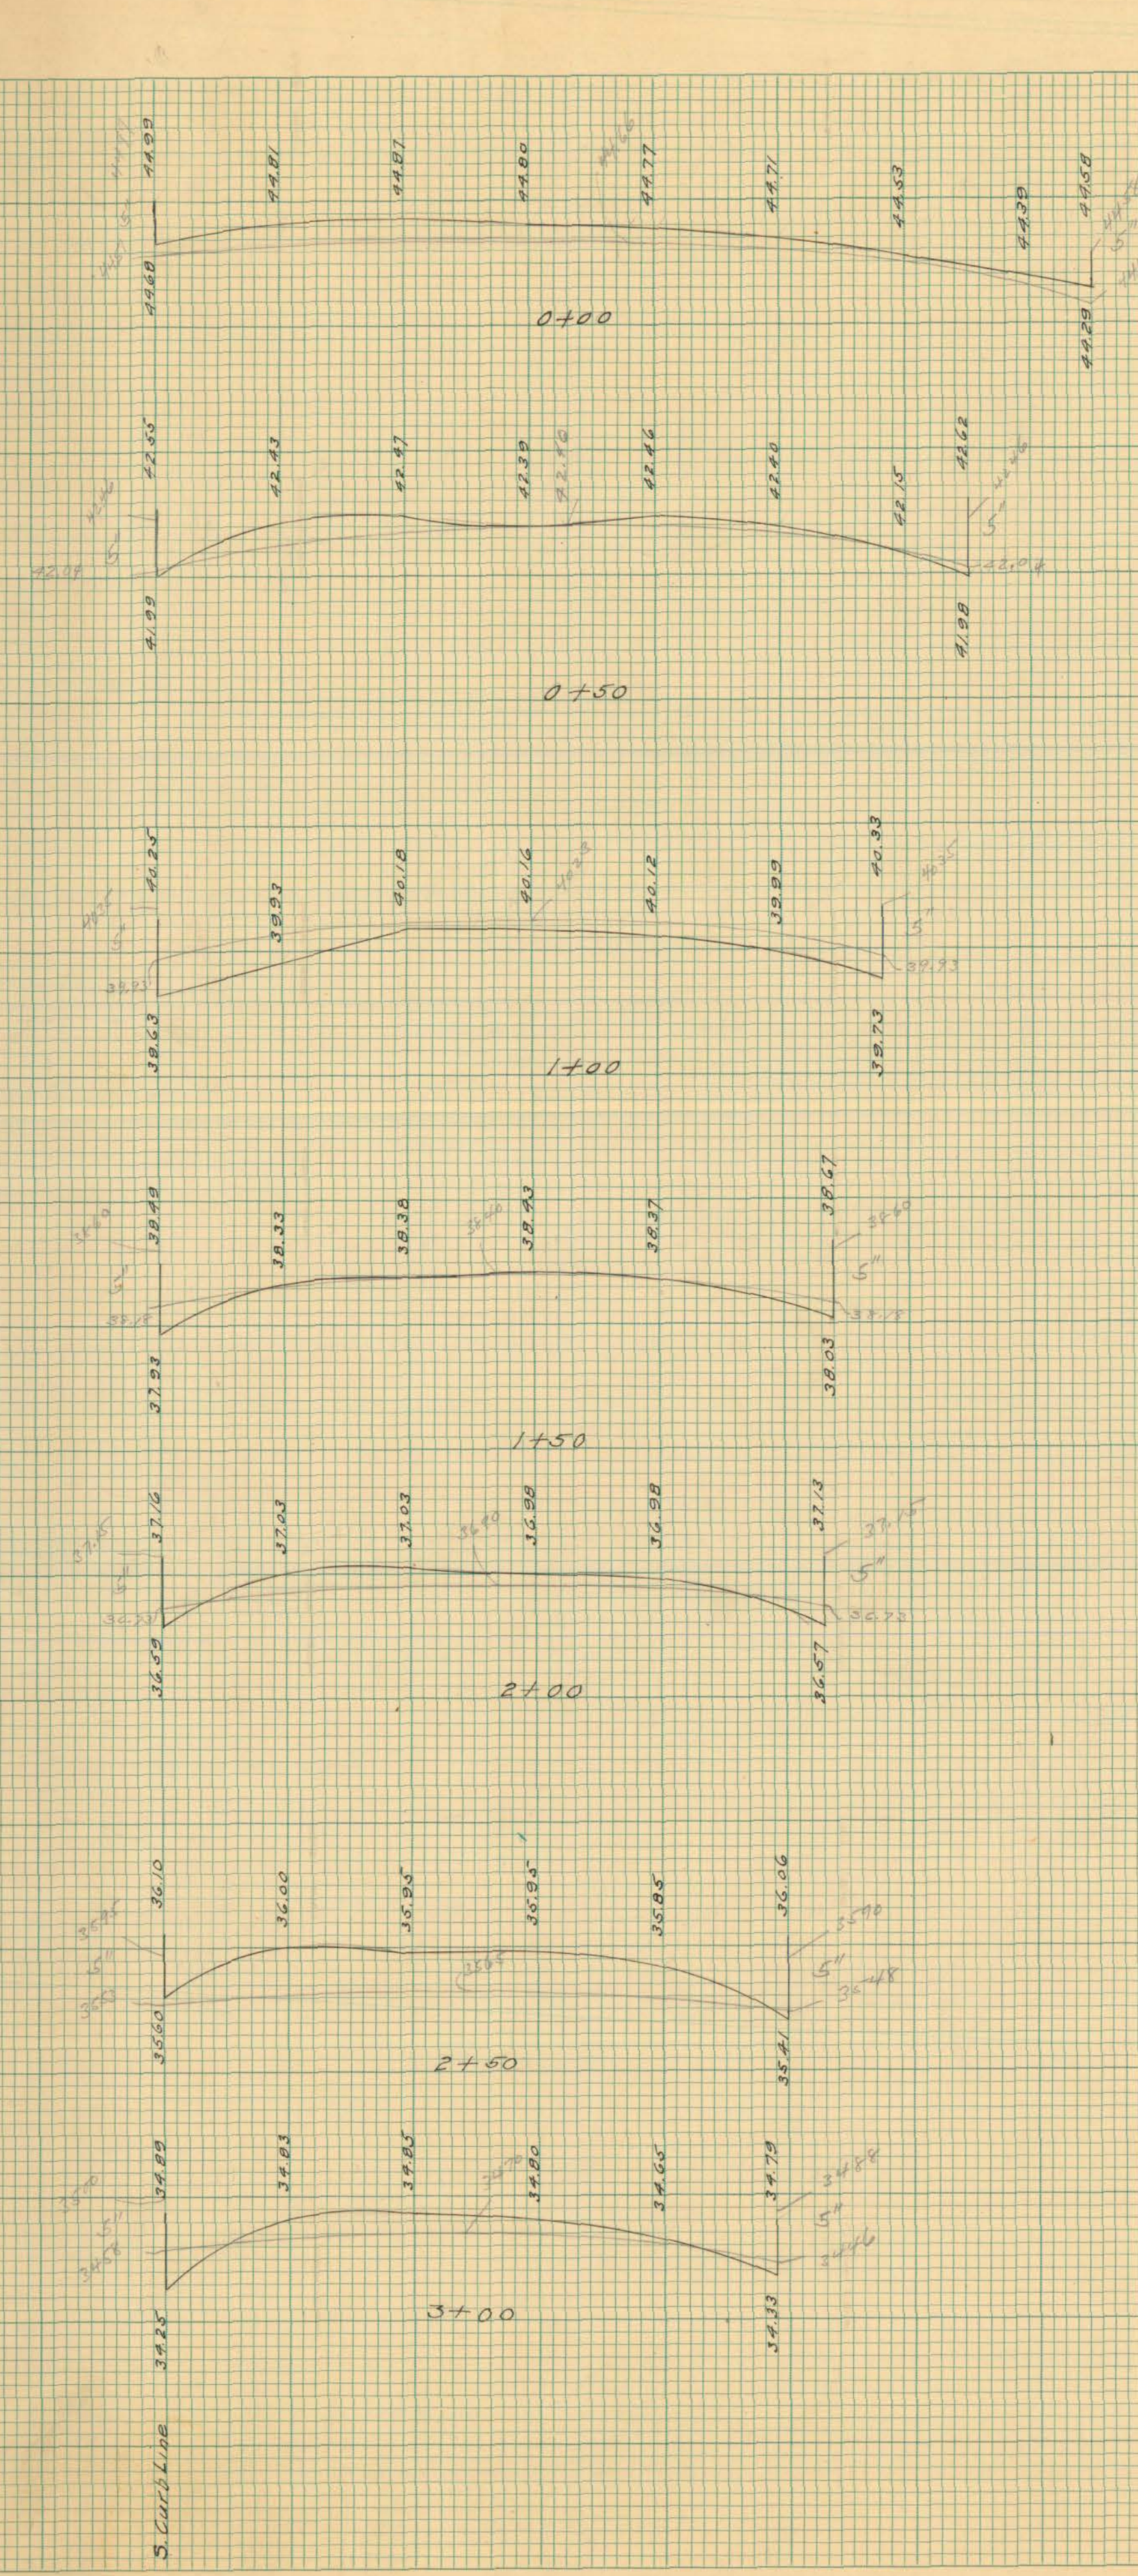
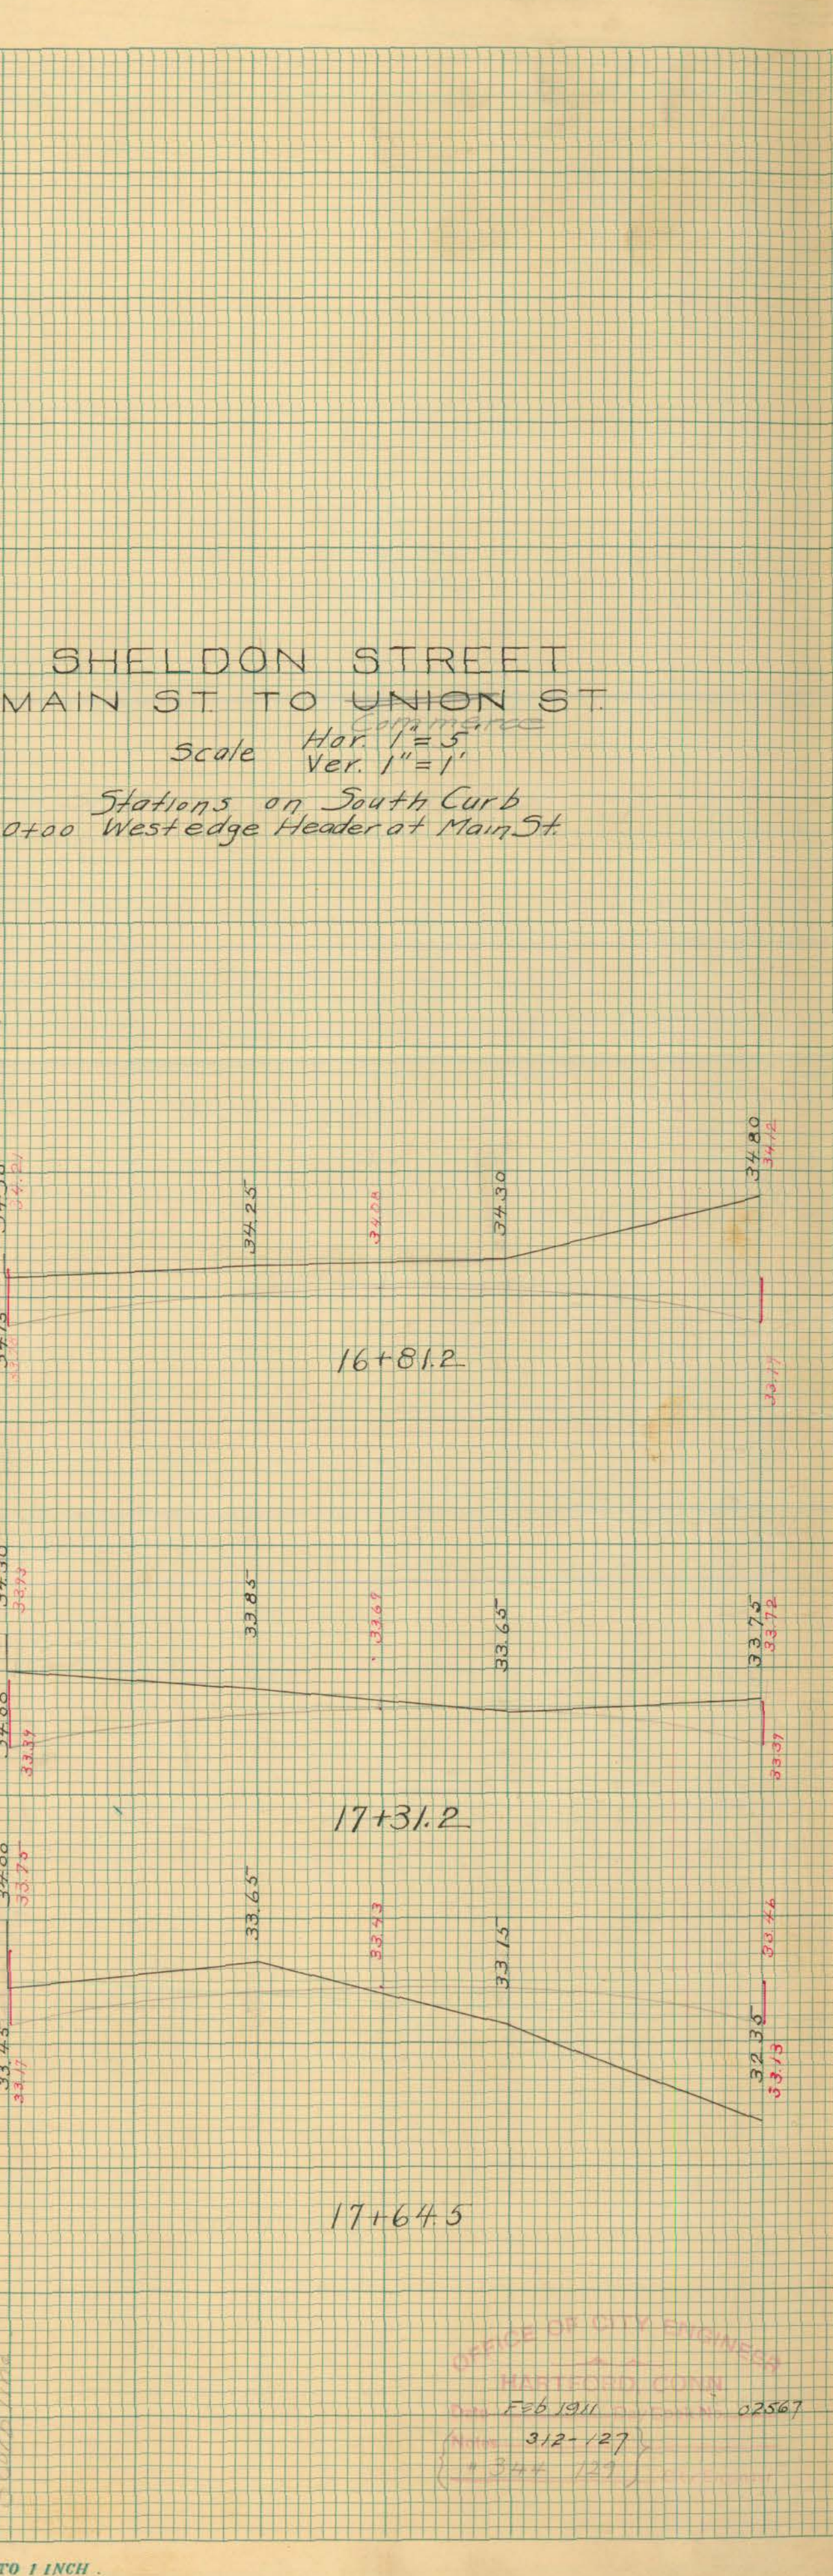
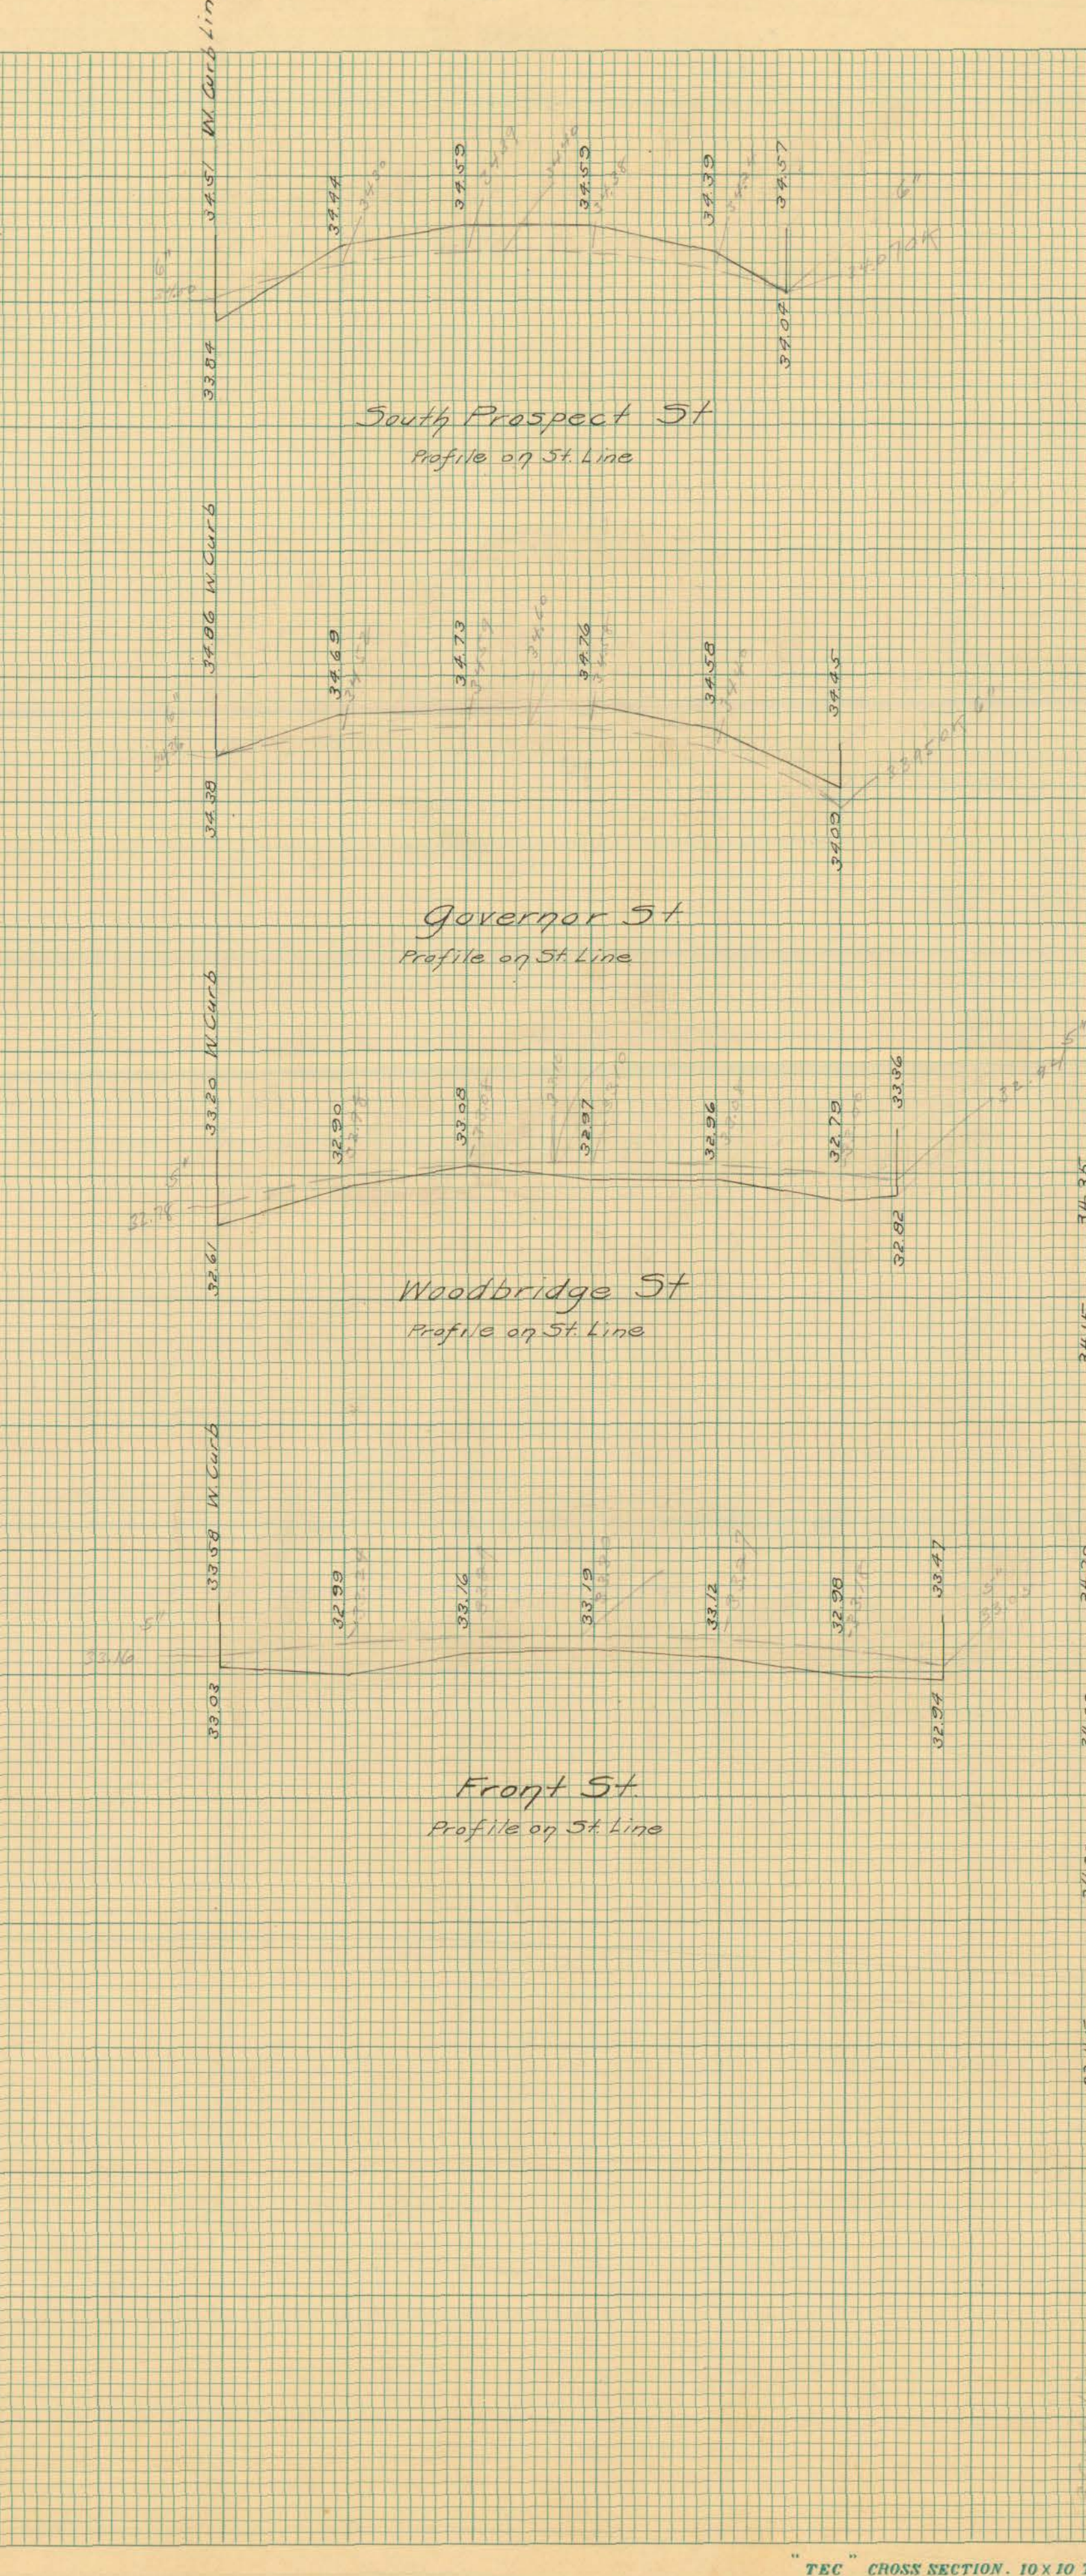
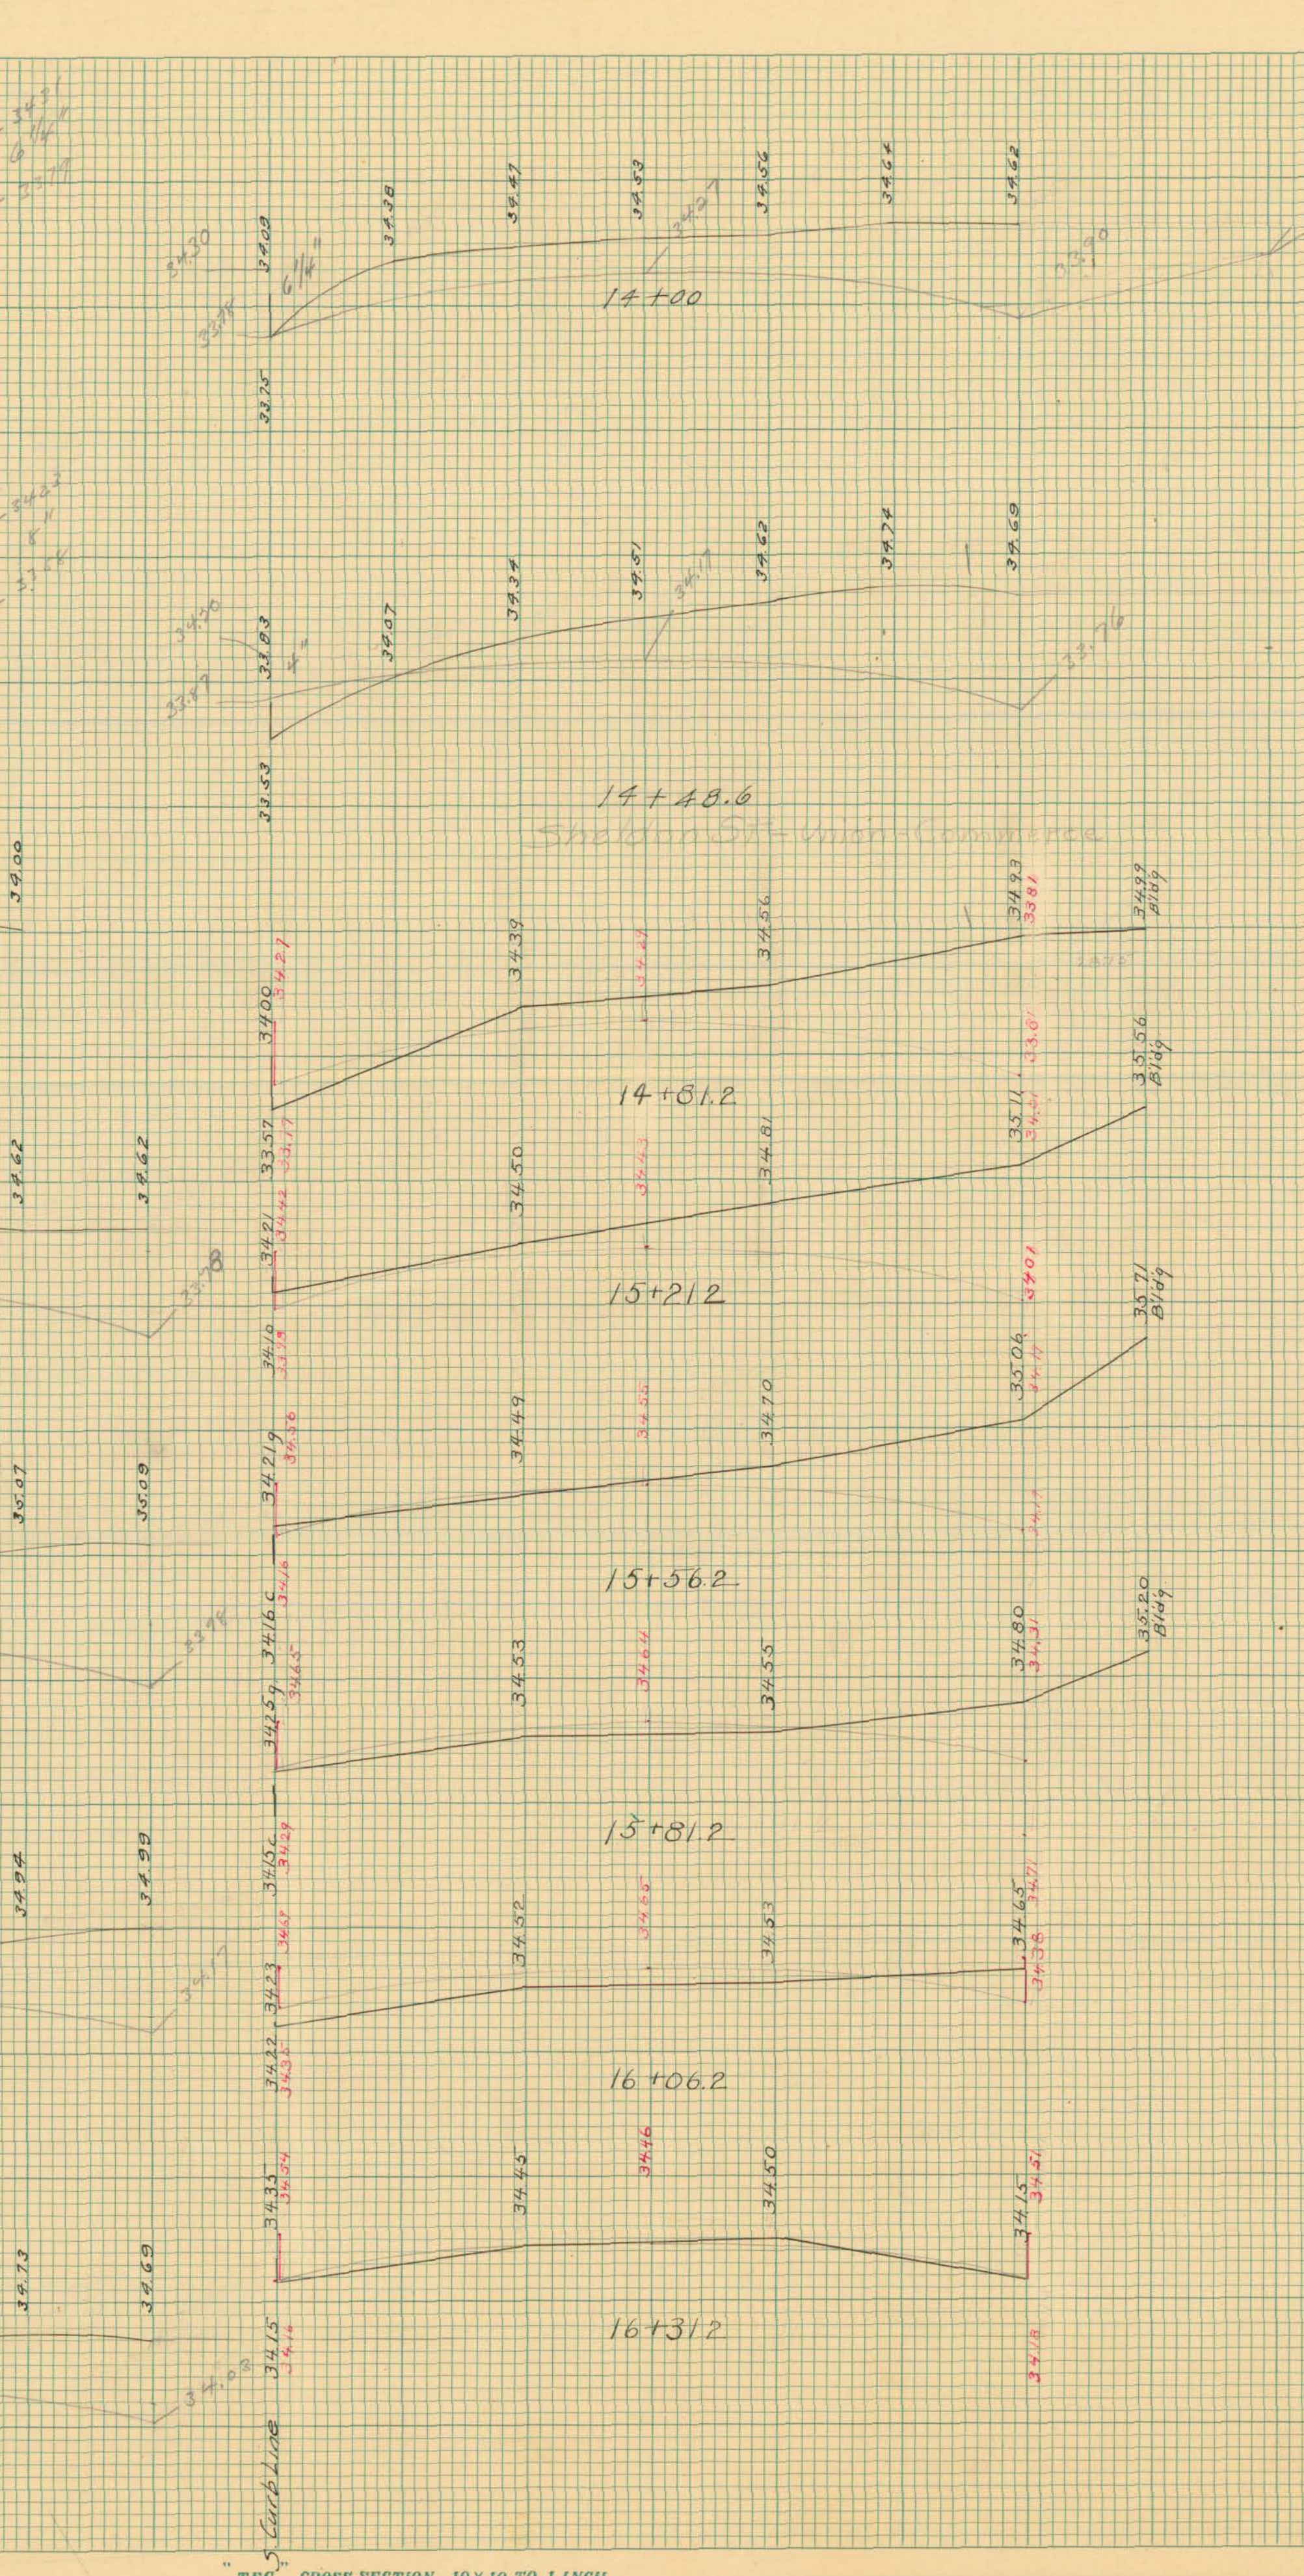
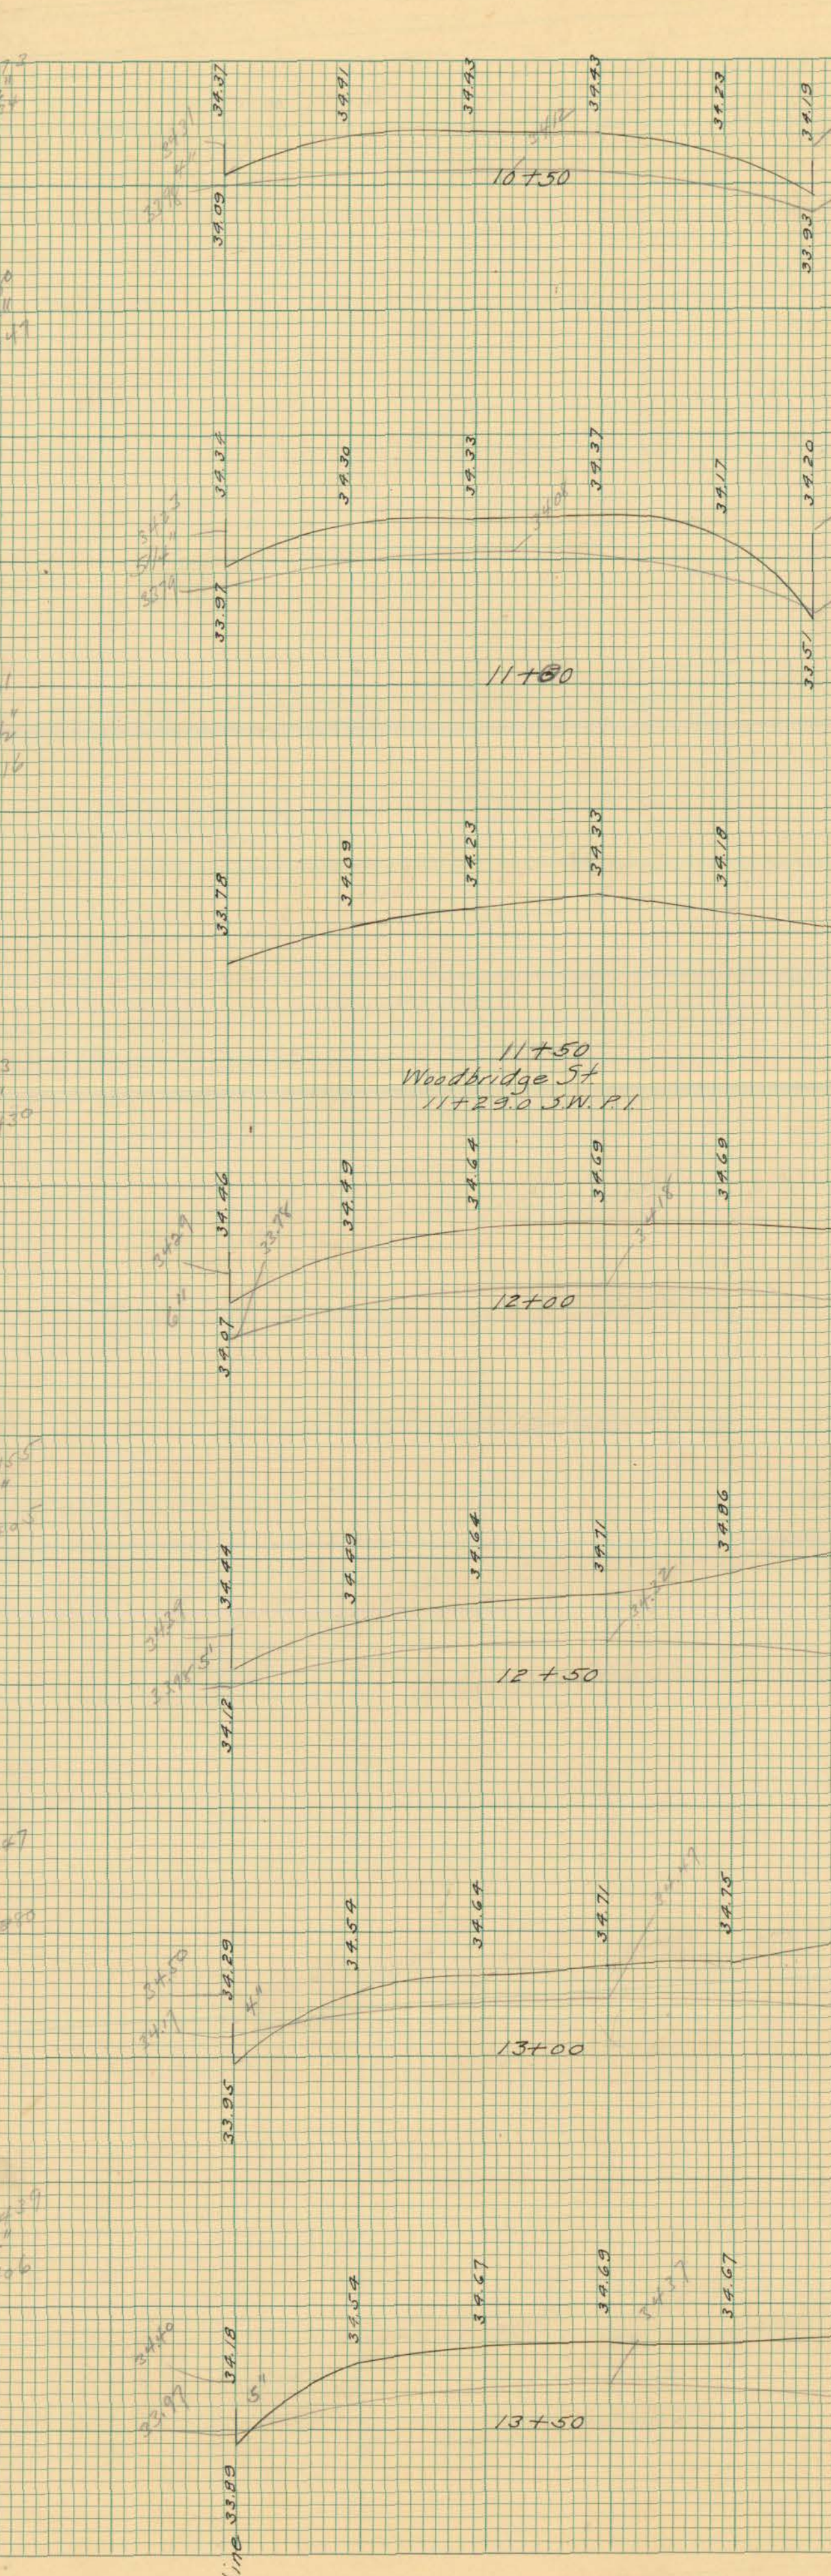


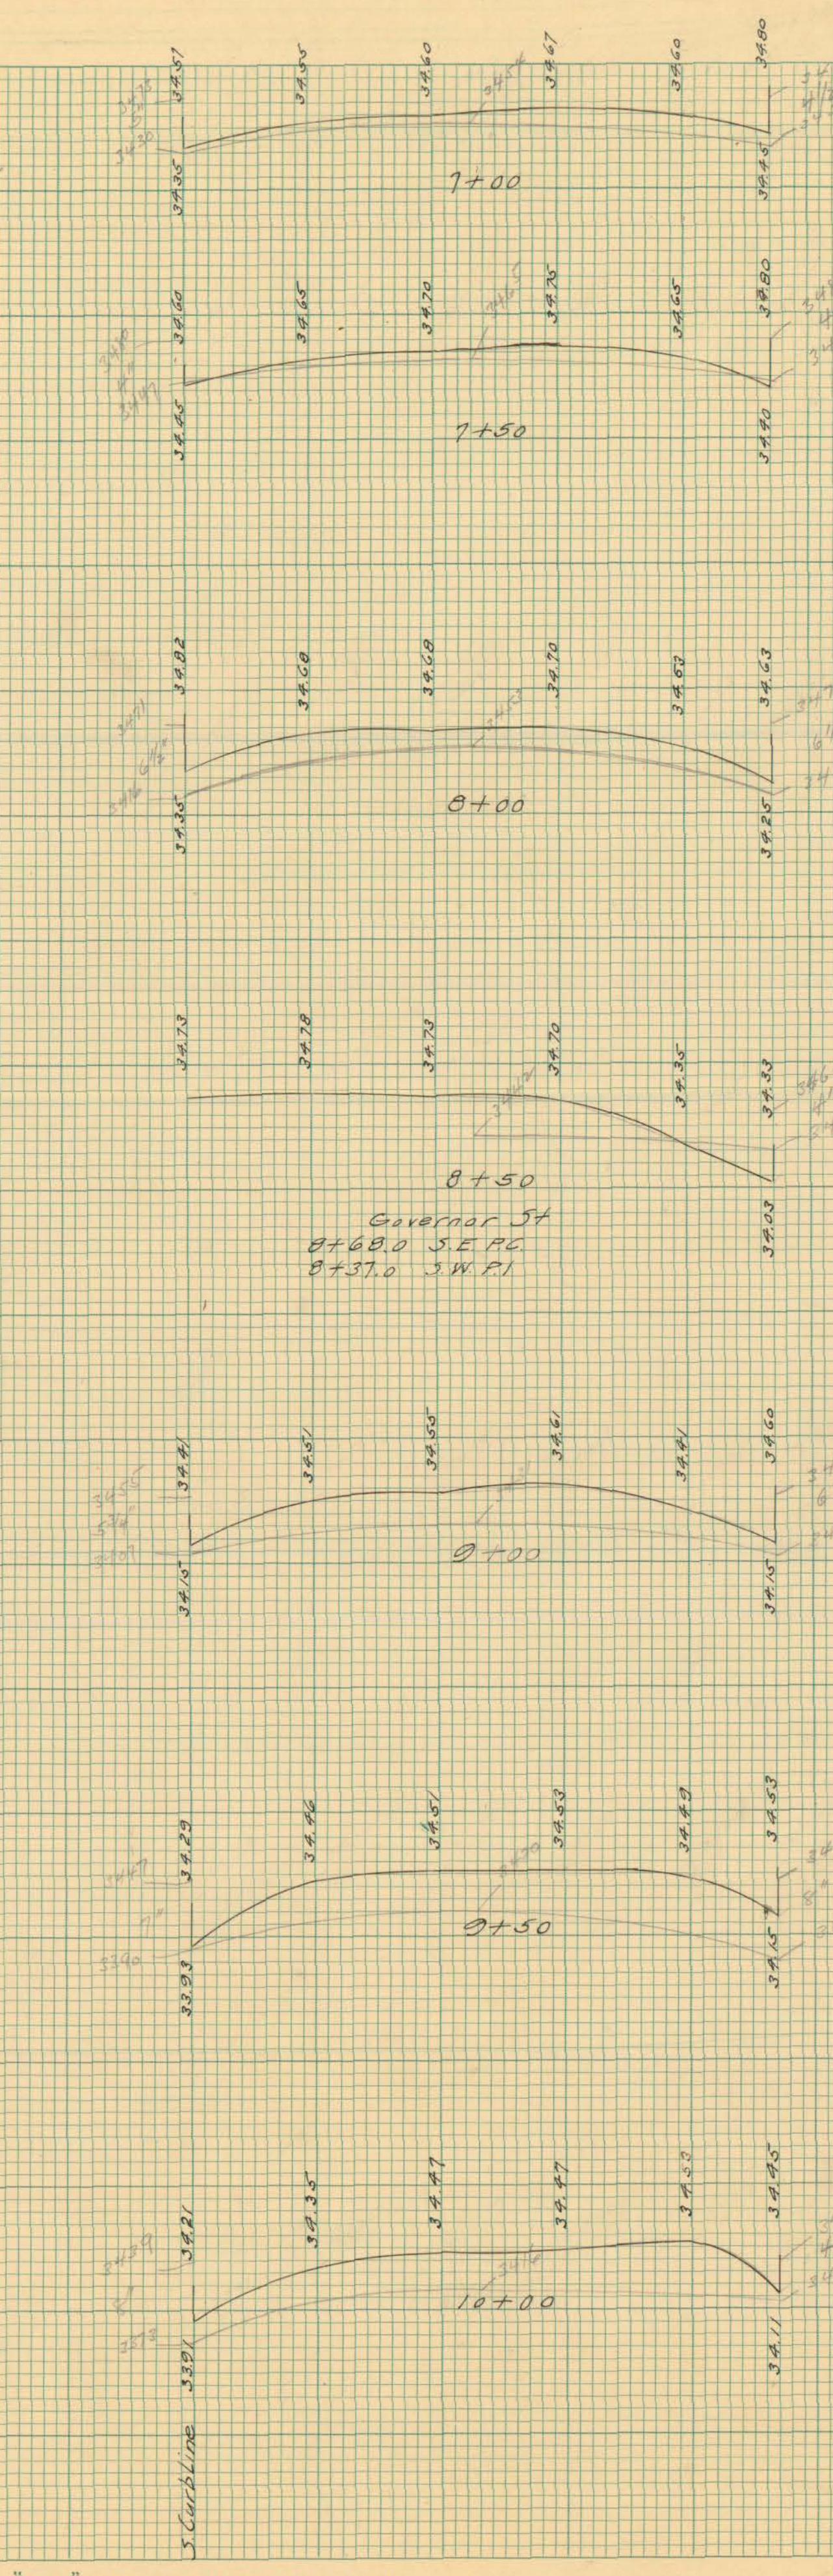

TRC CROSS SECTION. 10 X 10 TO 1 INCH.

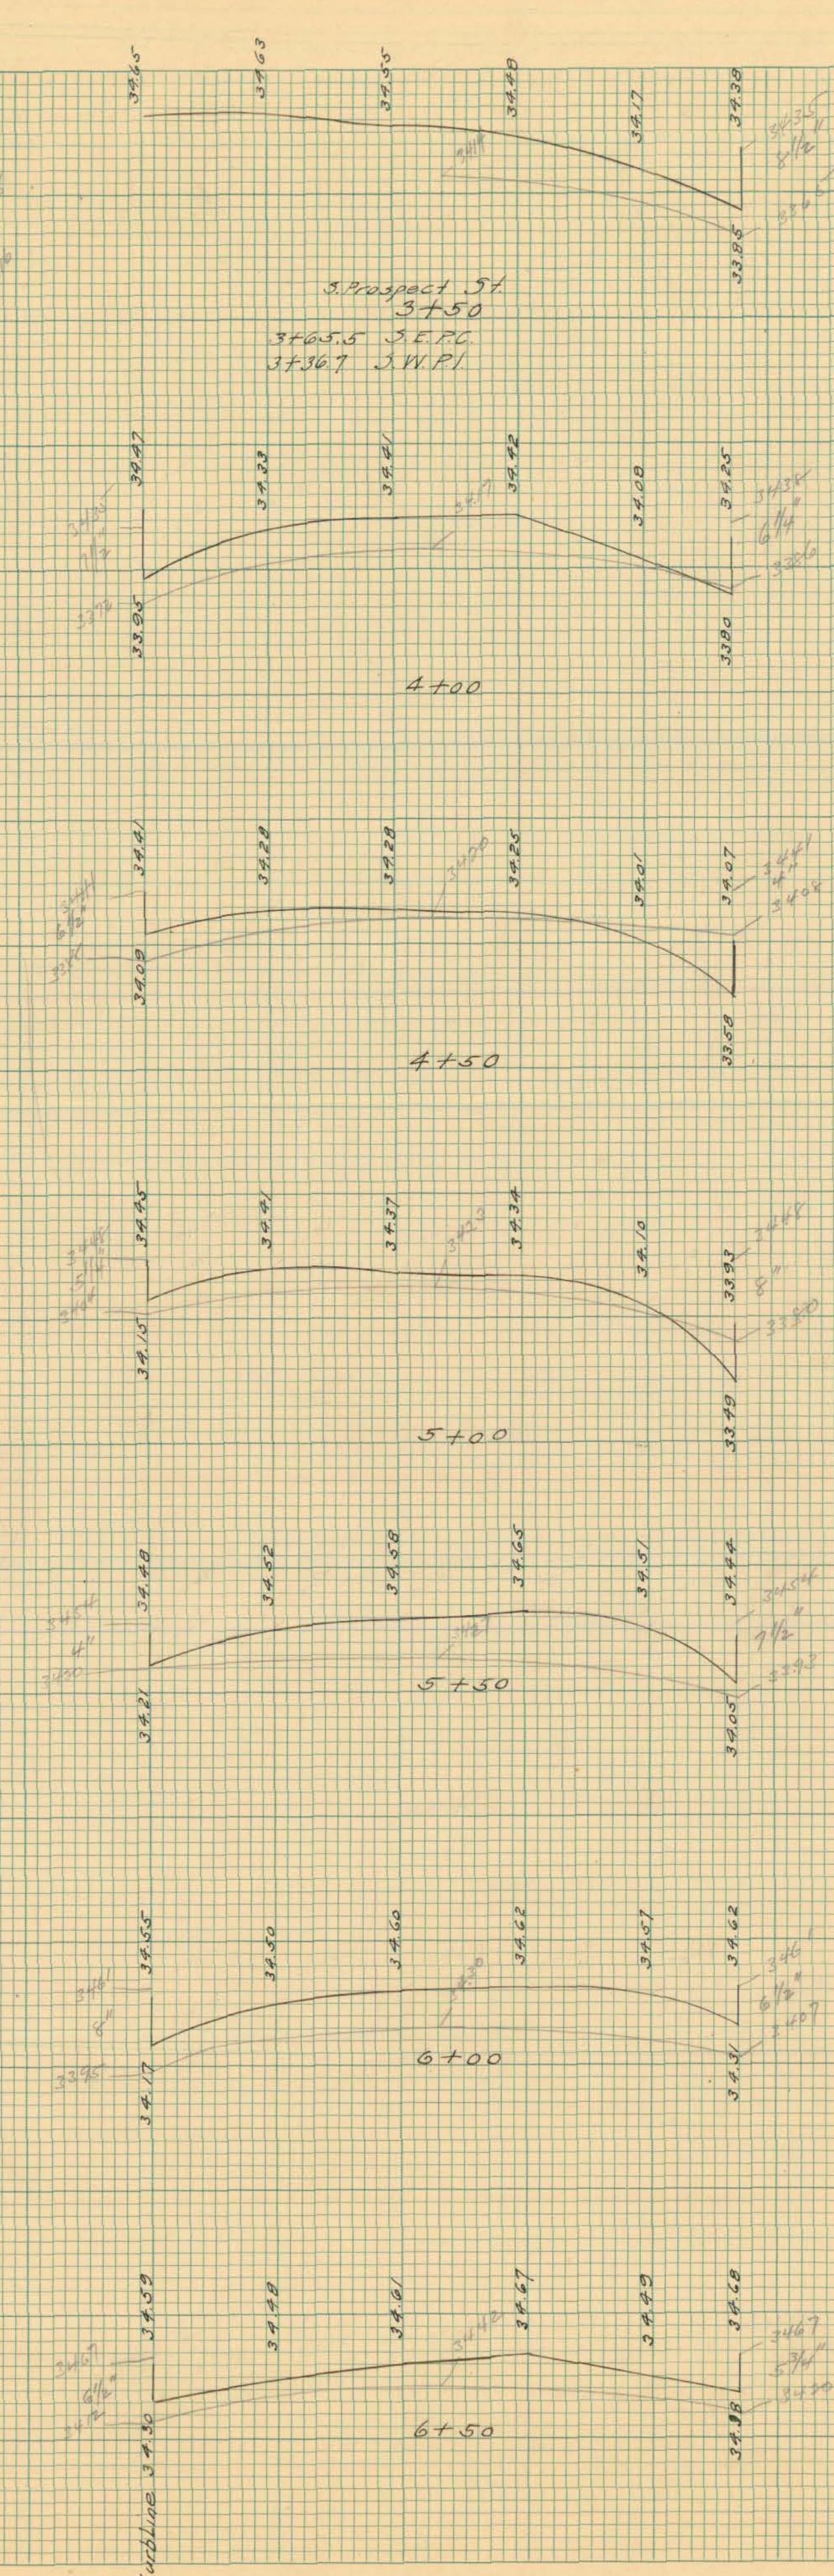

SHELDON STREET
MAIN ST TO UNION ST
Scale Hor. 1"=5'
Ver. 1"=1'
Stations on South Curb
0+00 West edge Header at Main St.

OFFICE OF THE ENGINEER
FEB 1911
312-127
(+347-101)