


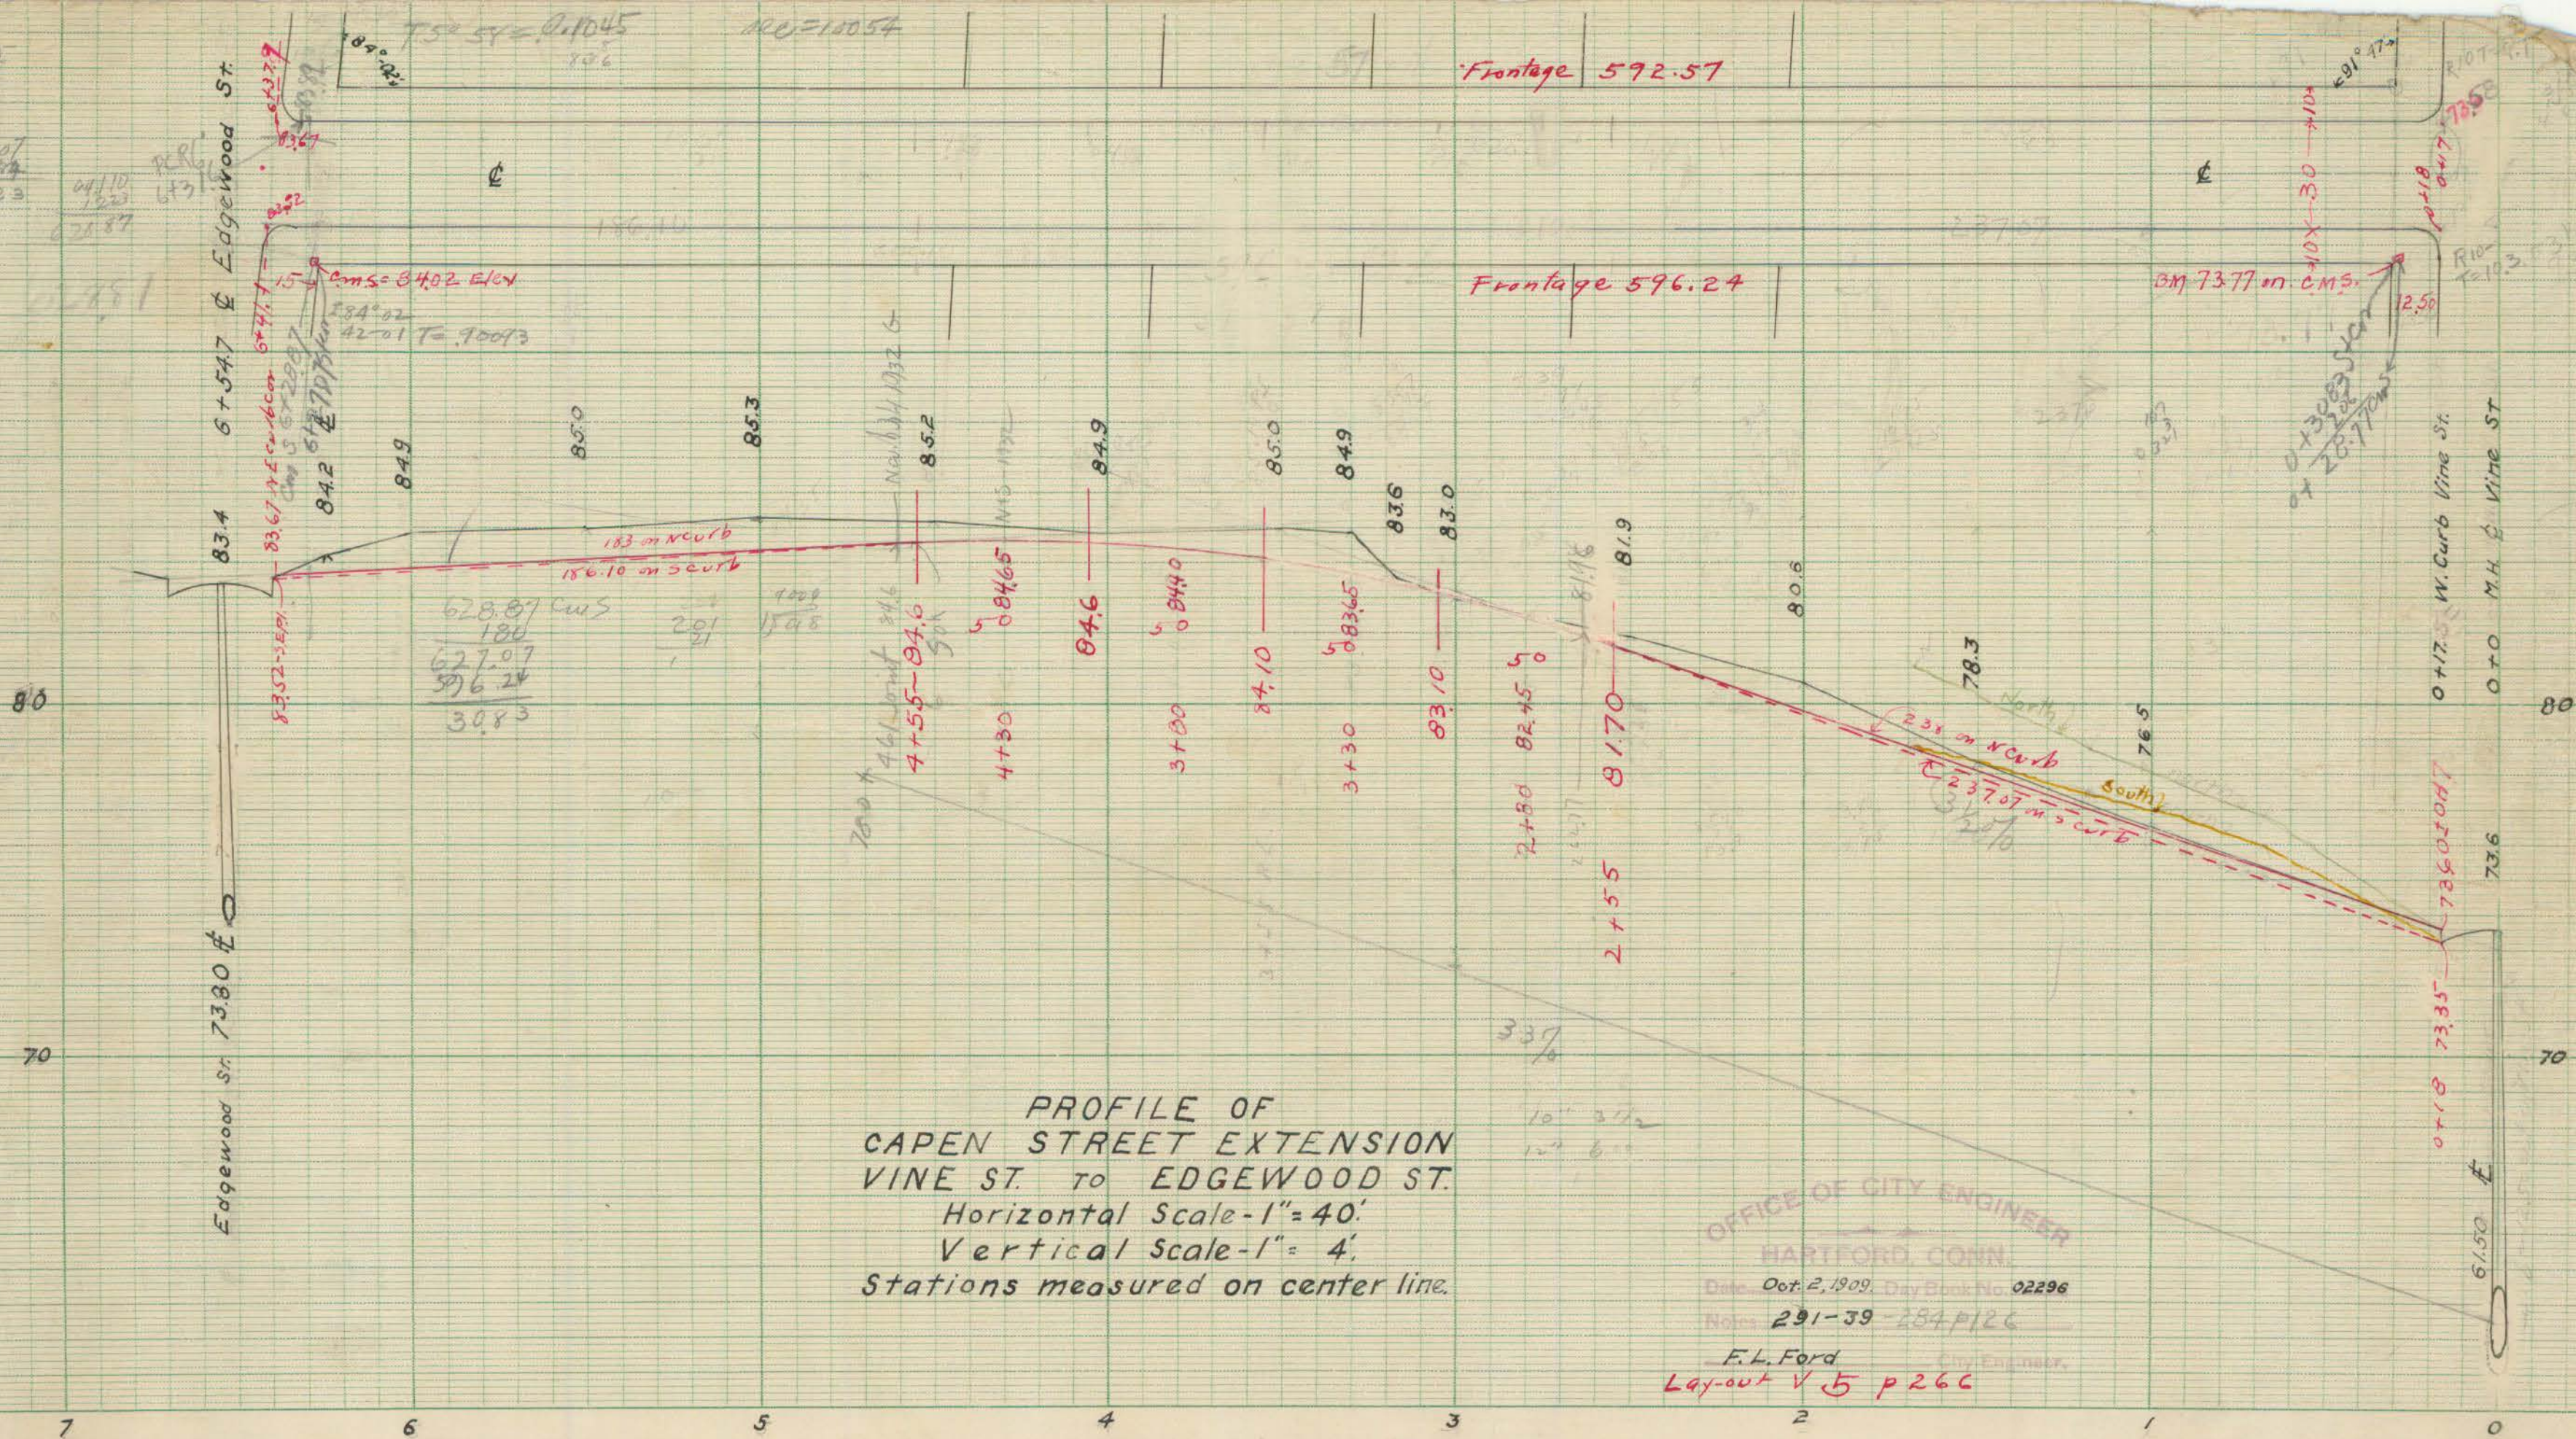

OFFICE OF CITY ENGINEER
HARTFORD, CONN.
Date: Oct. 2, 1909. Day Book No. 02296
Notes: 291-39-284 p126
F. L. Ford City Engineer.
Lay-out V 5 p 266