


PROFILE OF HURLBURT ST.
Horizontal Scale 1" = 40'
Vertical Scale 1" = 20'

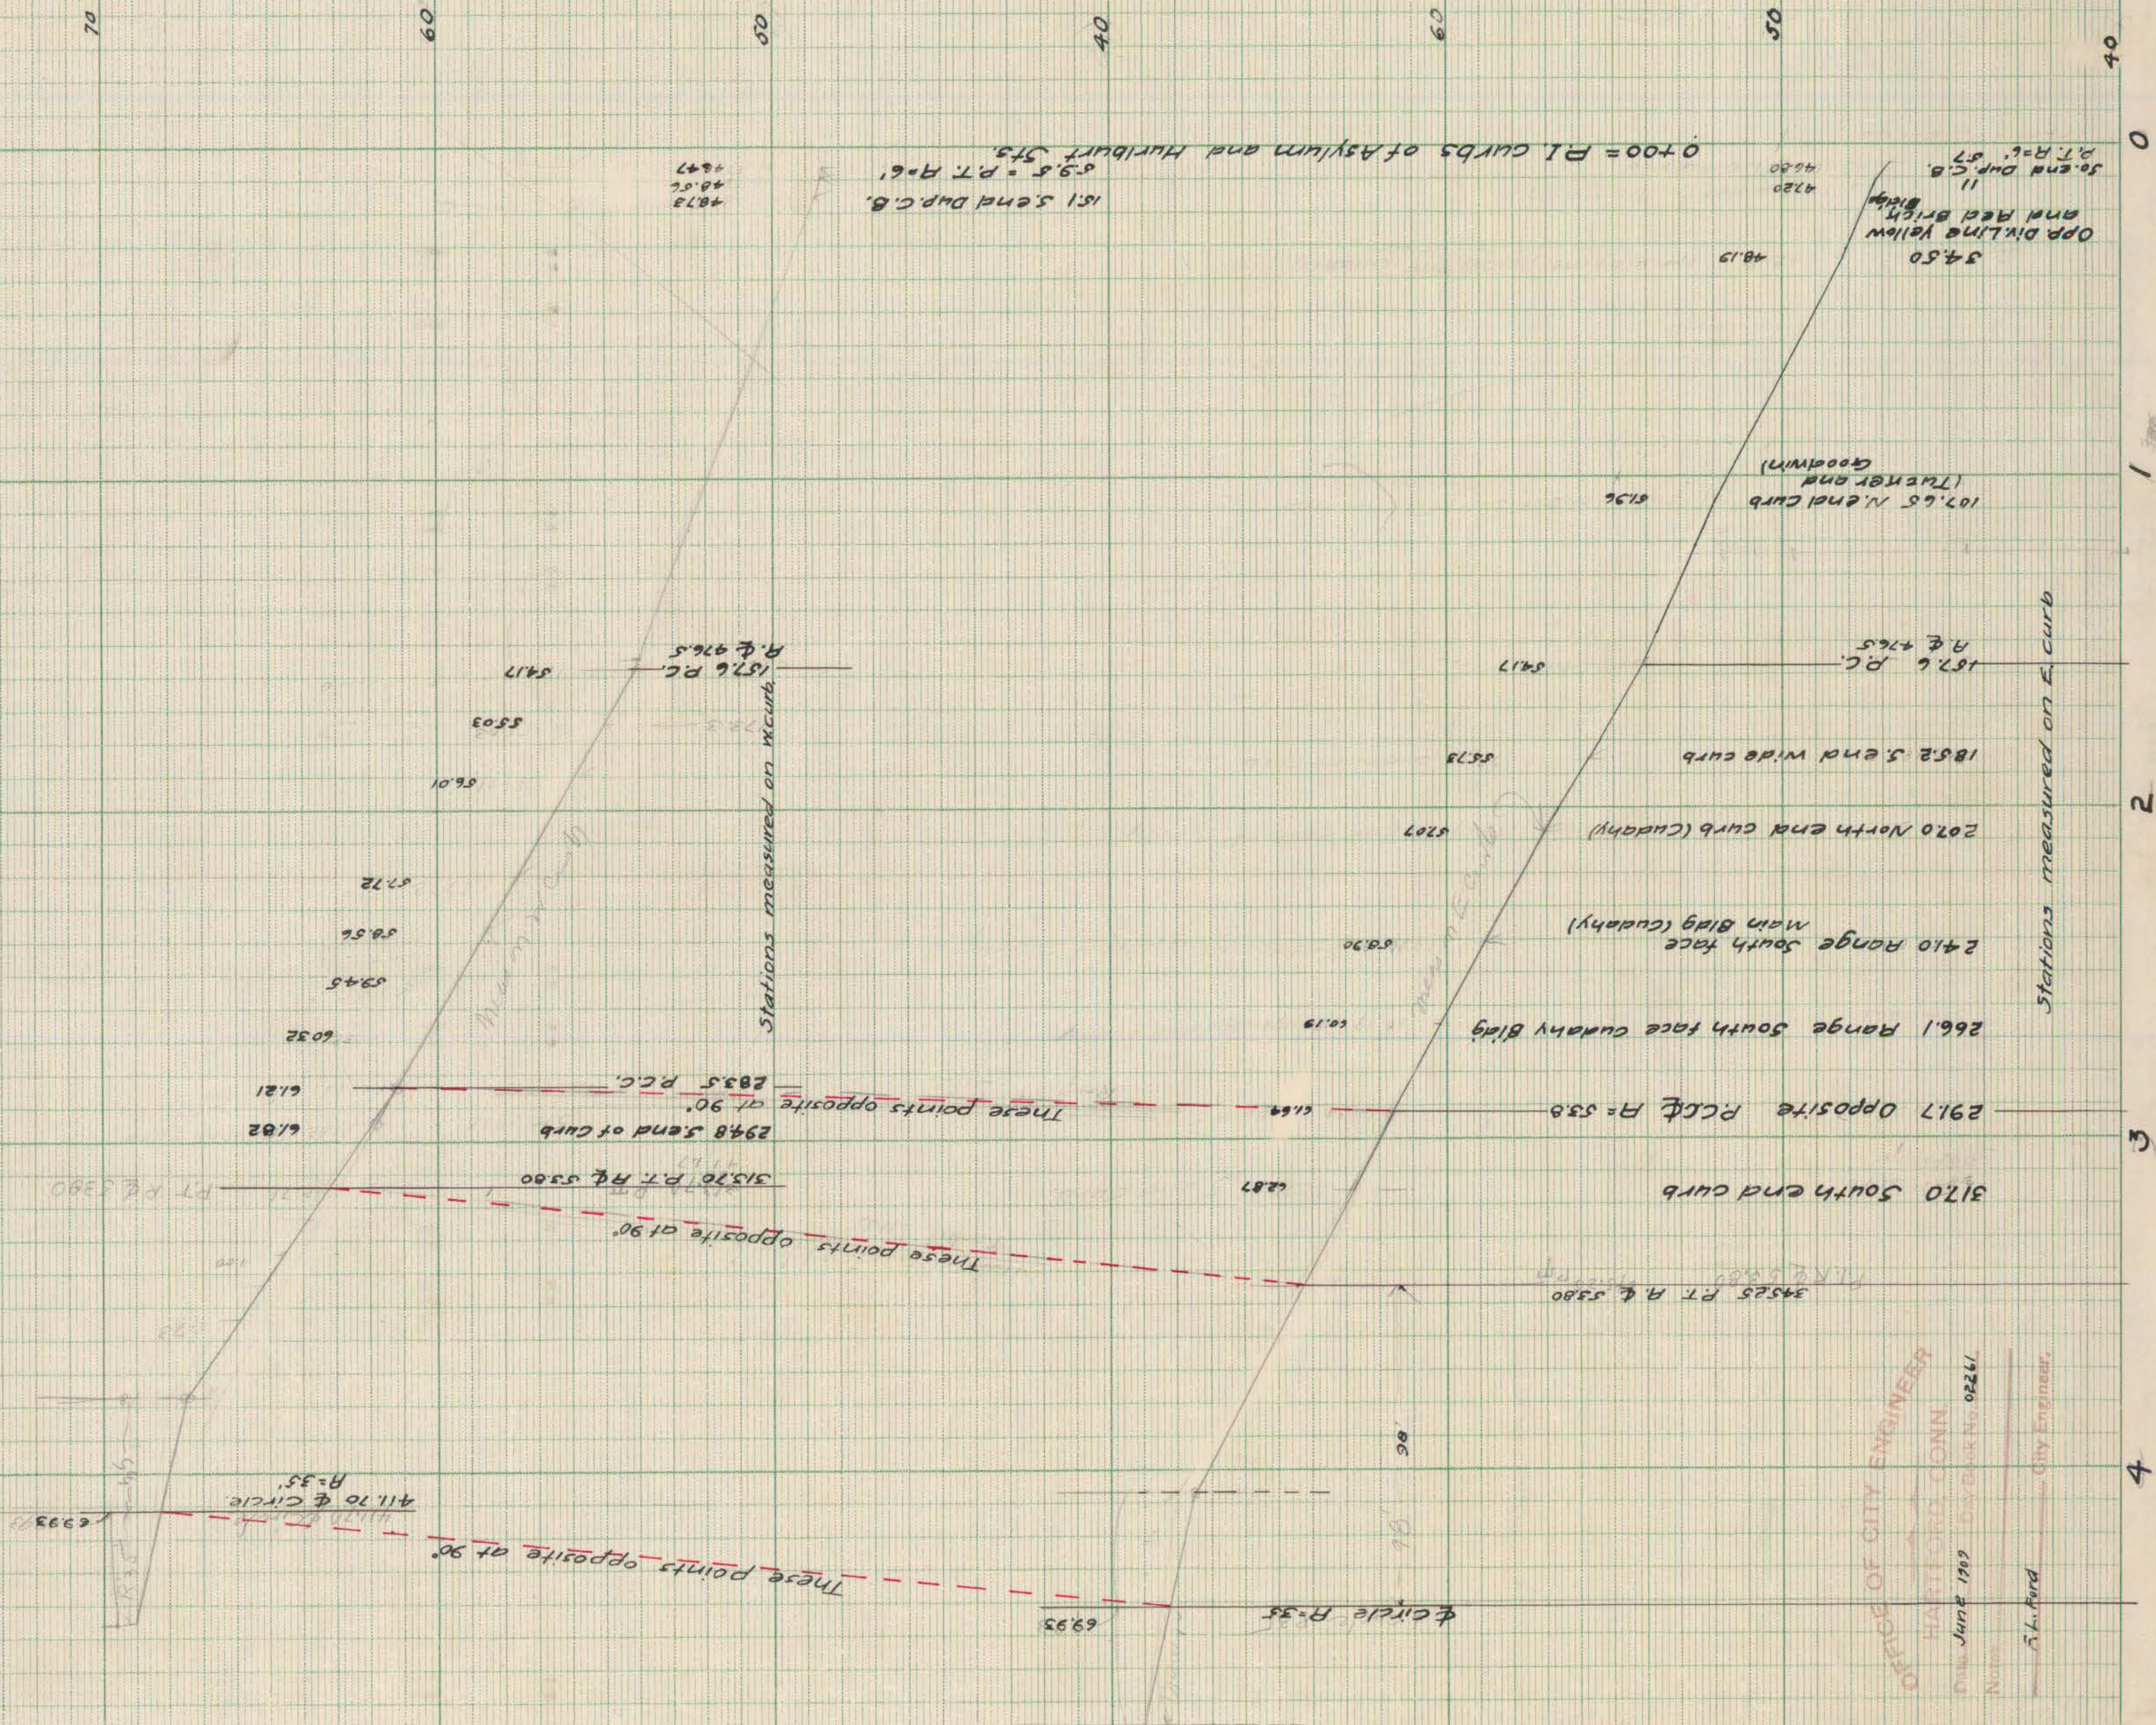

OFFICE OF CITY ENGINEER
HARTFORD CONN.
Notes
A.L. Ford City Engineer.