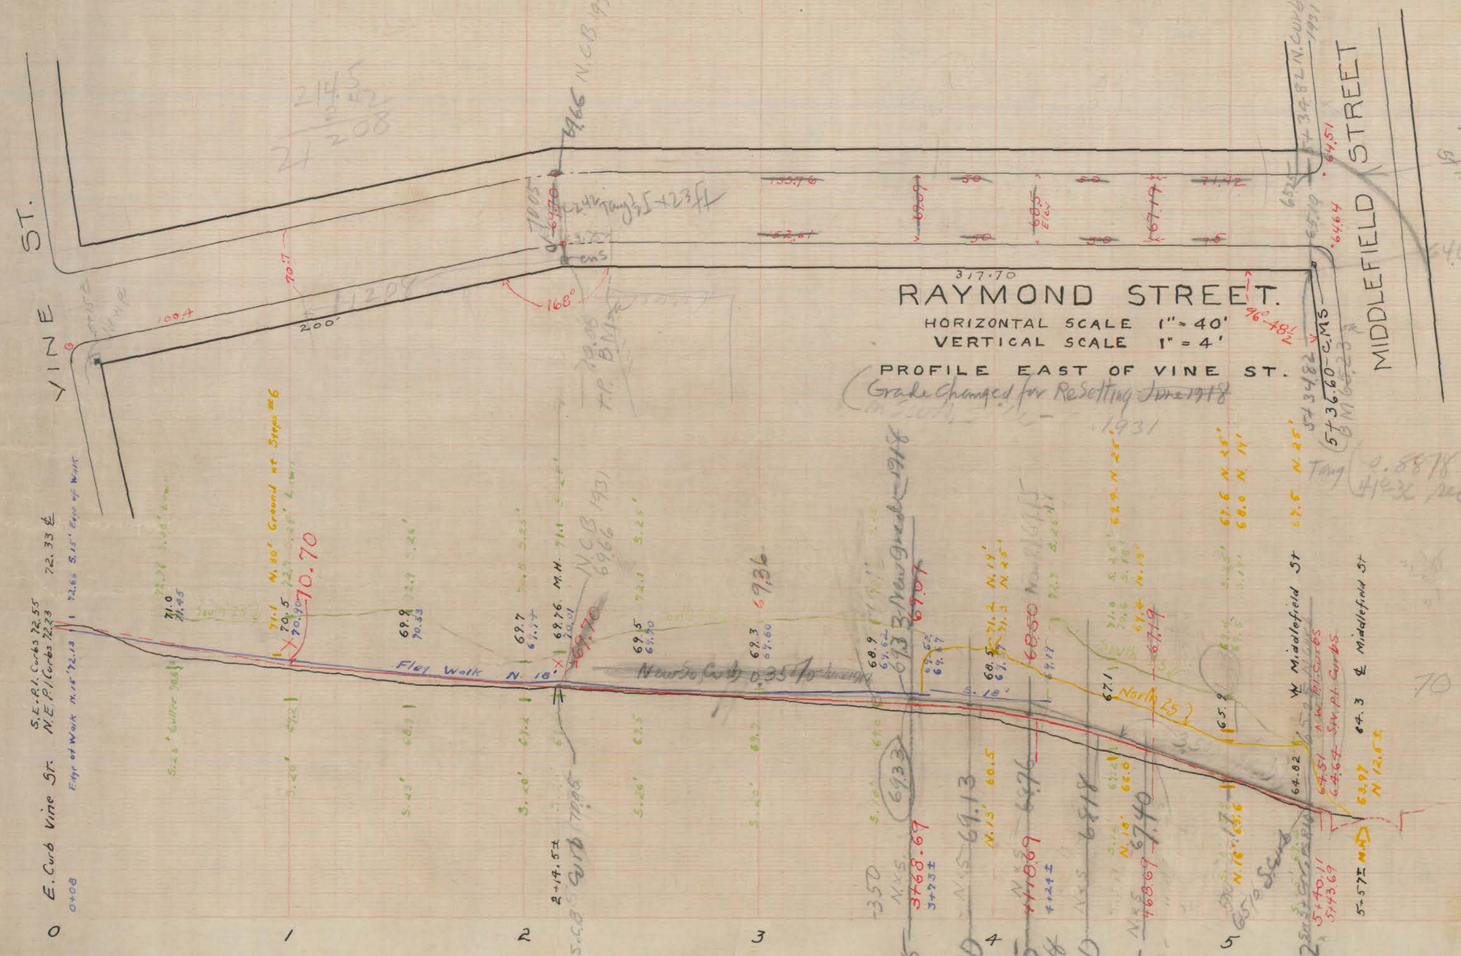

OFFICE OF CITY ENGINEER
HARTFORD, CONN.
Date May 1911 Block No. 02648
Notes 333 — 98
R. N. Clark
Blue Print made July 1918