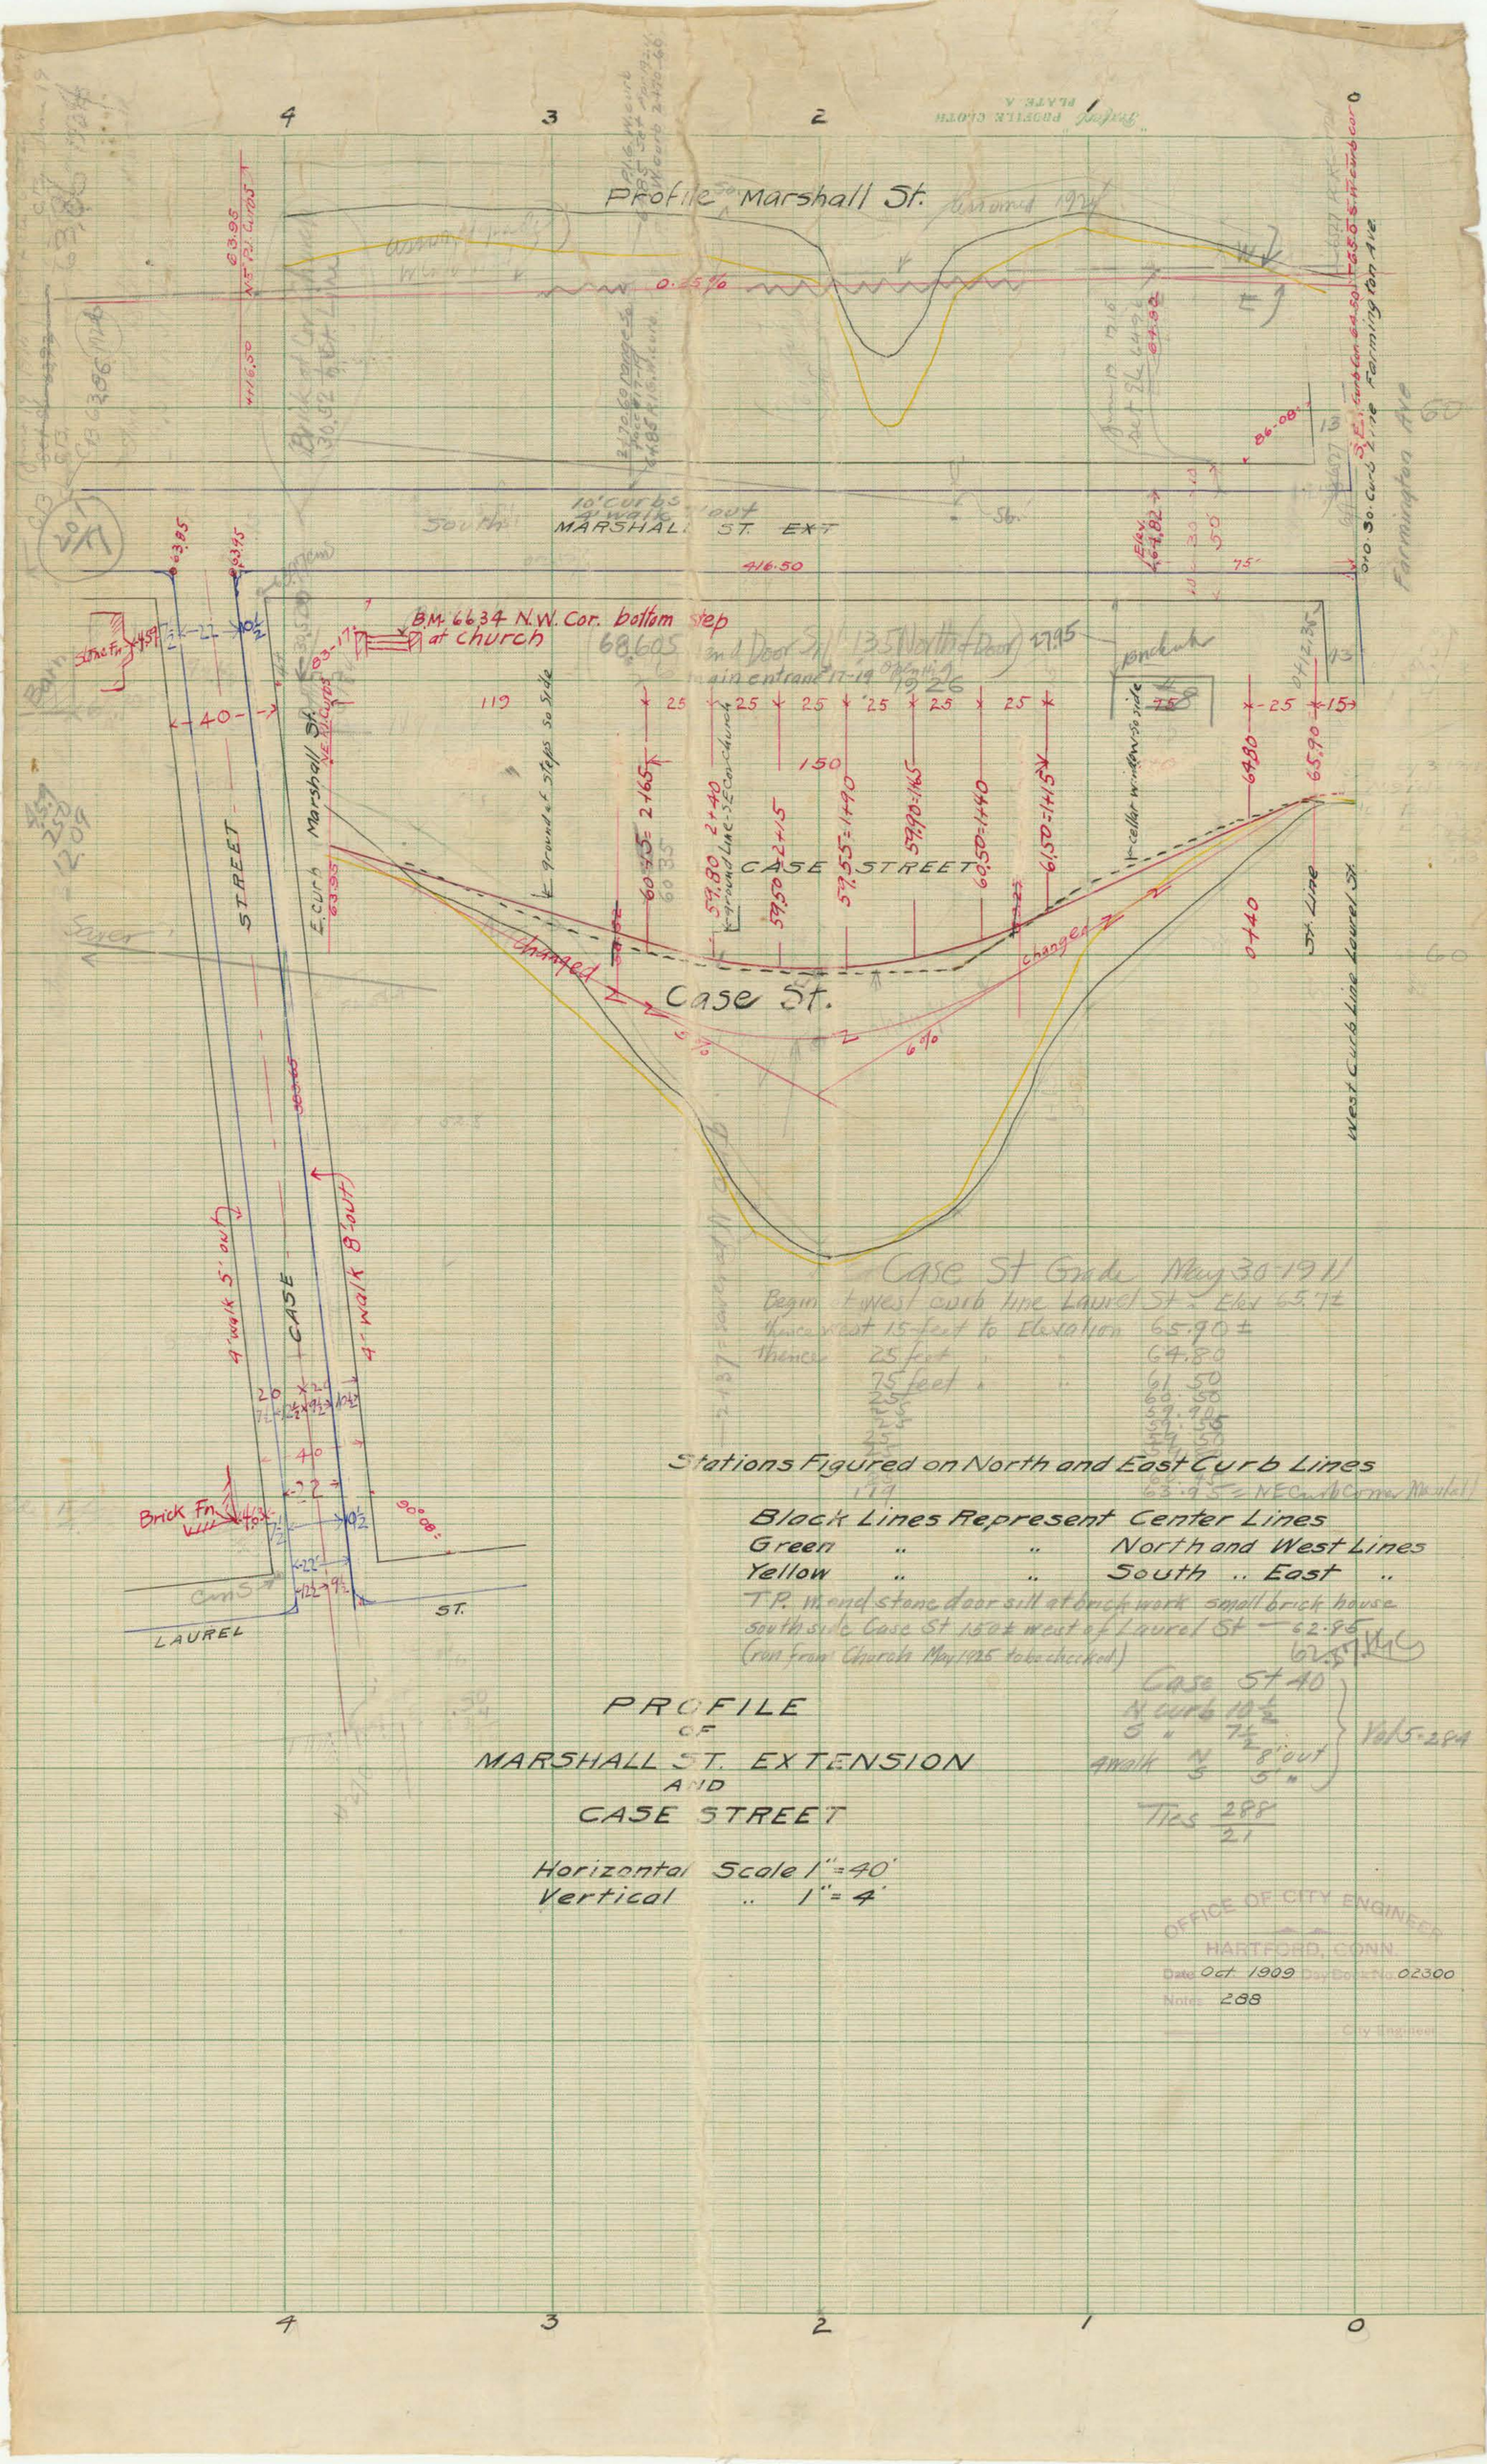
Profile Marshall St.
MARSHALL ST. EXT
B.M. 6634 N.W. Cor. bottom step at church
CASE STREET
Case St.
Marshall St.
STREET
CASE
LAUREL
ST.
West Curb Line Laurel St.
Farmington Ave
Case St Grade May 30 1911
Begin at west curb line Laurel St - Elev 65.7±
thence west 15 feet to Elevation 65.90±
thence 25 feet " " 64.80
75 feet " " 61.50
25 " 60.50
25 " 59.90±
25 " 59.55
25 " 59.50
119 " 63.95 = NE Curb Corner Market
Stations Figured on North and East Curb Lines
Black Lines Represent Center Lines
Green " " North and West Lines
Yellow " " South " East "
T.P. M and stone door sill at brick work small brick house south side Case St 150± west of Laurel St — 62.85
(run from Church May 1925 to be checked) 62.57 MG
Case St 40
N curb 12½
S " 7½
4 walk N 8' out
S 5"
Vol 5 - 284
Ties 288/21
PROFILE
OF
MARSHALL ST. EXTENSION
AND
CASE STREET
Horizontal Scale 1" = 40'
Vertical " 1" = 4'
OFFICE OF CITY ENGINEER
HARTFORD, CONN.
Date Oct 1909 Dwg Book No. 02300
Note 288
City Engineer