
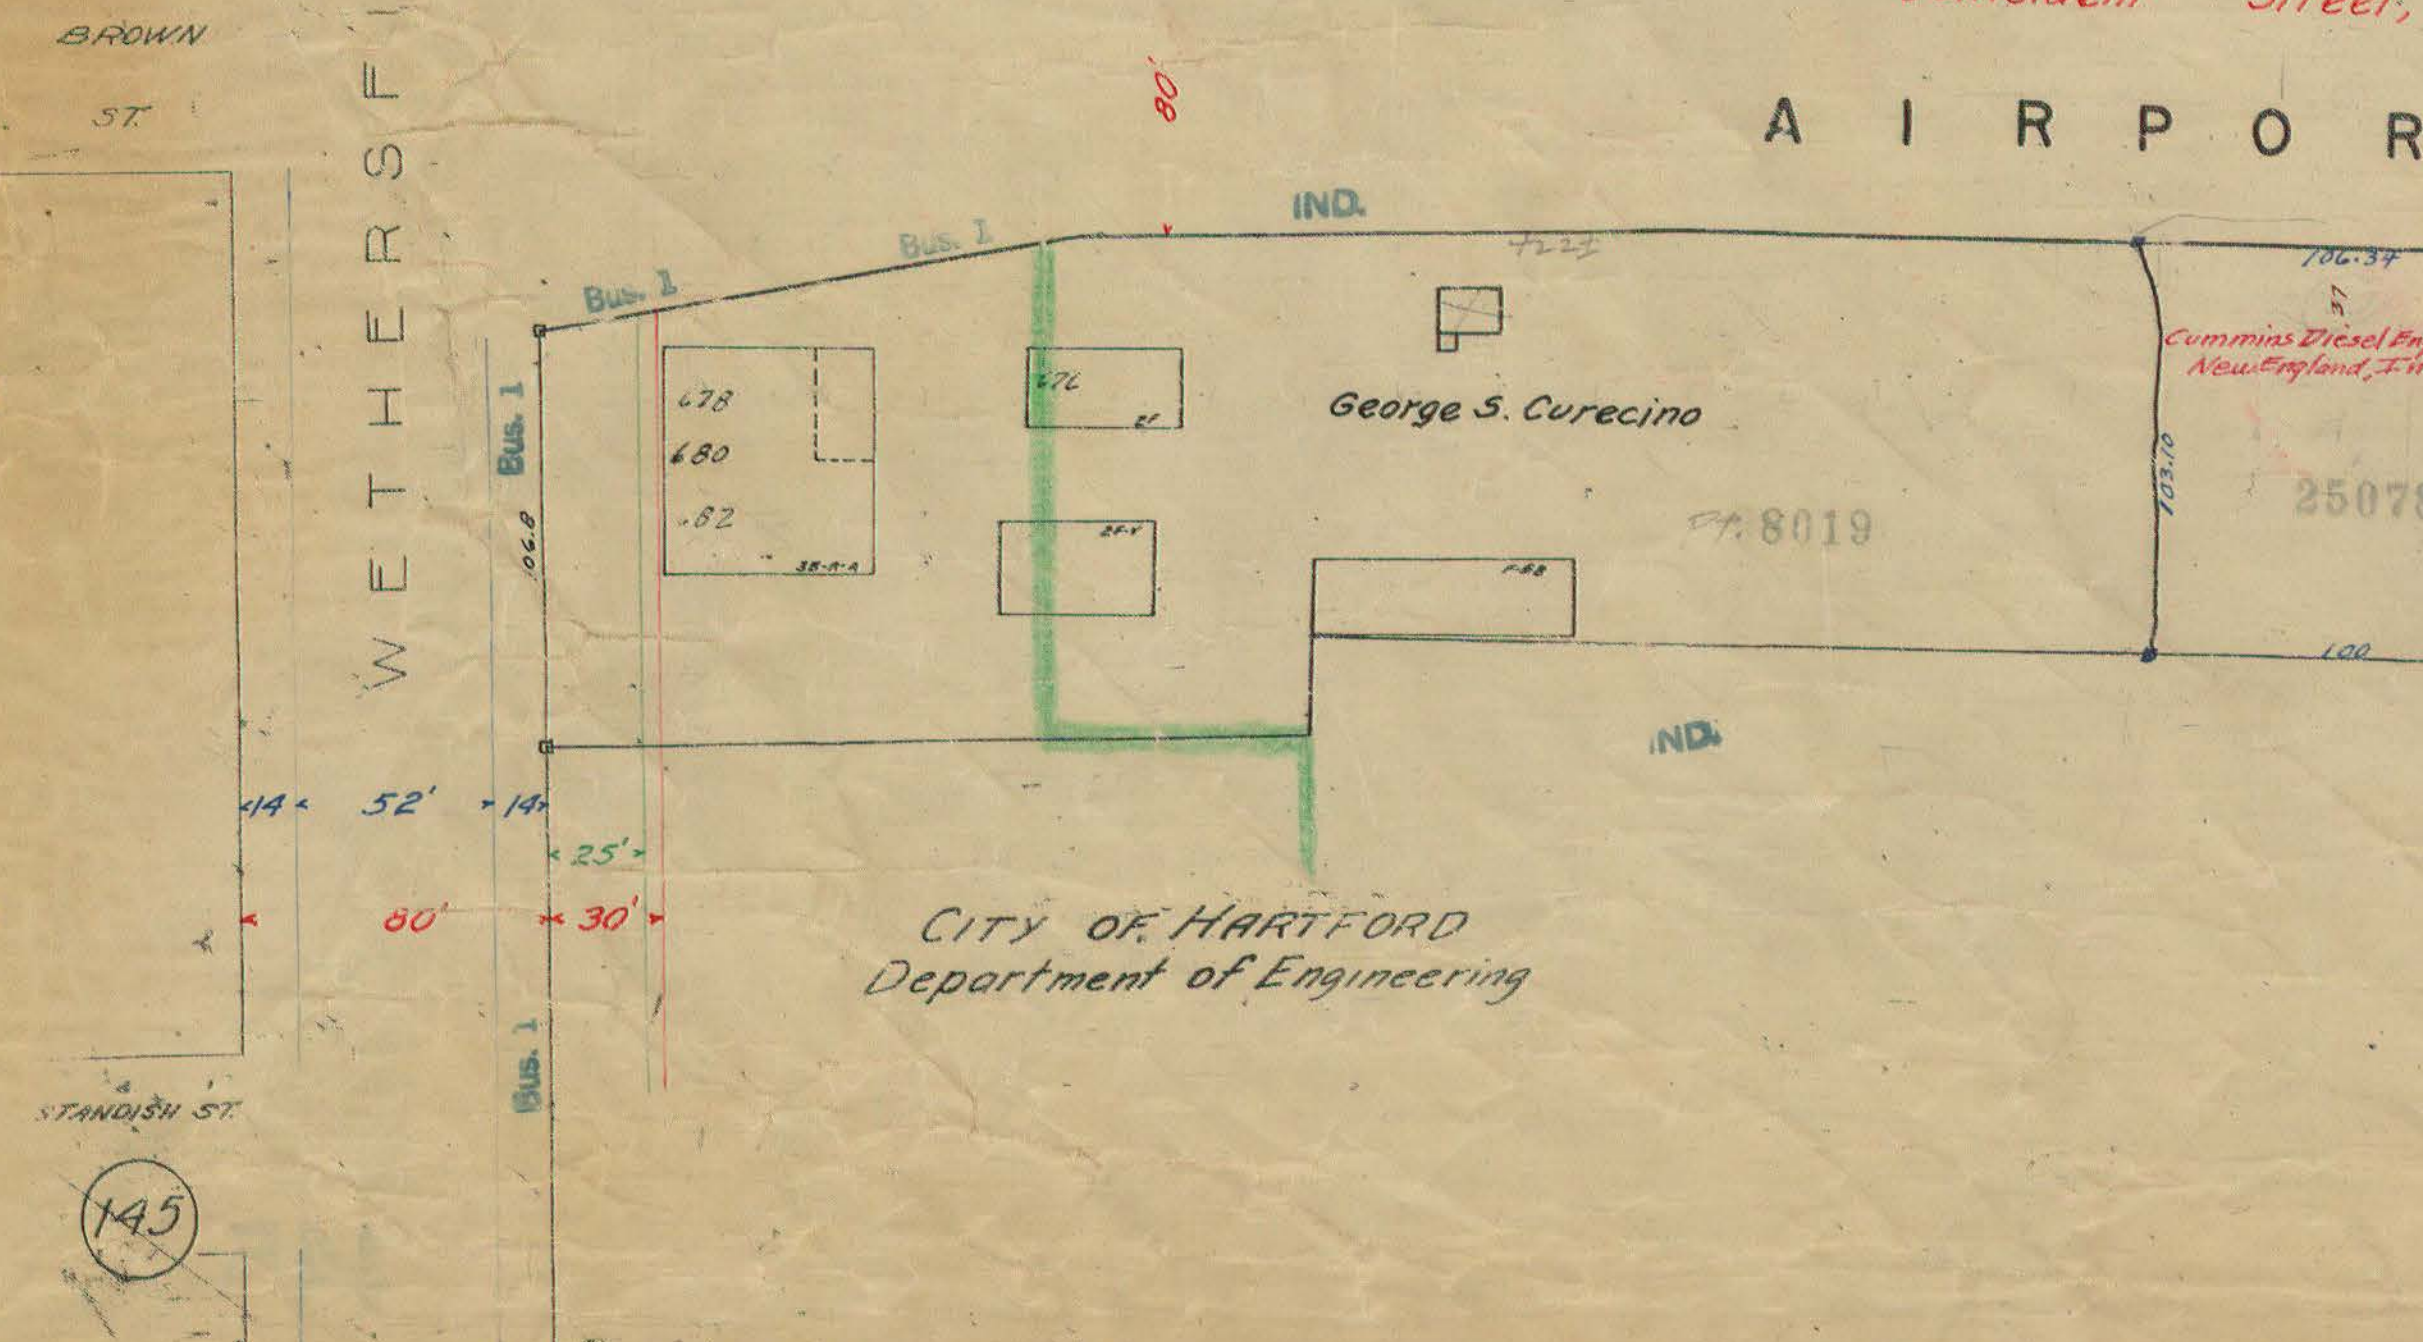


See Sheet #107

AVENUE

Building and Veranda Lines of Dec. 8, 1913
Street Lines of Apr. 2, 1873

WETHERSFIELD

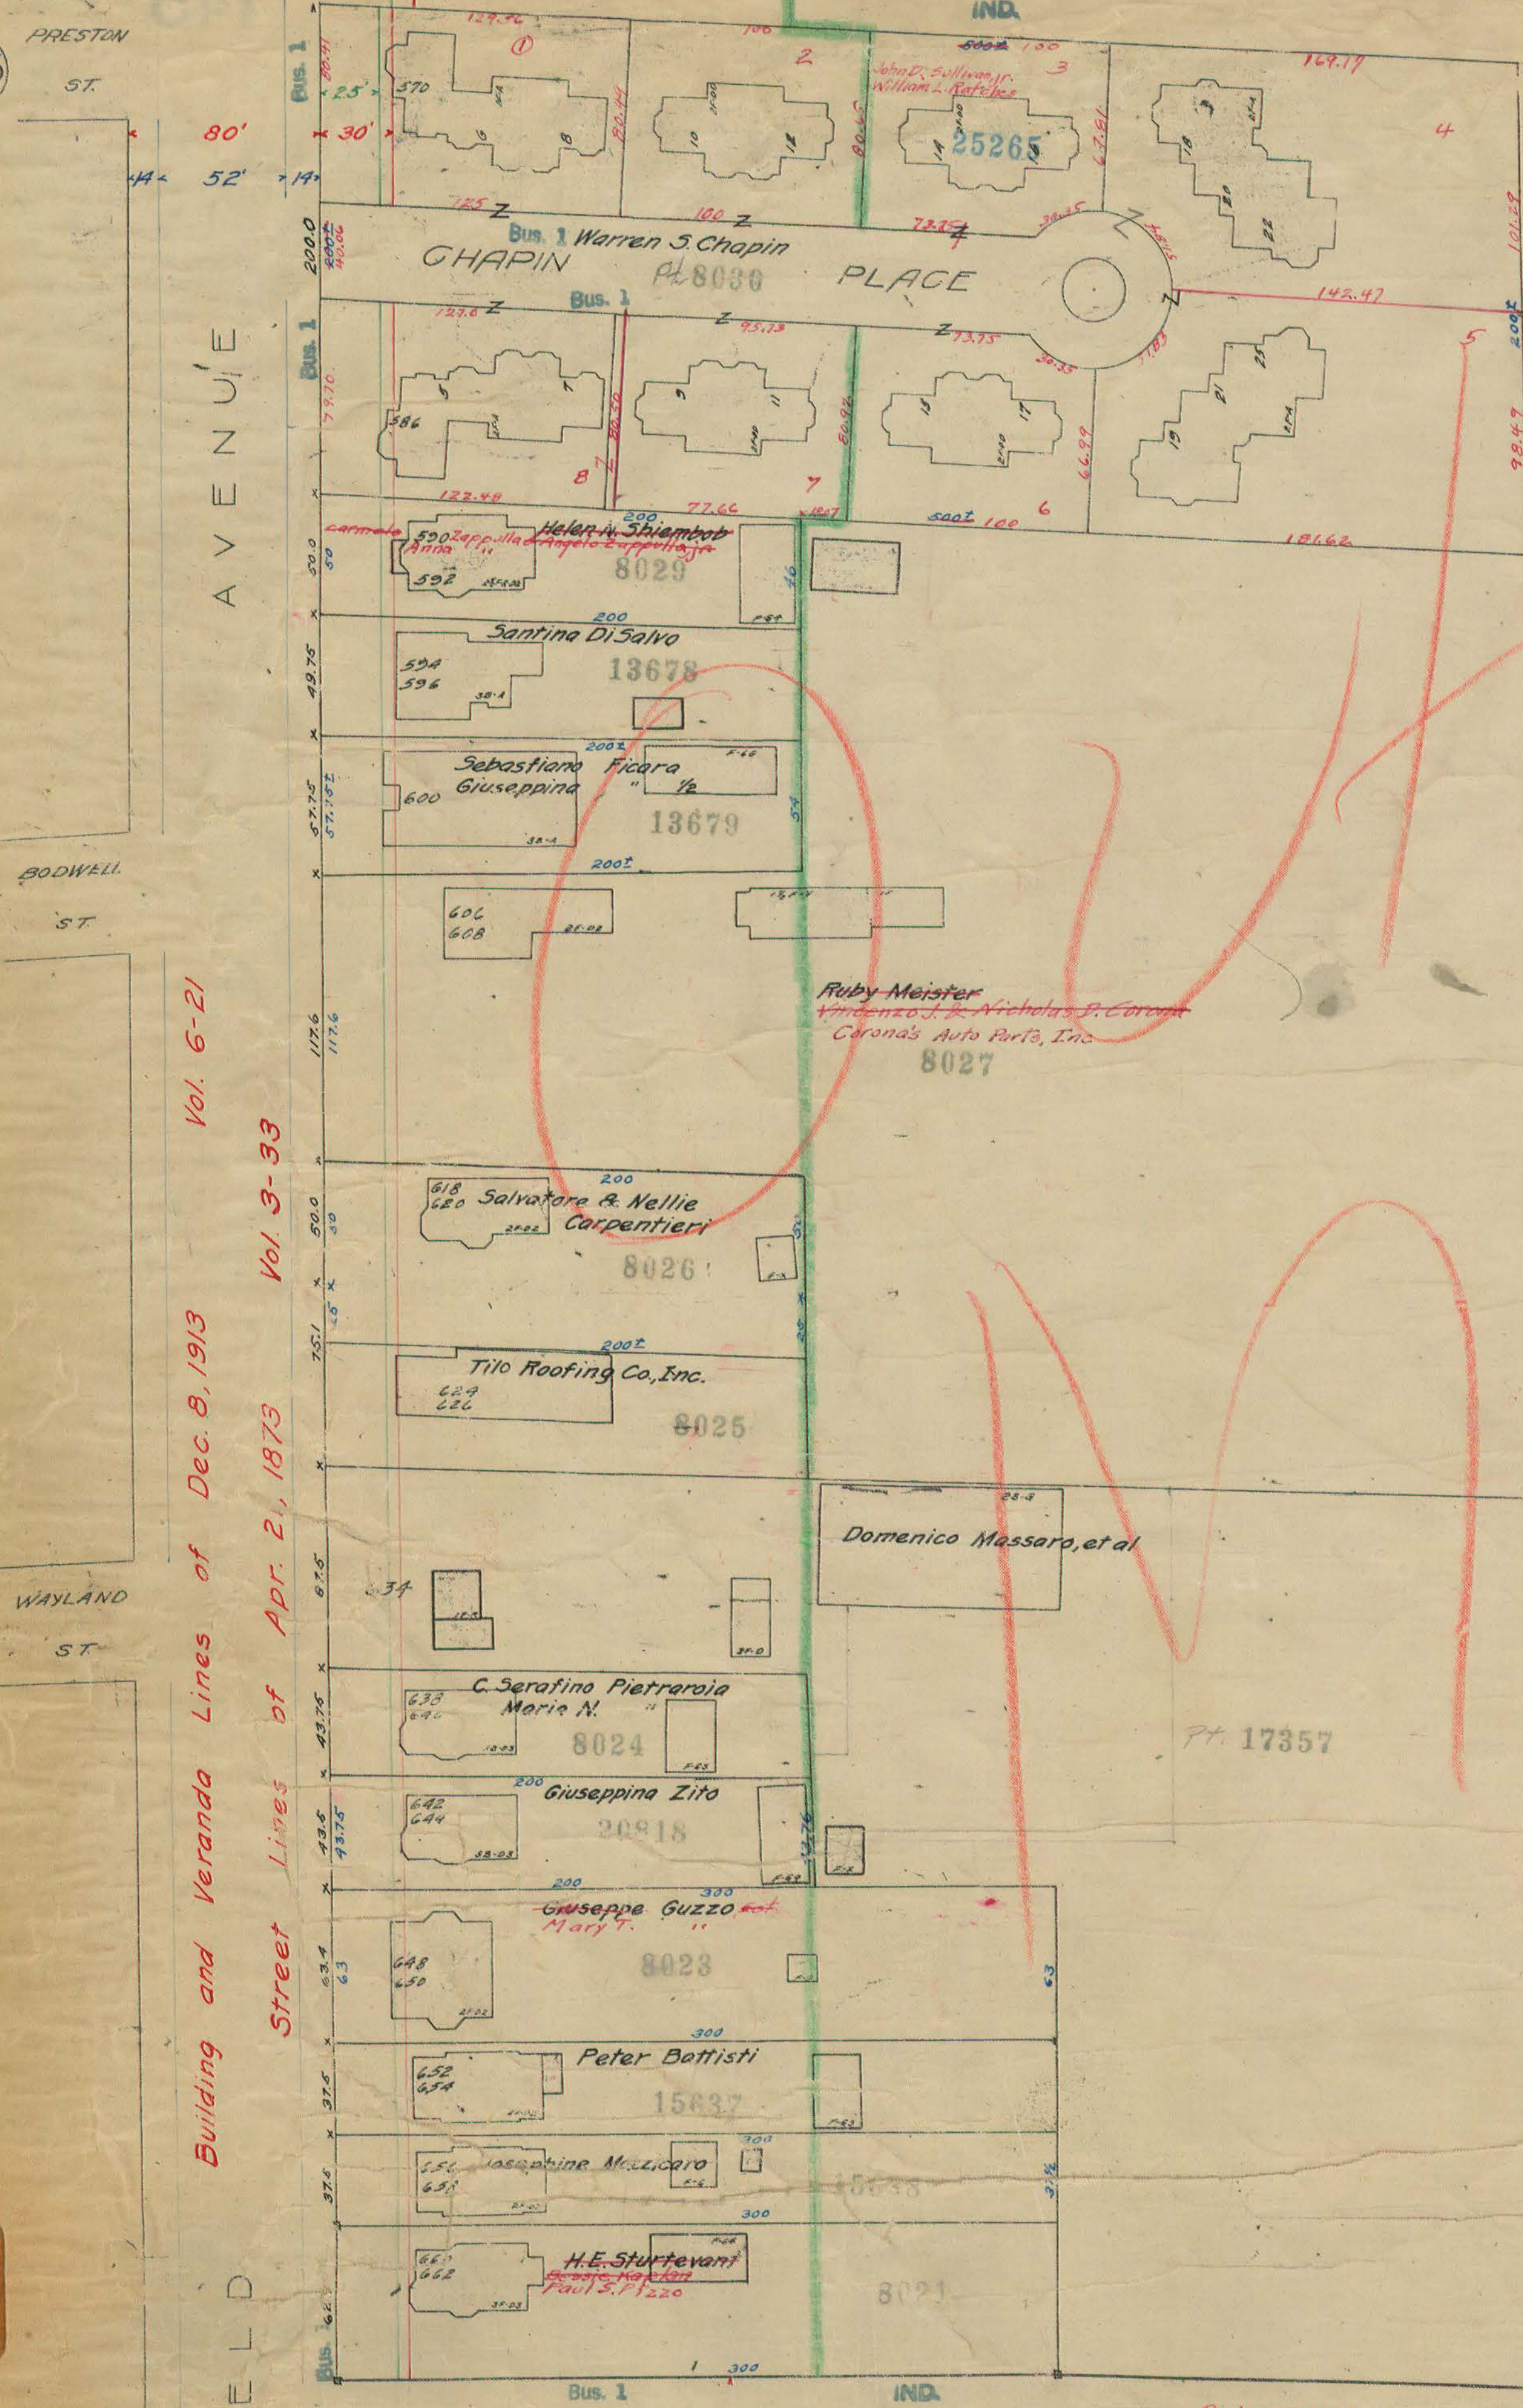


Coincident Street, Building and Veranda Lines of Dec. 14, 1942

A I R P O R T


Vol. 7-364

R O A D

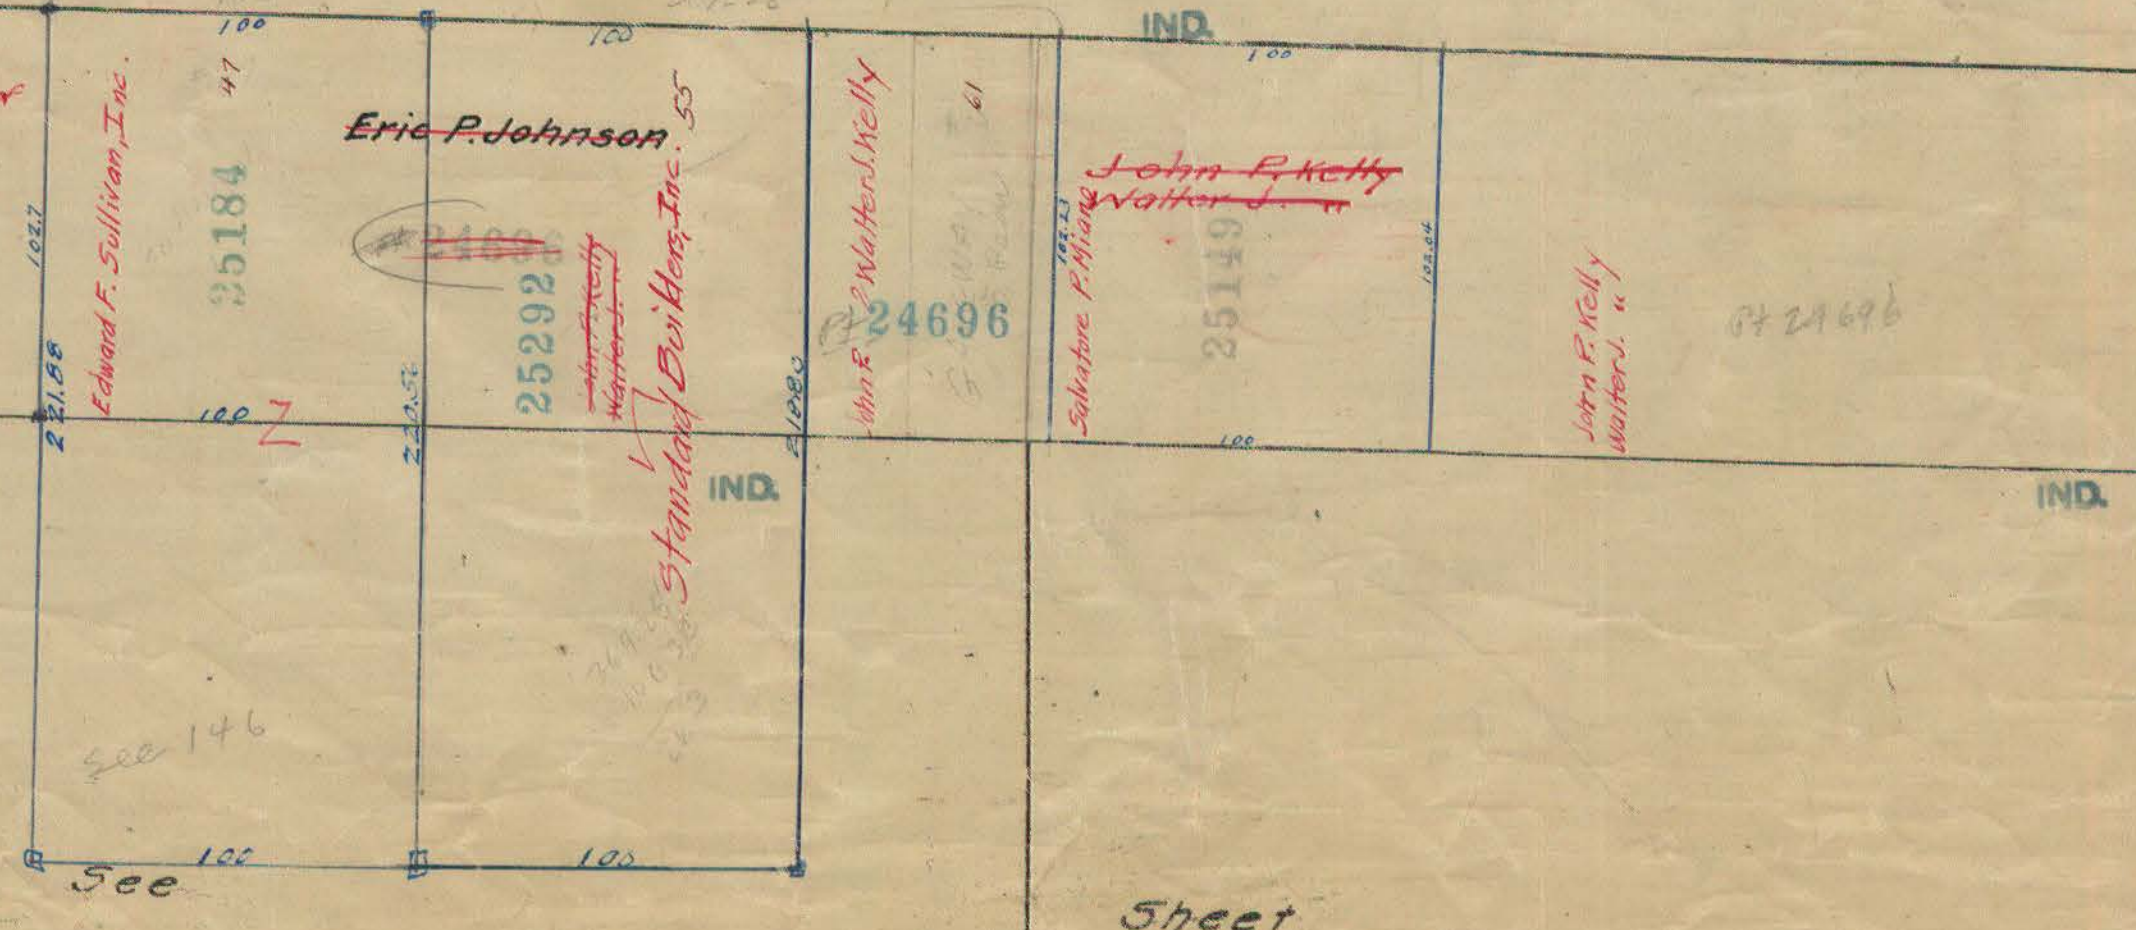

Sheet

WALK of SERVICE

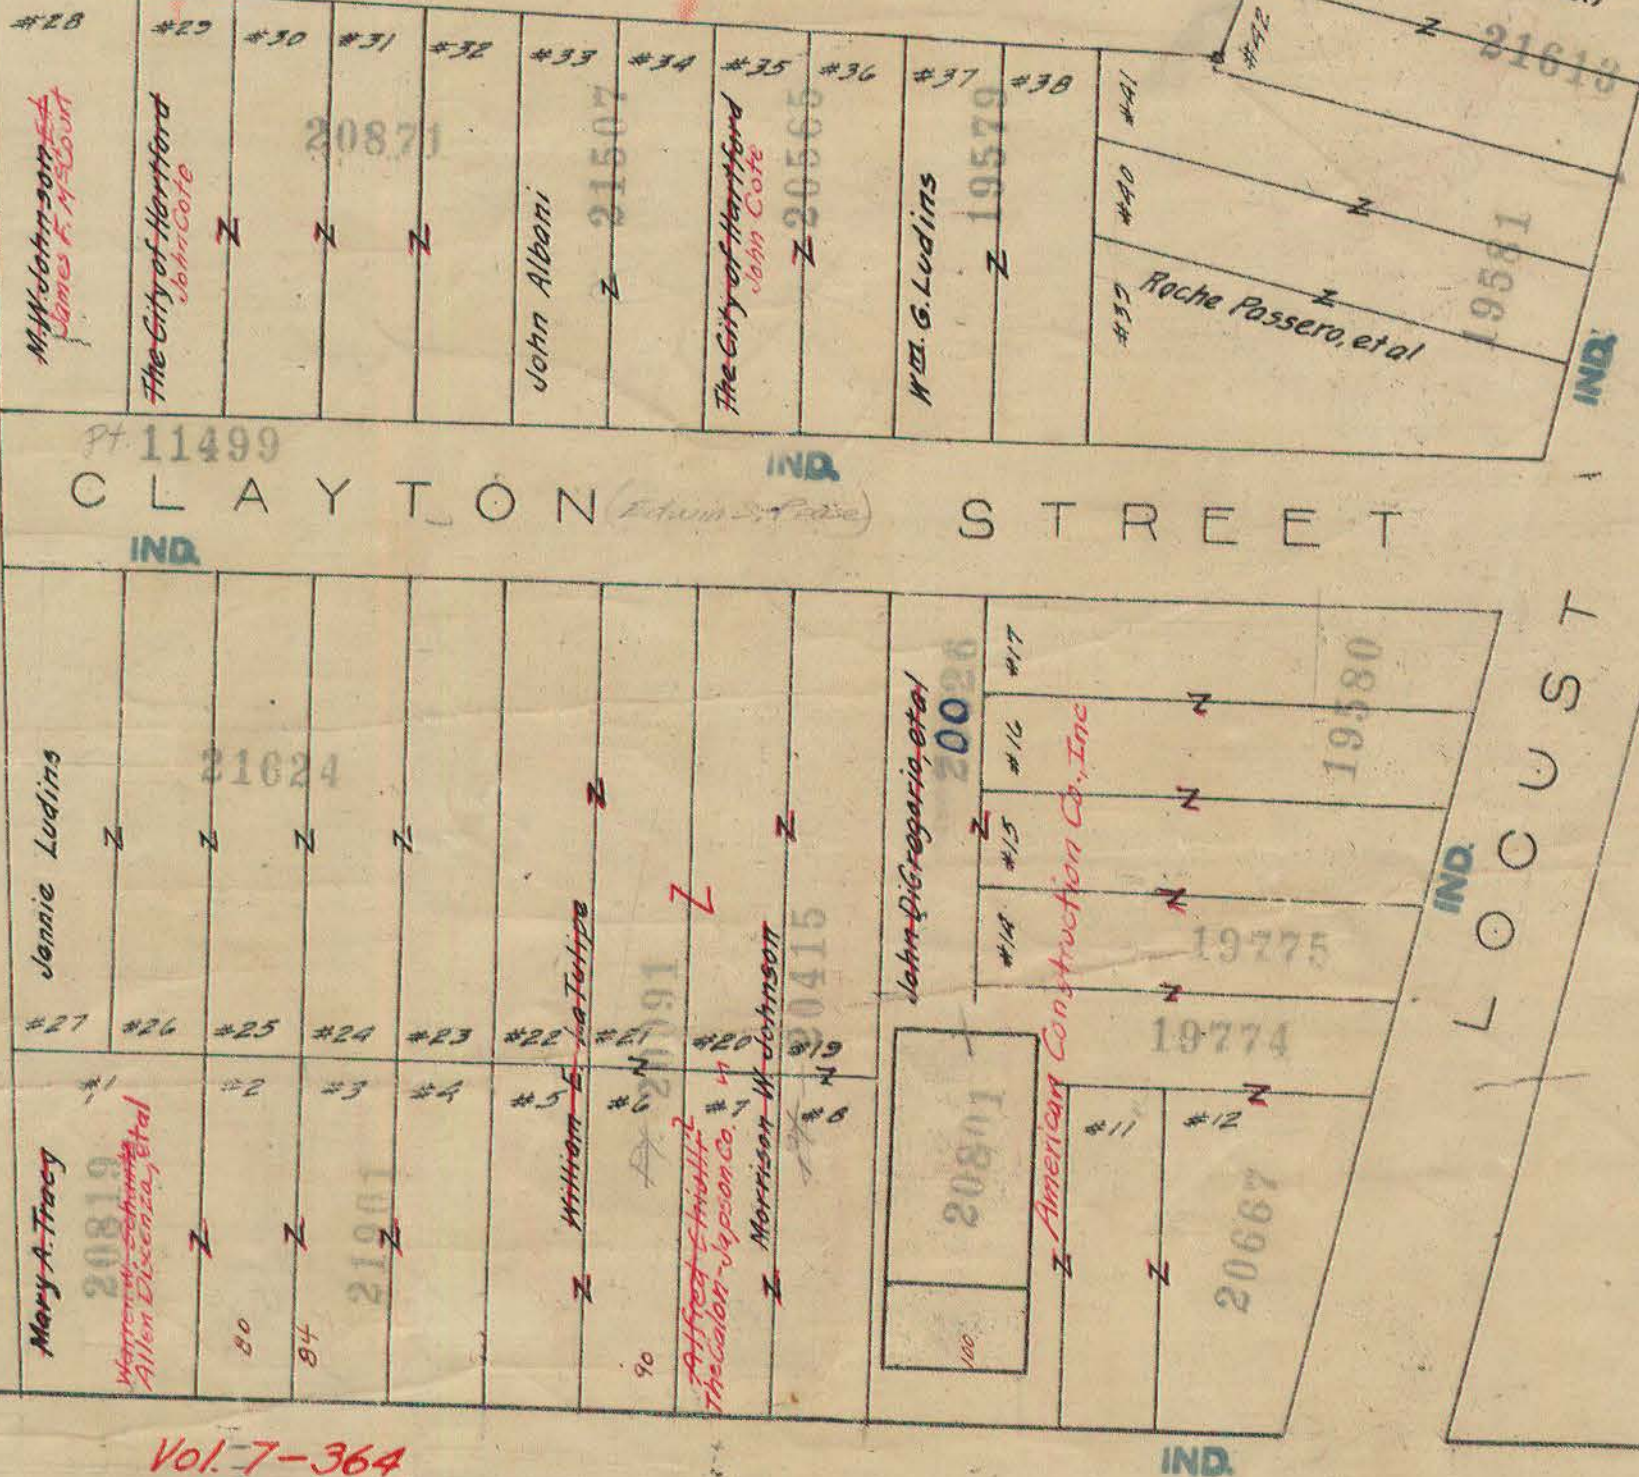

All unmarked lots owned by Morrissey-Hodgson

RAILROAD

Sheet