


CITY OF HARTFORD
Department of Engineering

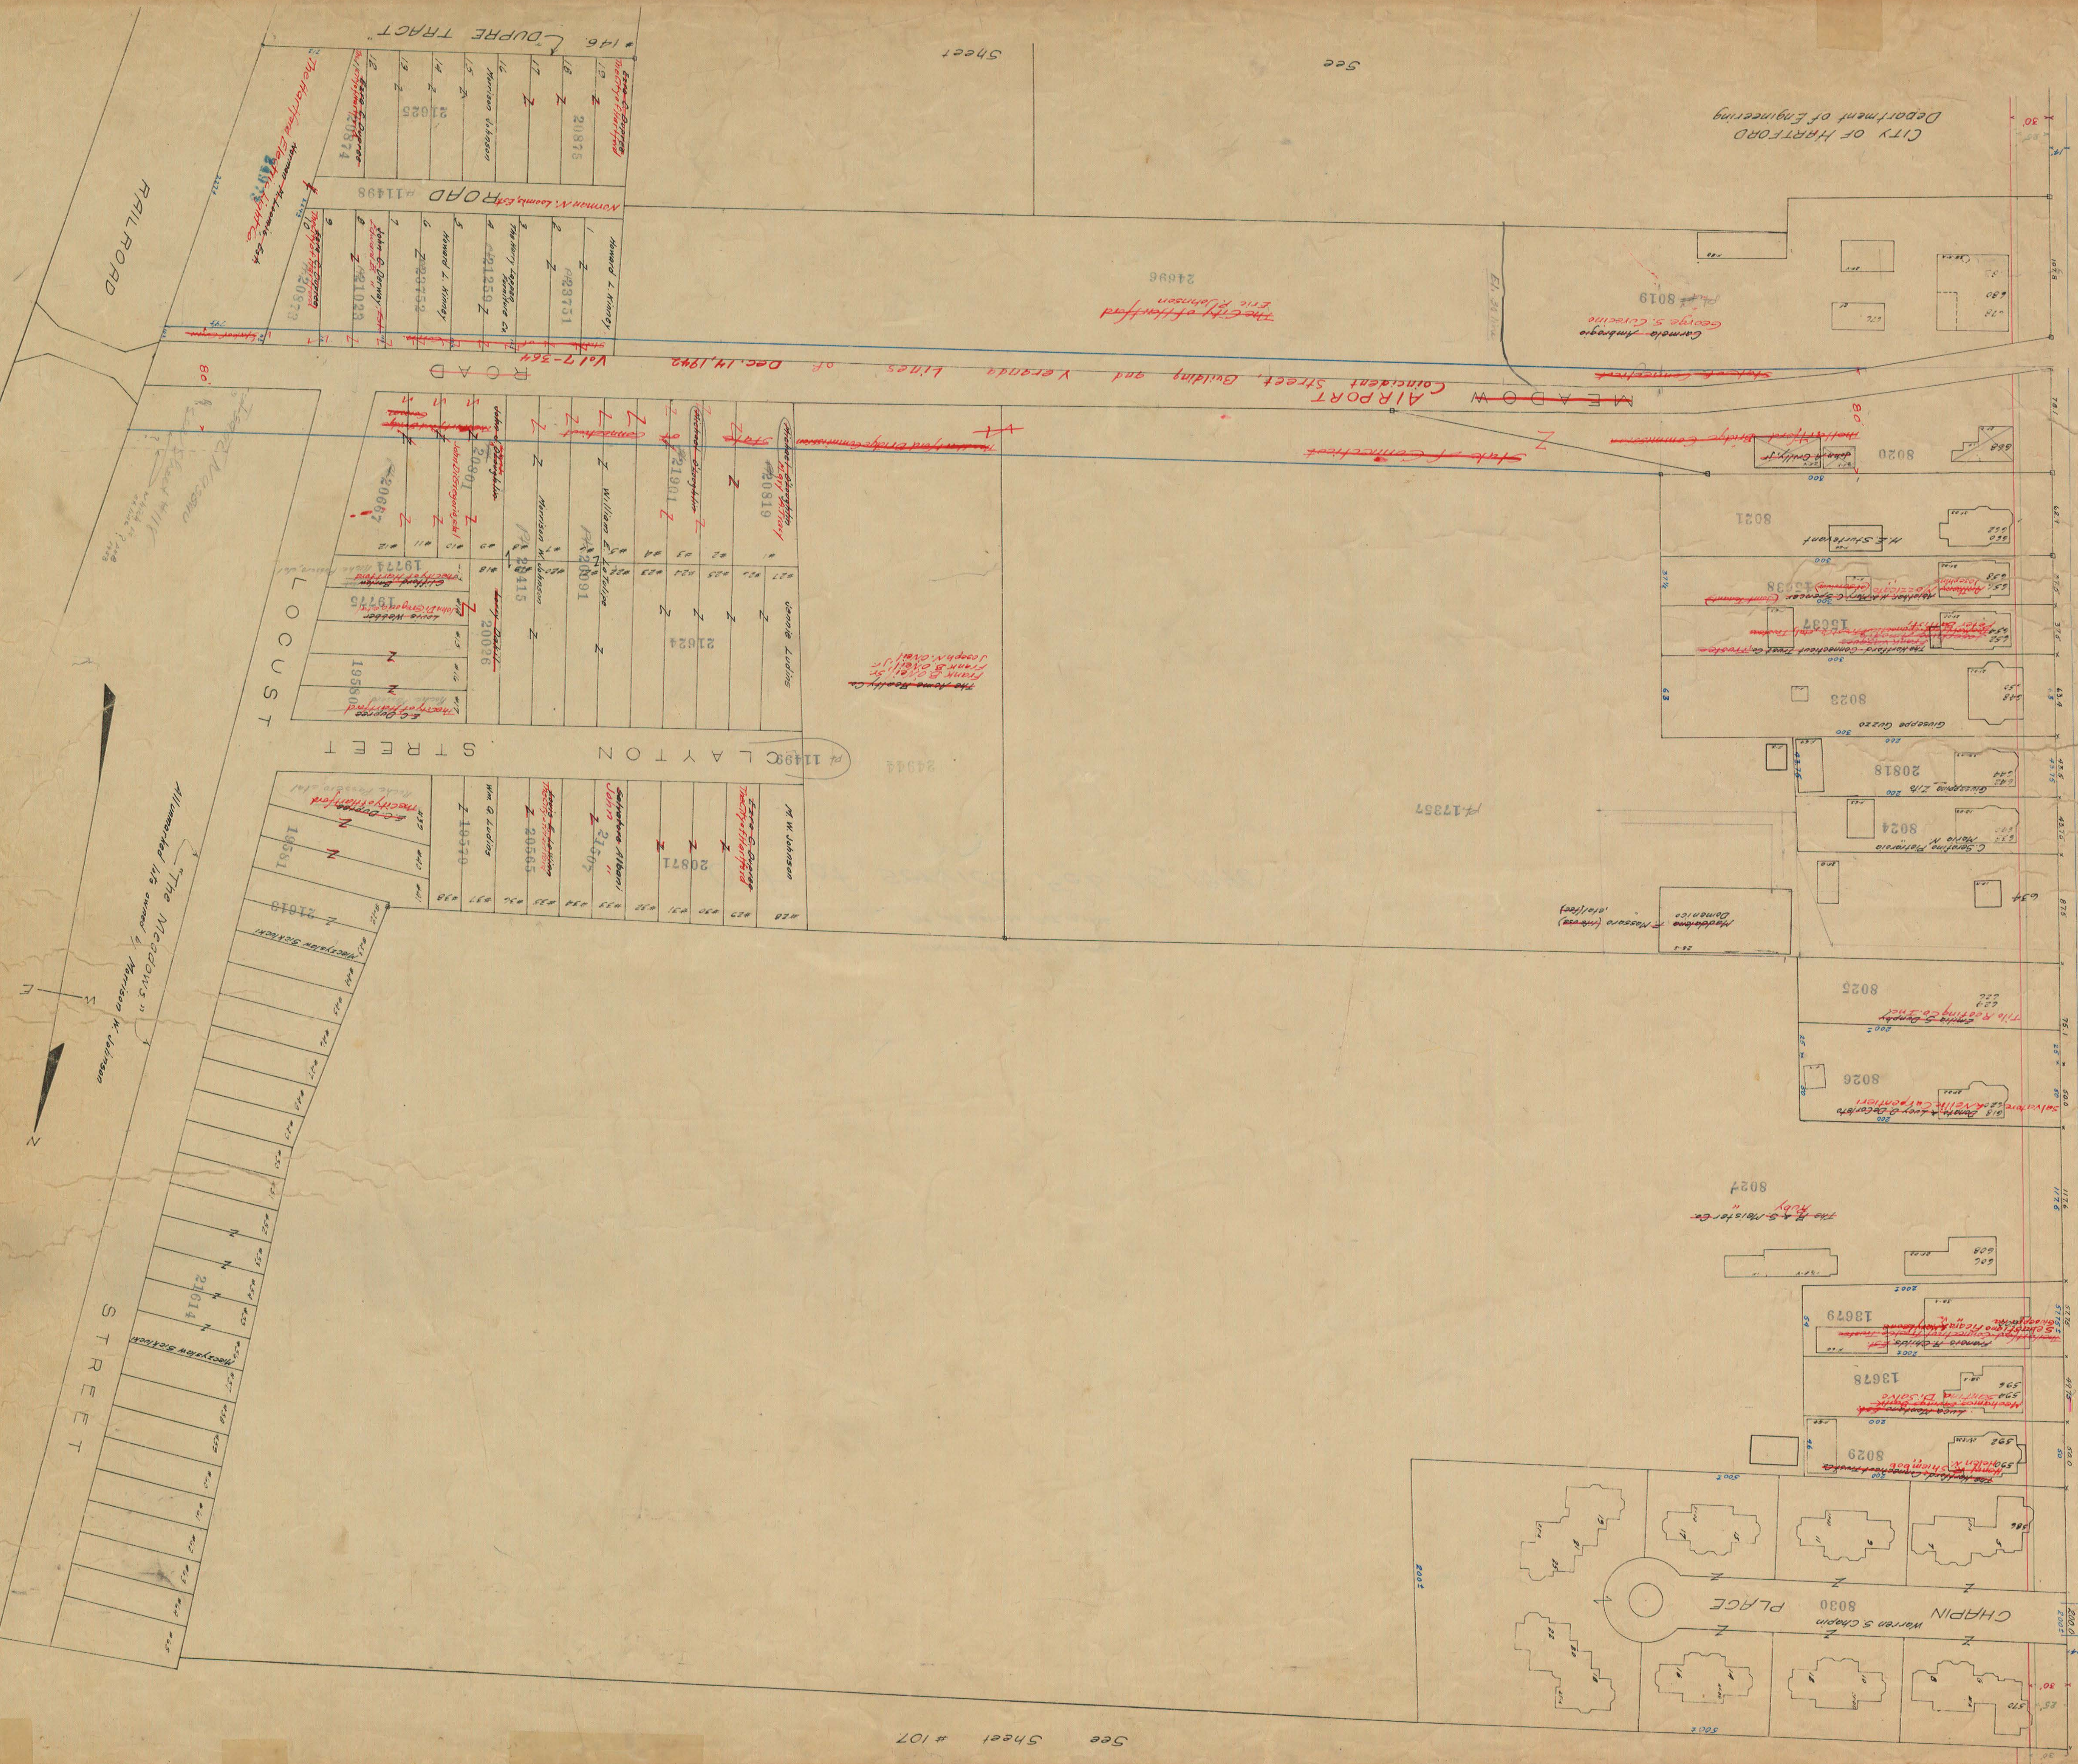

See Sheet #107

See

Sheet

#108

145

145