


Out of Service

See Sheet #107

Oct 10-1936

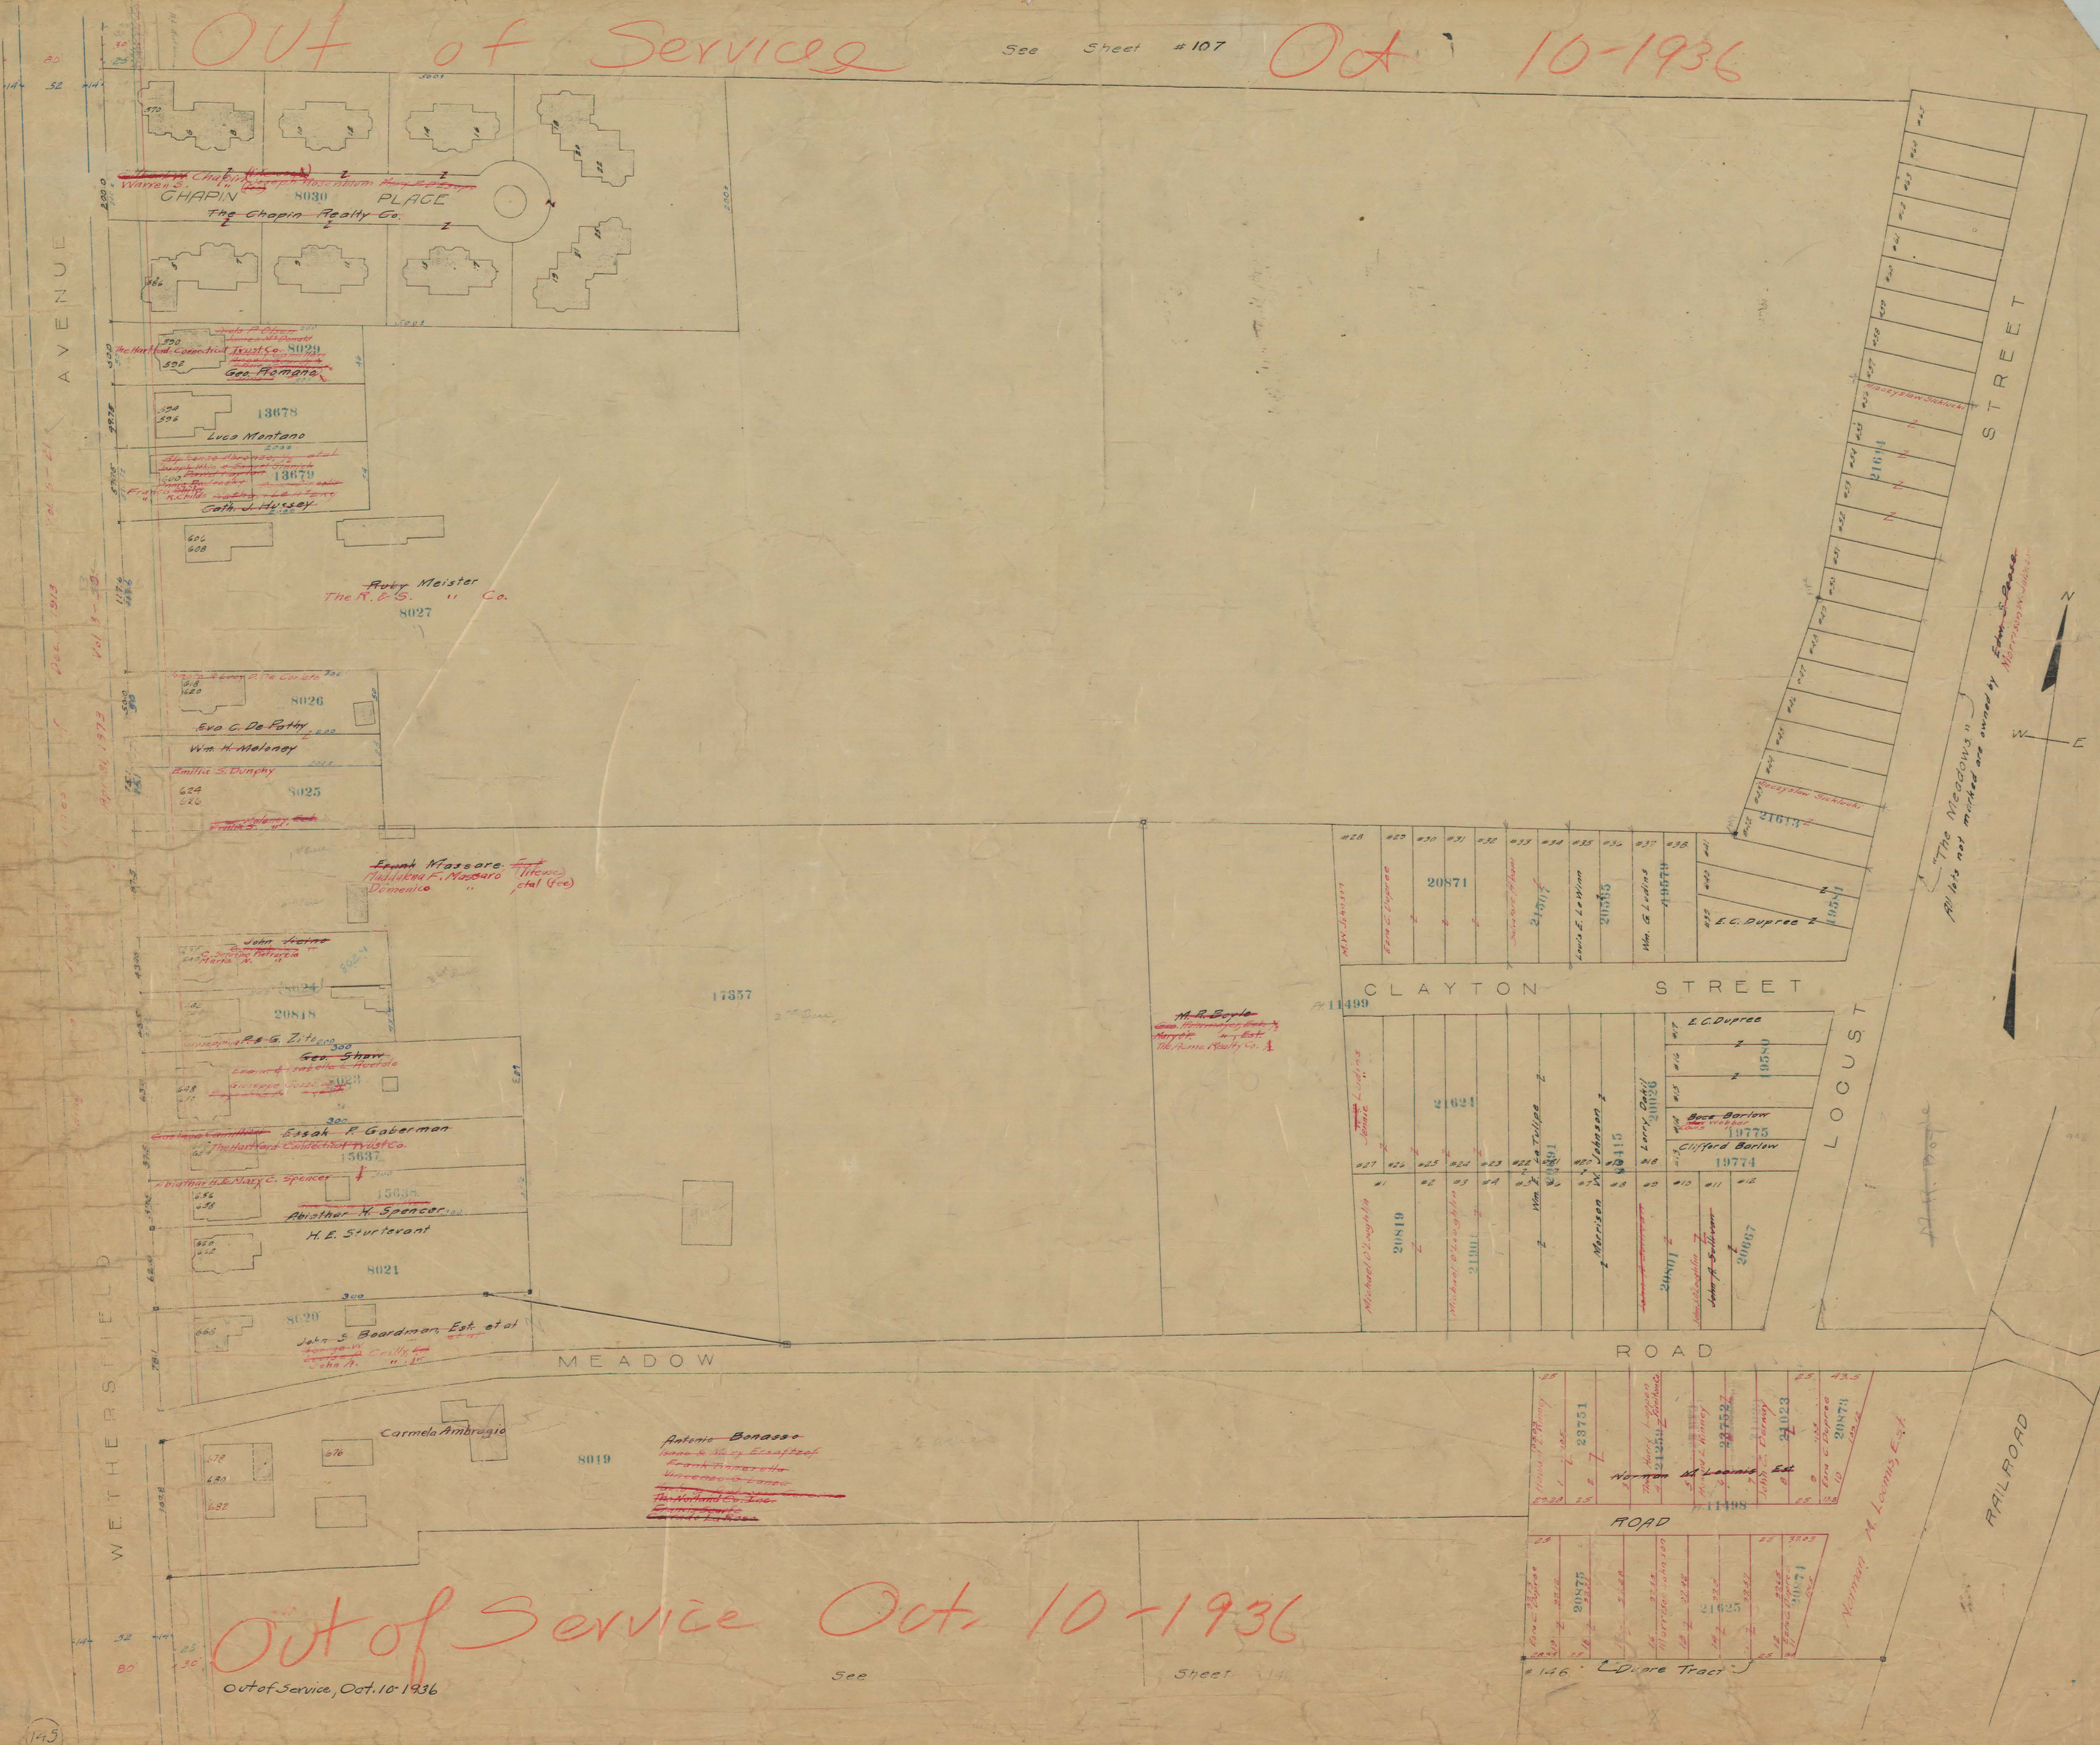

Out of Service Oct. 10-1936

Out of Service, Oct. 10-1936

See

Sheet

146. "Dupre Tract"