


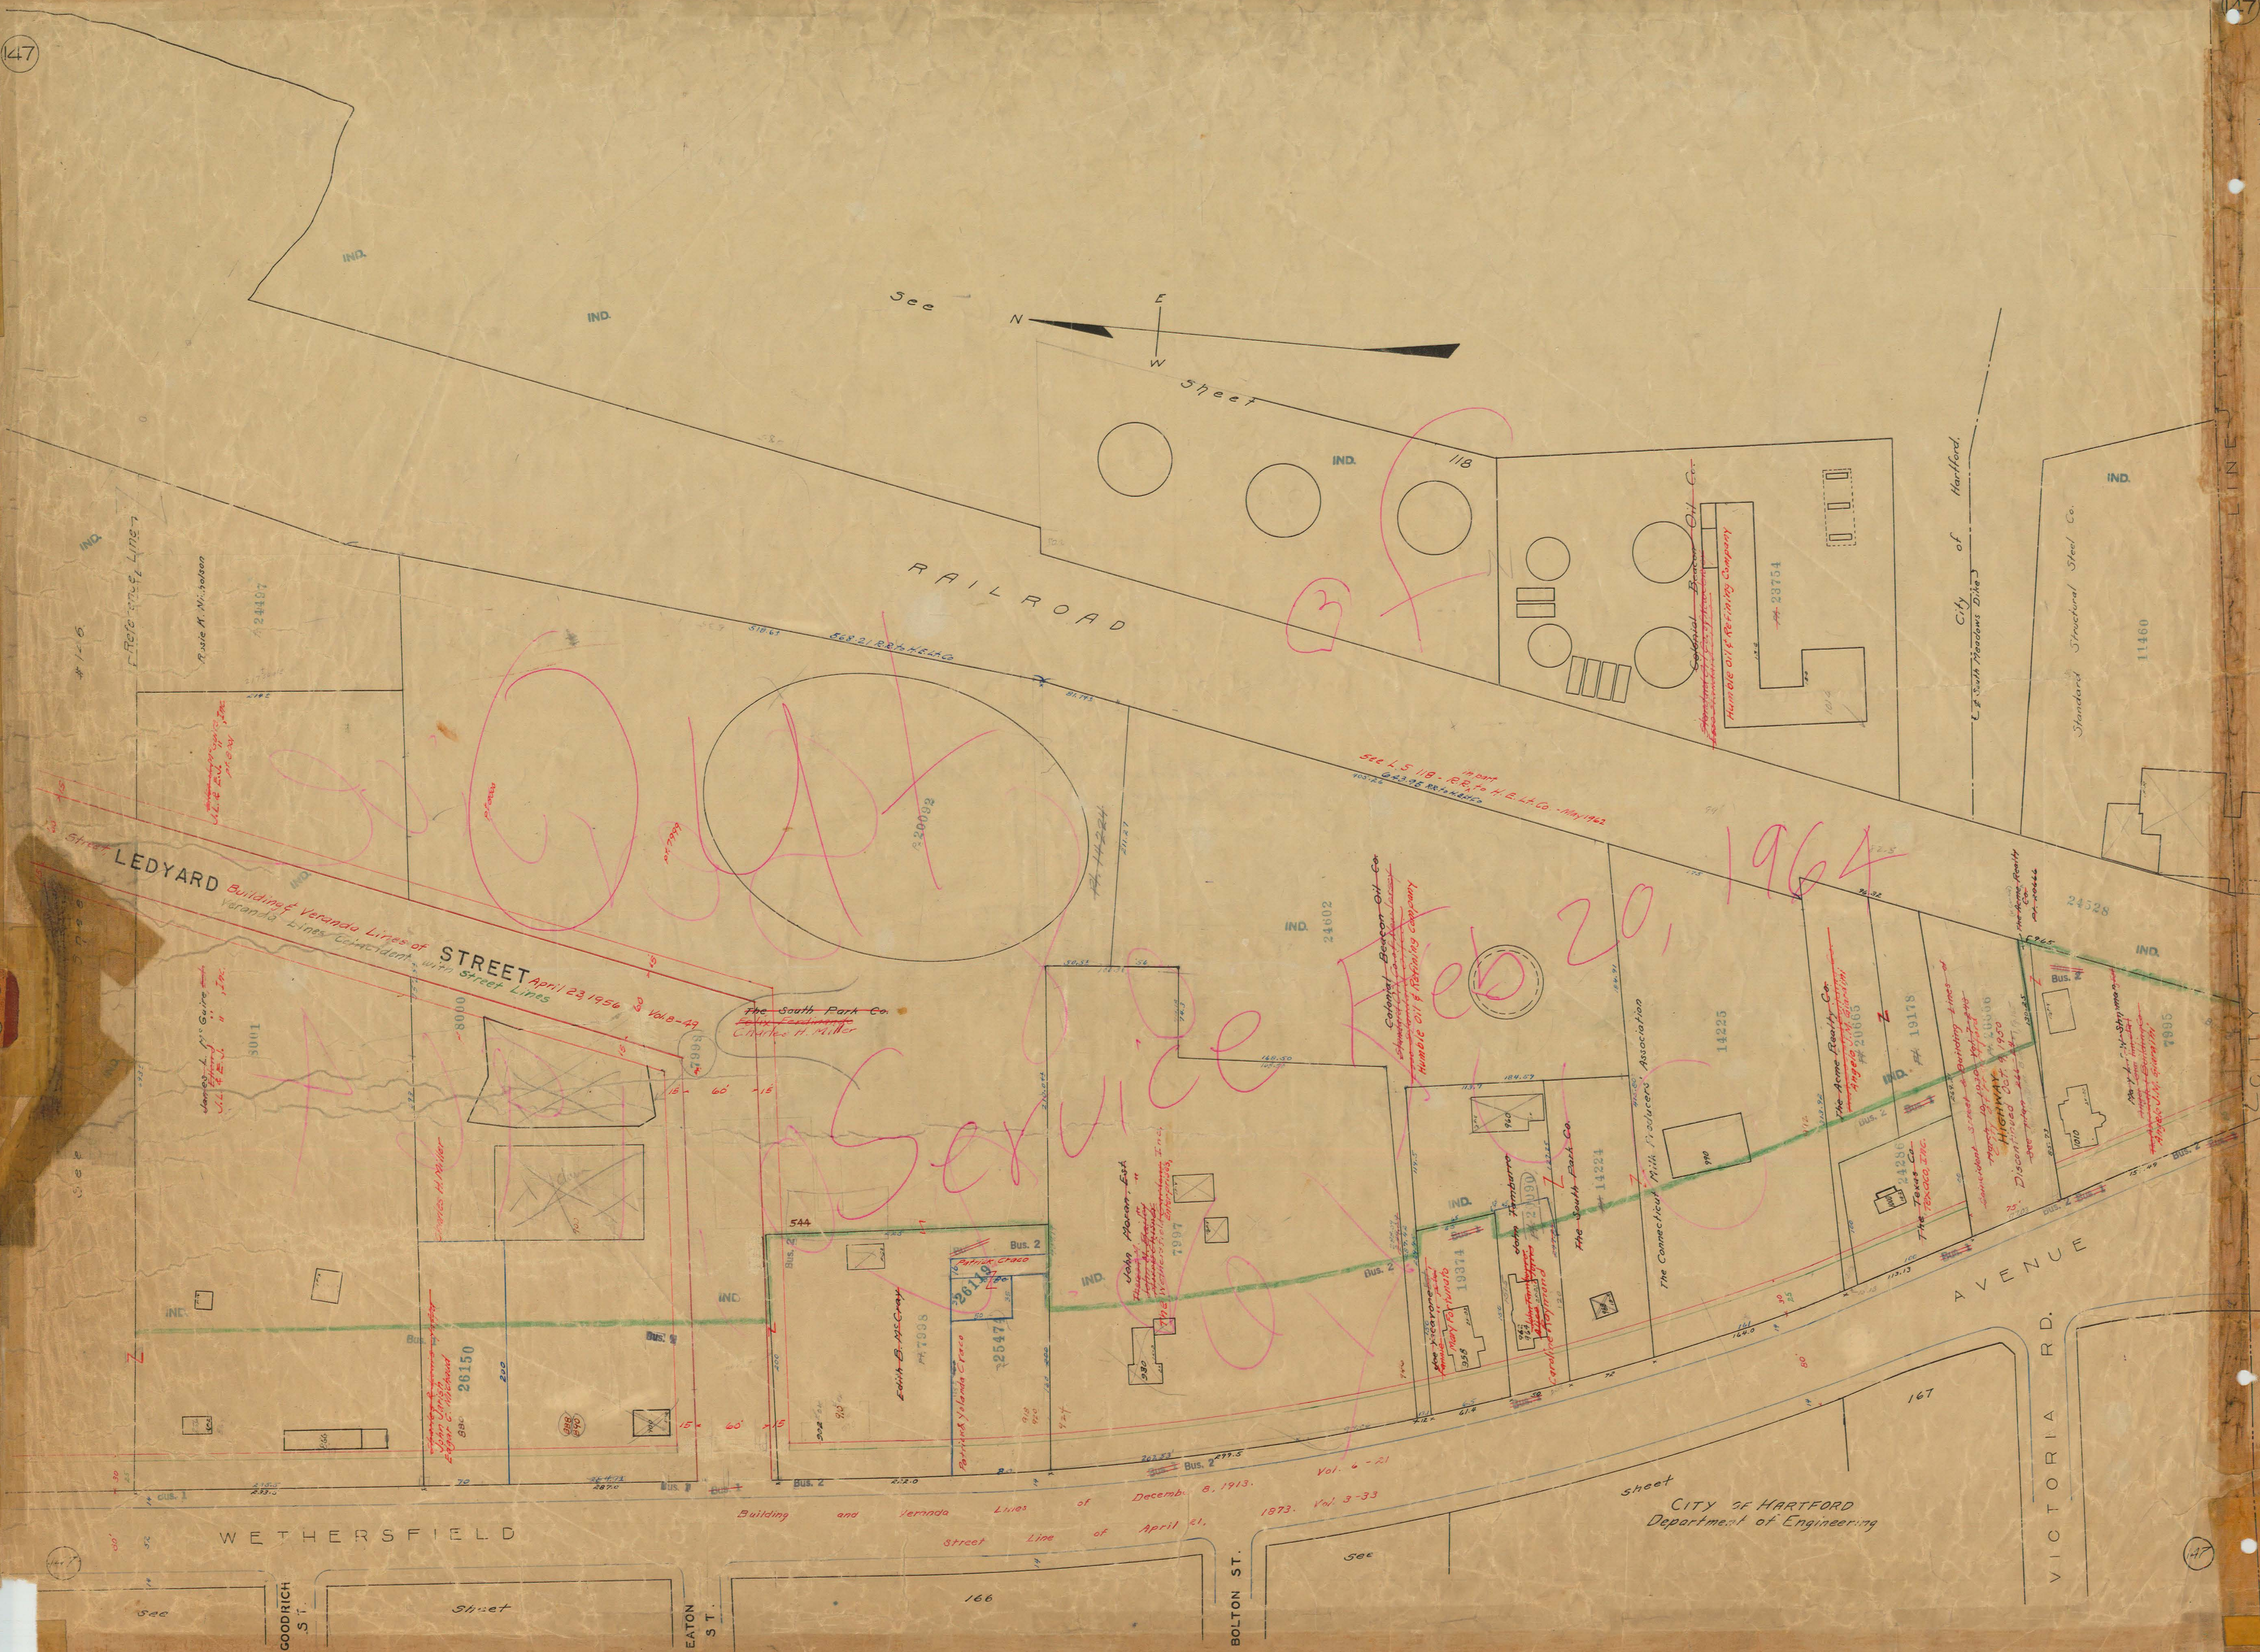

WETHERSFIELD

CITY OF HARTFORD
Department of Engineering

VICTORIA RD.

BOLTON ST.

EATON ST.

GOODRICH ST.