


Sept. 16-1938

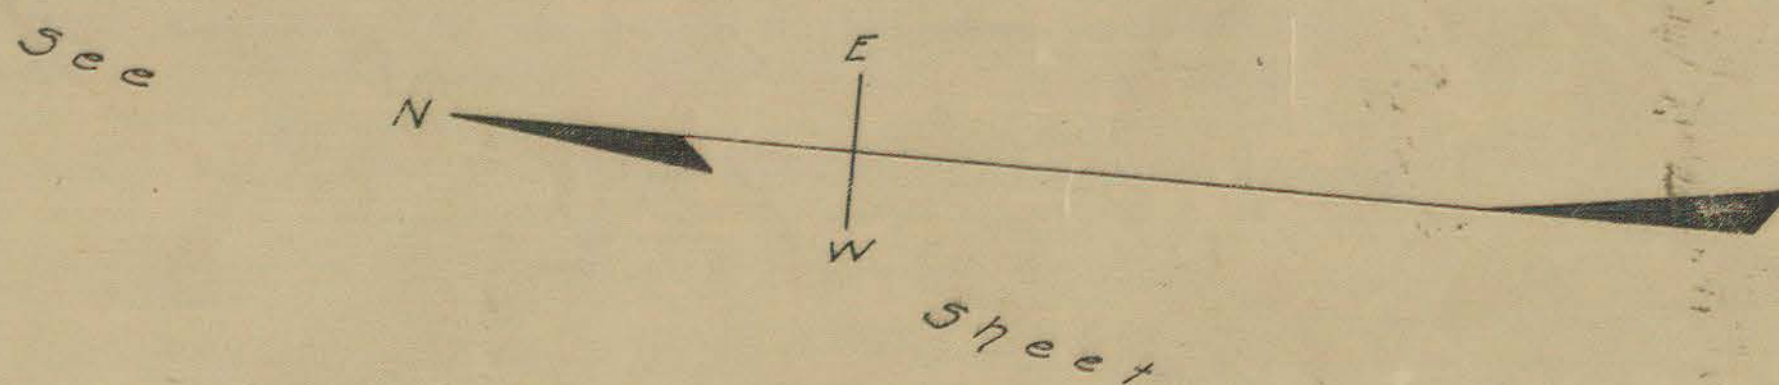

Out of Service, Sept. 16-1938

Street Line

Out of Service

Sept. 16-1938