


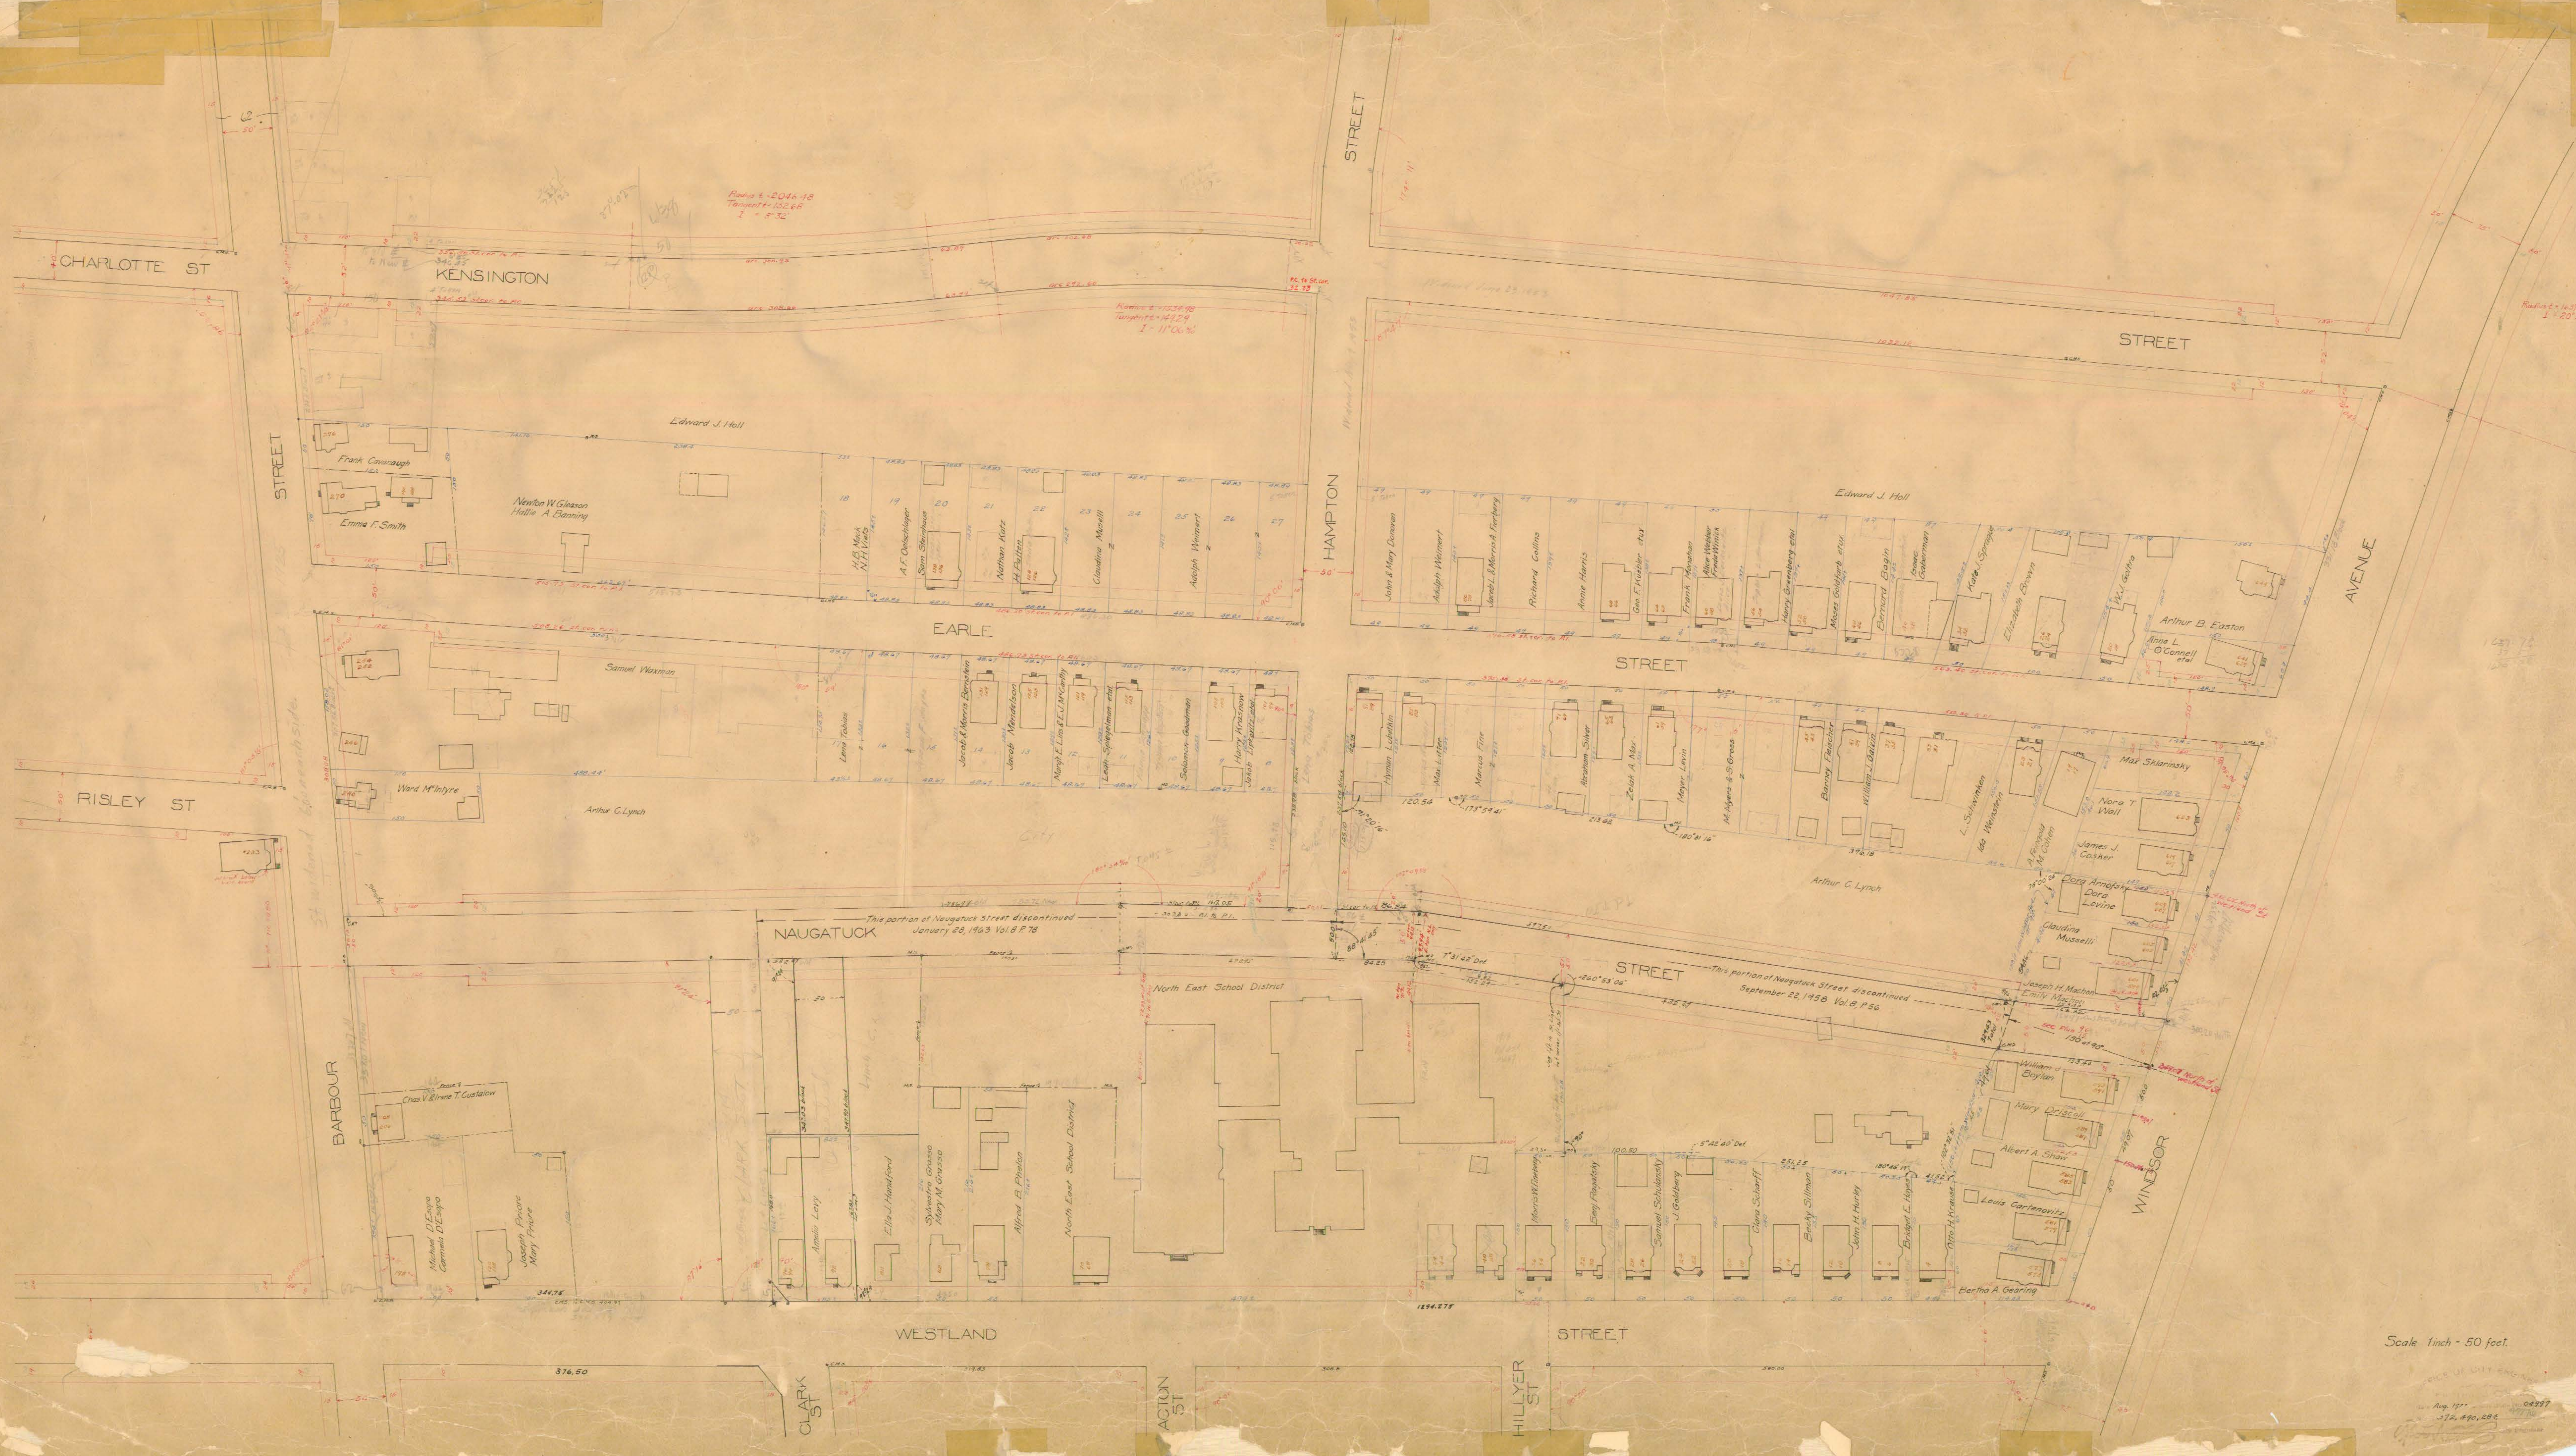

Scale 1 inch = 50 feet.

Aug 1911
276,490,204