


OFFICE OF CITY ENGINEER
HARTFORD, CONN.
Map No. 1921
Date Dec. 1921
Scale 1" = 50'

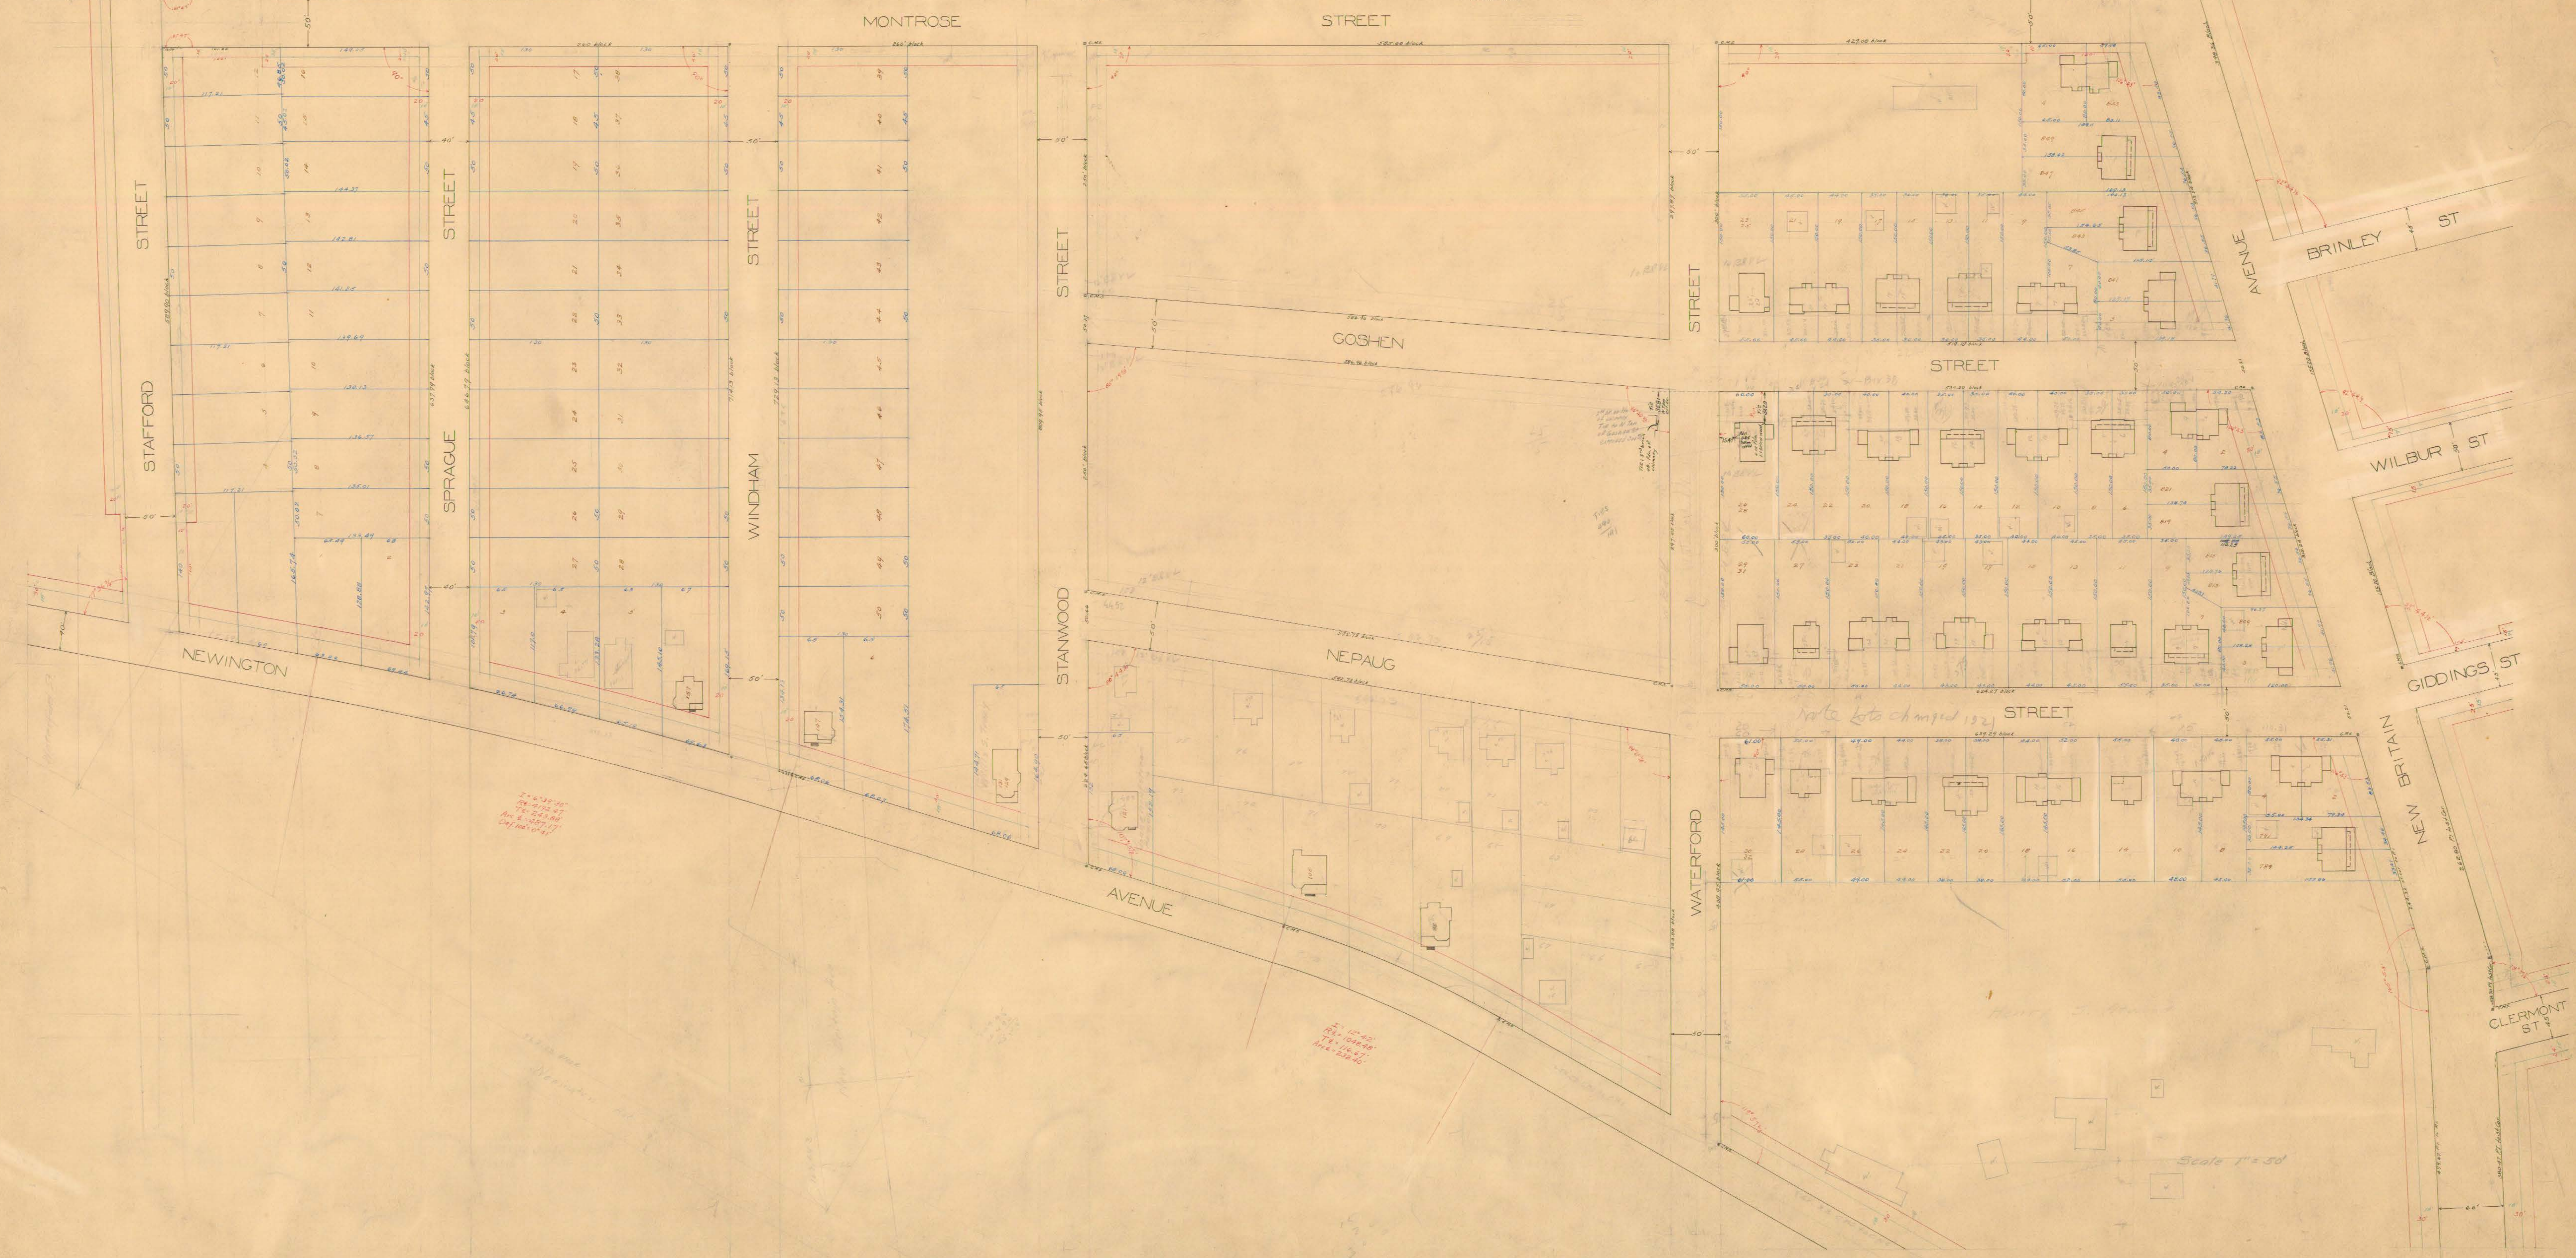


