


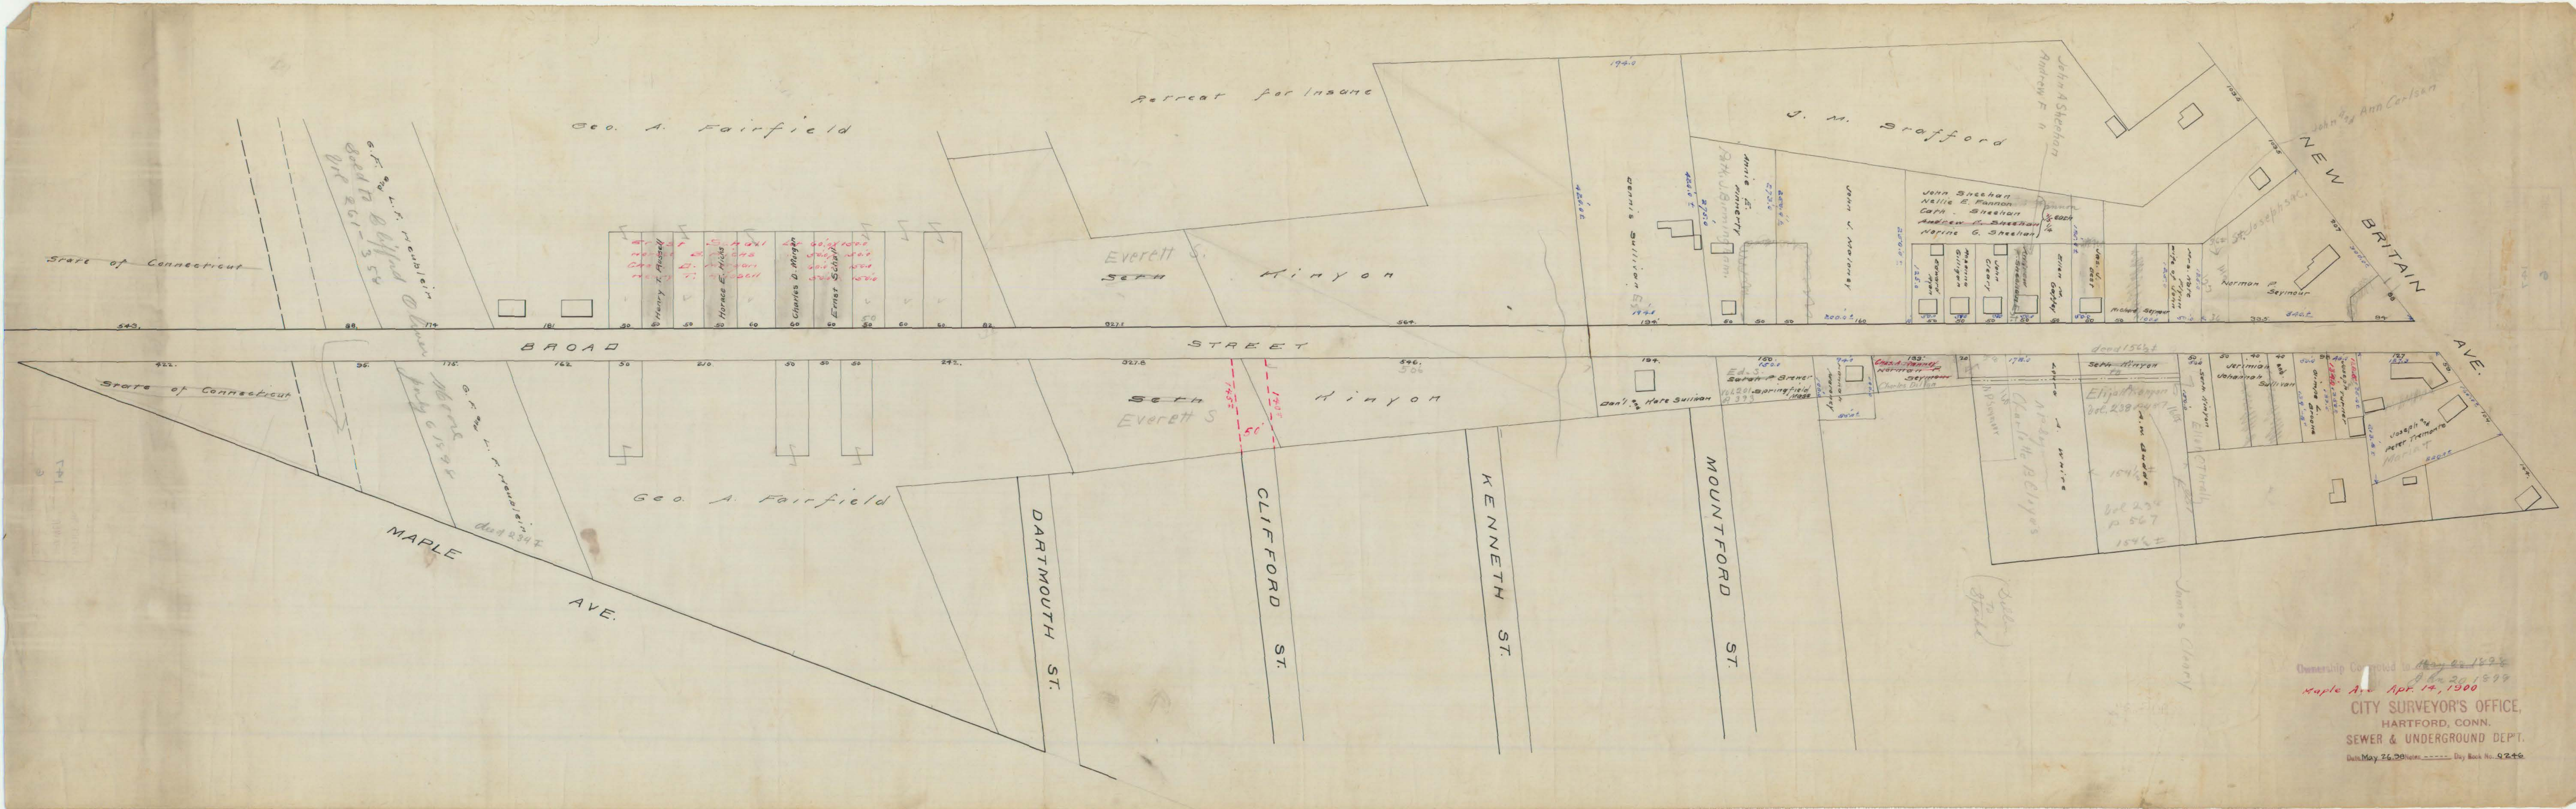

Ownership Controlled to May 20, 1898
Maple Ave. Apr. 14, 1900
CITY SURVEYOR'S OFFICE,
HARTFORD, CONN.
SEWER & UNDERGROUND DEPT.
Date May 26, 1900 Notes ----- Day Book No. 9246