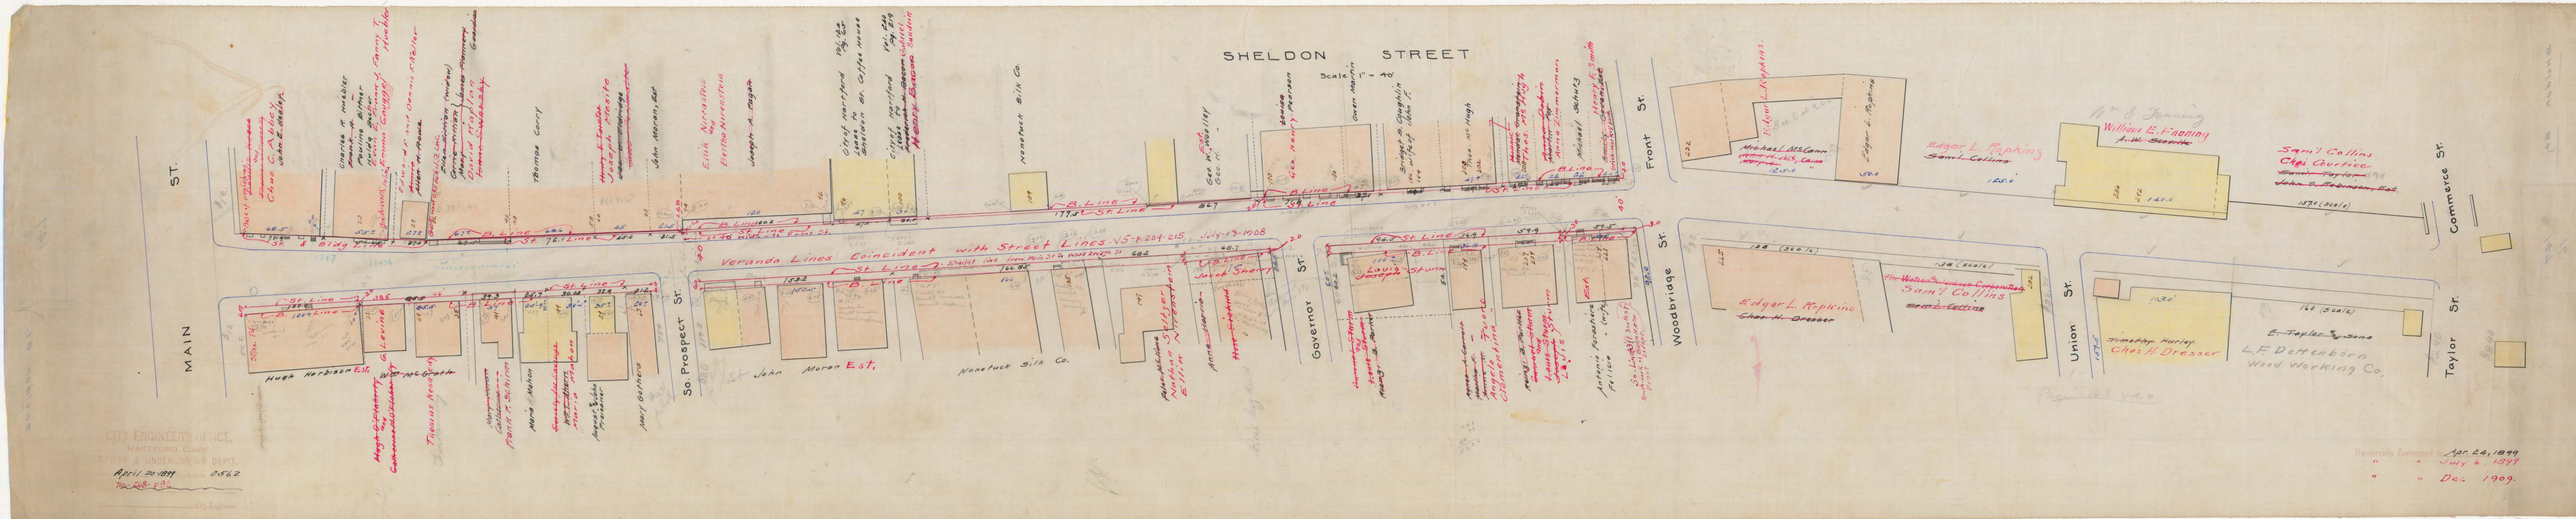
SHELDON STREET
Scale 1" = 40'
MAIN ST.
So. Prospect St.
Governor St.
Woodbridge St.
Front St.
Union St.
Commerce St.
Taylor St.
Veranda Lines Coincident with Street Lines
B. Line
St. Line
Hugh Harrison Est.
John Moran Est.
Nonotuck Silk Co.
Edgar L. Hopkins
Michael McCann
Sam'l Collins
William E. Fanning
Louis Joseph Shum
Jacob Sherry
Chas. H. Dresser
L.F. Dettenborn Wood Working Co.
CITY ENGINEER'S OFFICE
HARTFORD, CONN.
SEWER & UNDERGROUND DEPT.
April 20 1899
Apr. 24, 1899
July 6, 1897
Dec. 1909