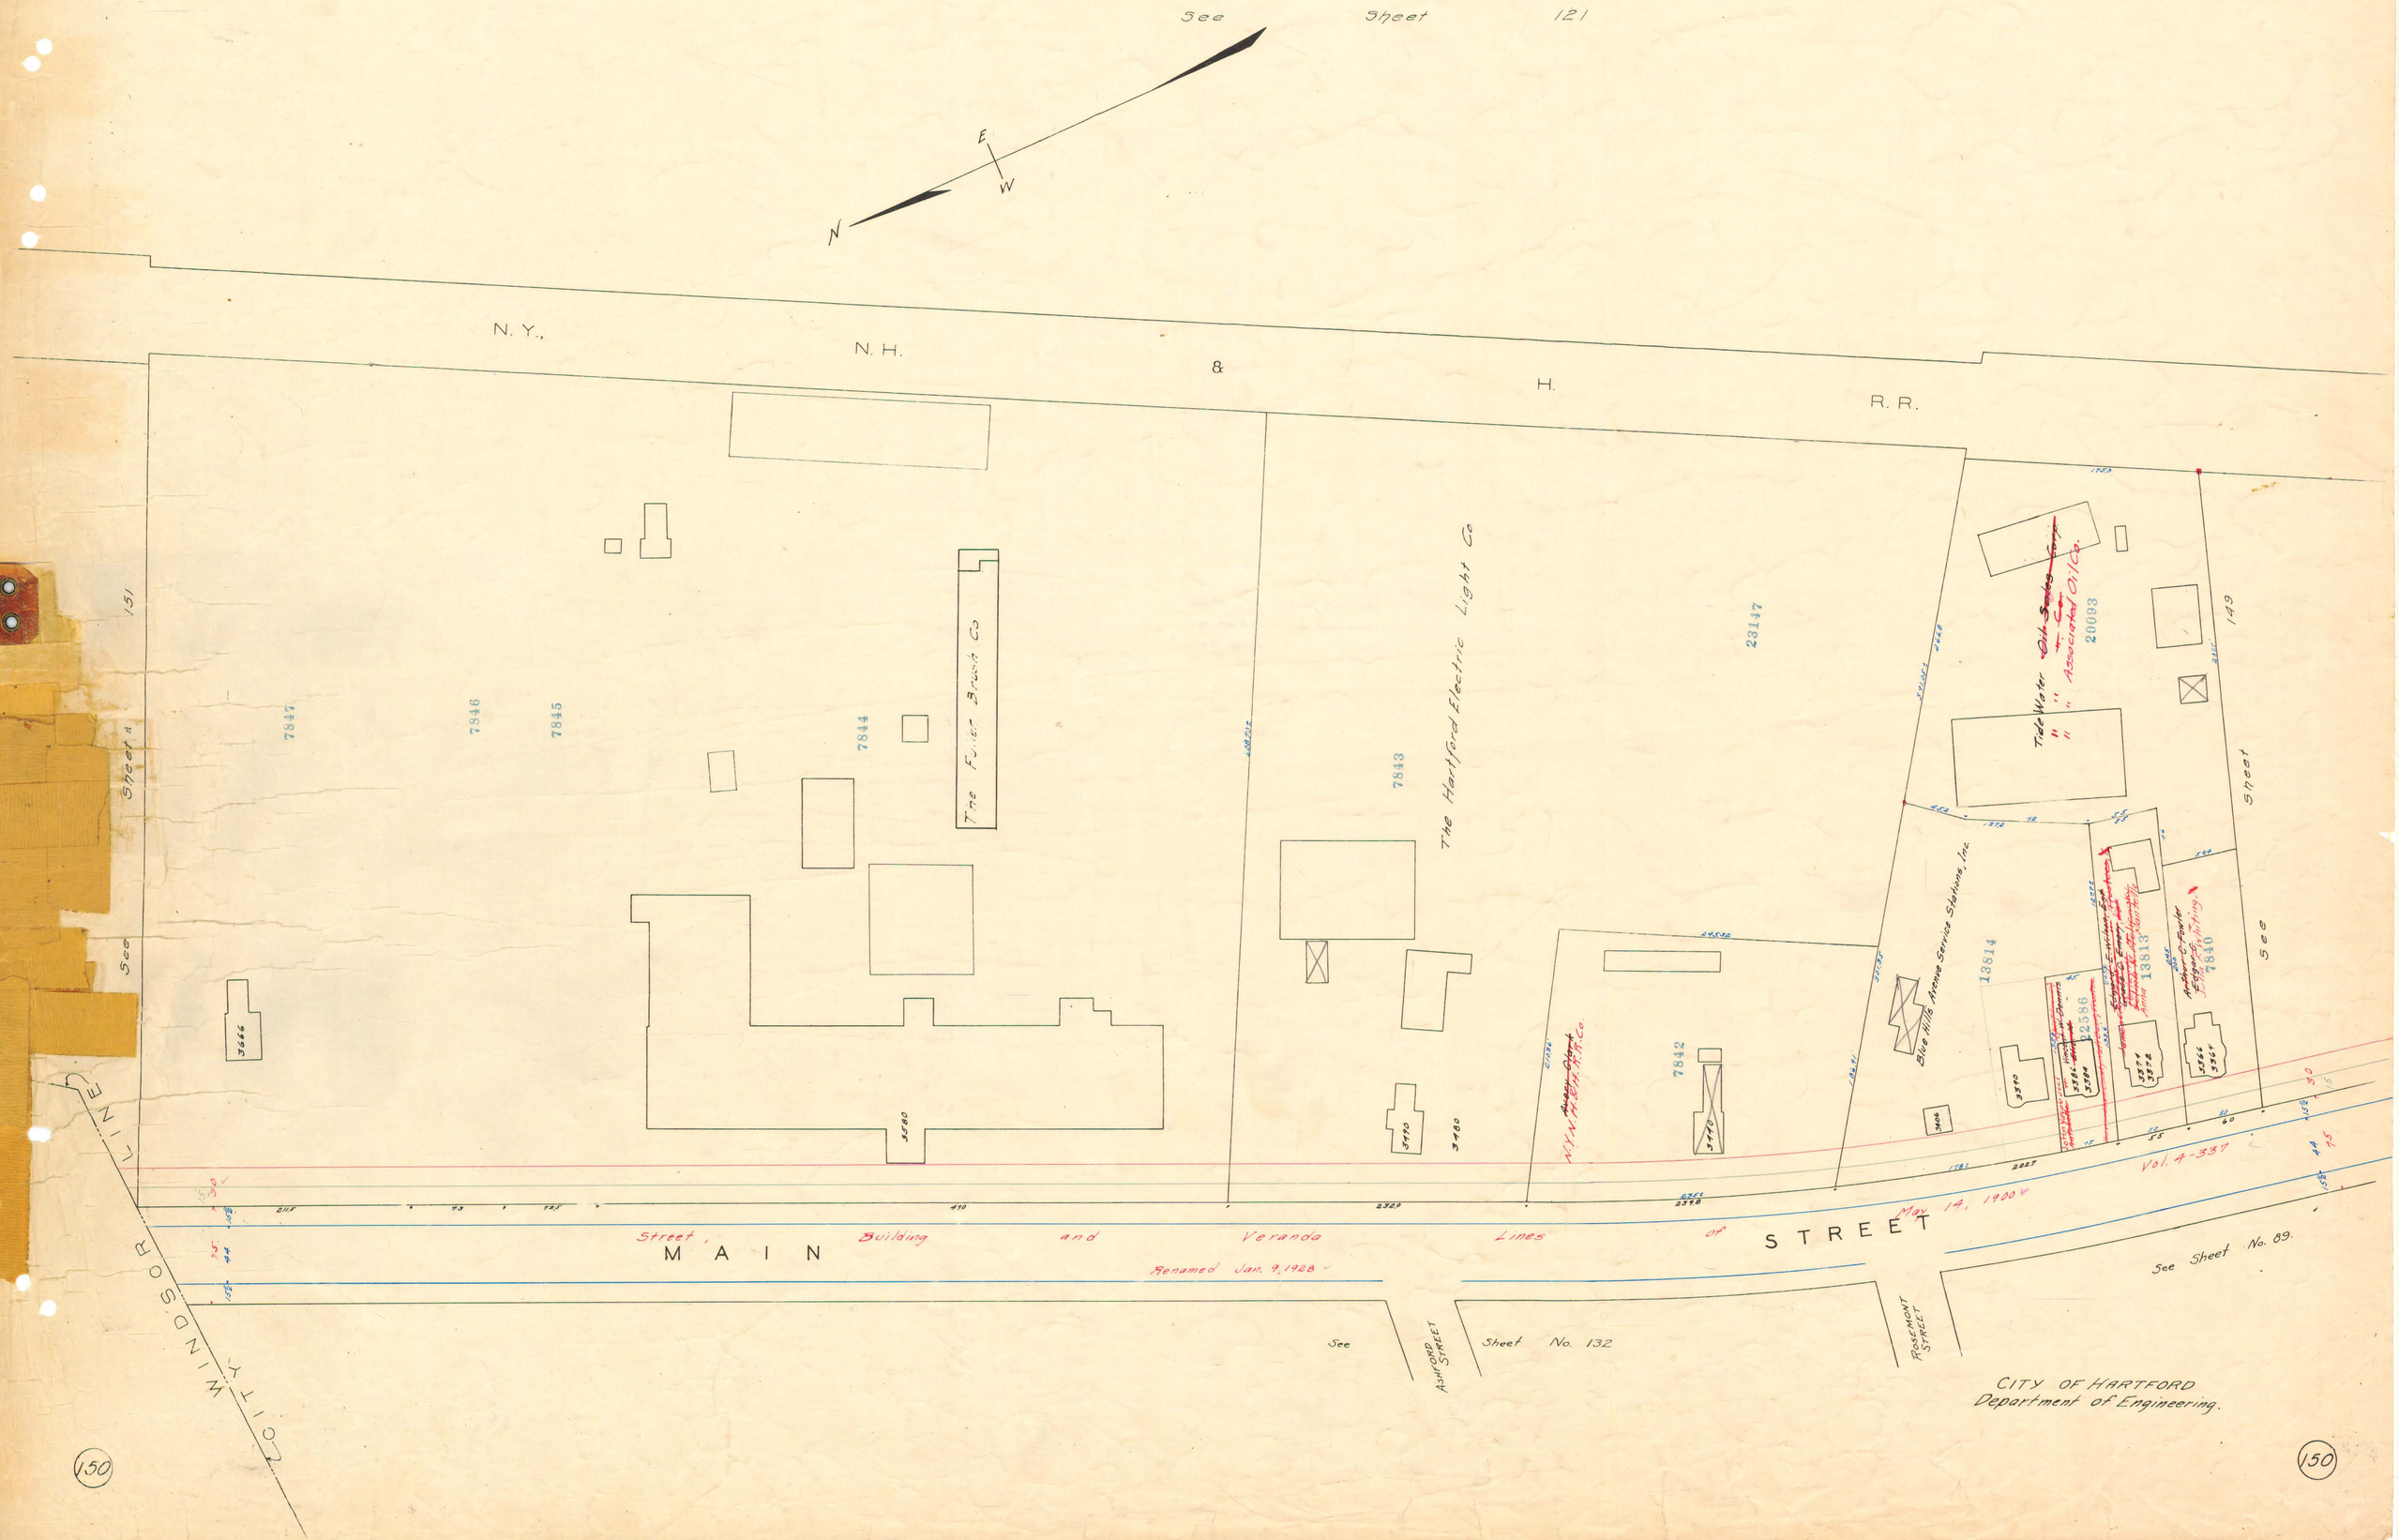
See Sheet 121
N
E
W
N. Y., N. H. & H. R. R.
151
Sheet 4
See
7847
7846
7845
7844
The Fuller Brush Co
7843
The Hartford Electric Light Co
23147
Tide Water Oil Sales Corp
" " Associated Oil Co.
20093
149
Sheet
See
13814
13813
12586
Andrew C. Fowler
Engineer, Hartford
7840
7842
3666
