


OUT Mar. 6, 1931

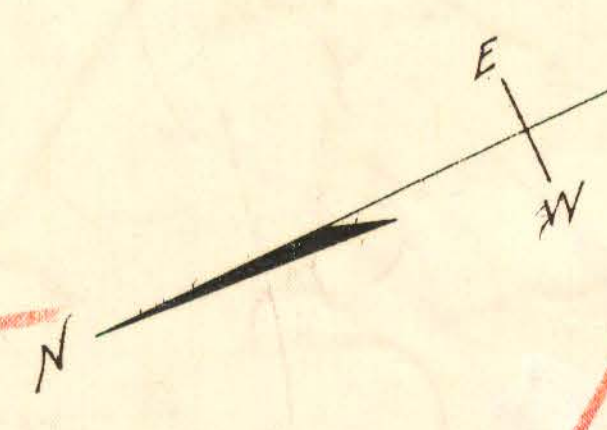

N. Y. N. H. & H. R. R.

OUT

Mar. 6, 1931

OUT

Richard Mather

Dwight Porter
Fuller Brush Co

Richard Mather
The Fuller Brush Co

The Hartford Electric Light Co

Nellie W. Fittin

Phery Clark

Franklin P. Burr
Shelton & Sons

Fitch Water Co. of N.H.
The Water Oil Sales Corp.

Arthur C. Fowler
Arthur C. Fowler

MAIN WINDSOR

Veranda and Lines
Renamed January 9, 1928.

May 14, 1900
AVENUE

Vol. 42-337
STREET

ROSDEN Y LION