

Out March 8-1933

See Sheet 121


N. Y.

N. H.

&

H.

R. R.

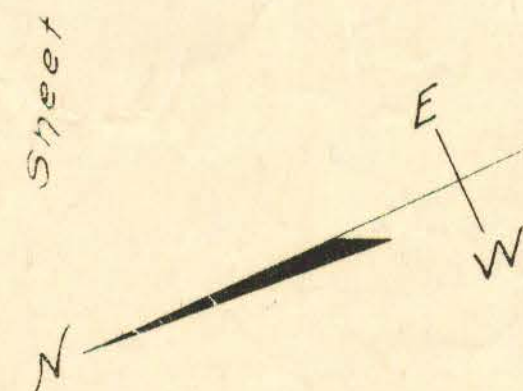


See Sheet 121

CITY

WINDSOR

LINE

Out of Service

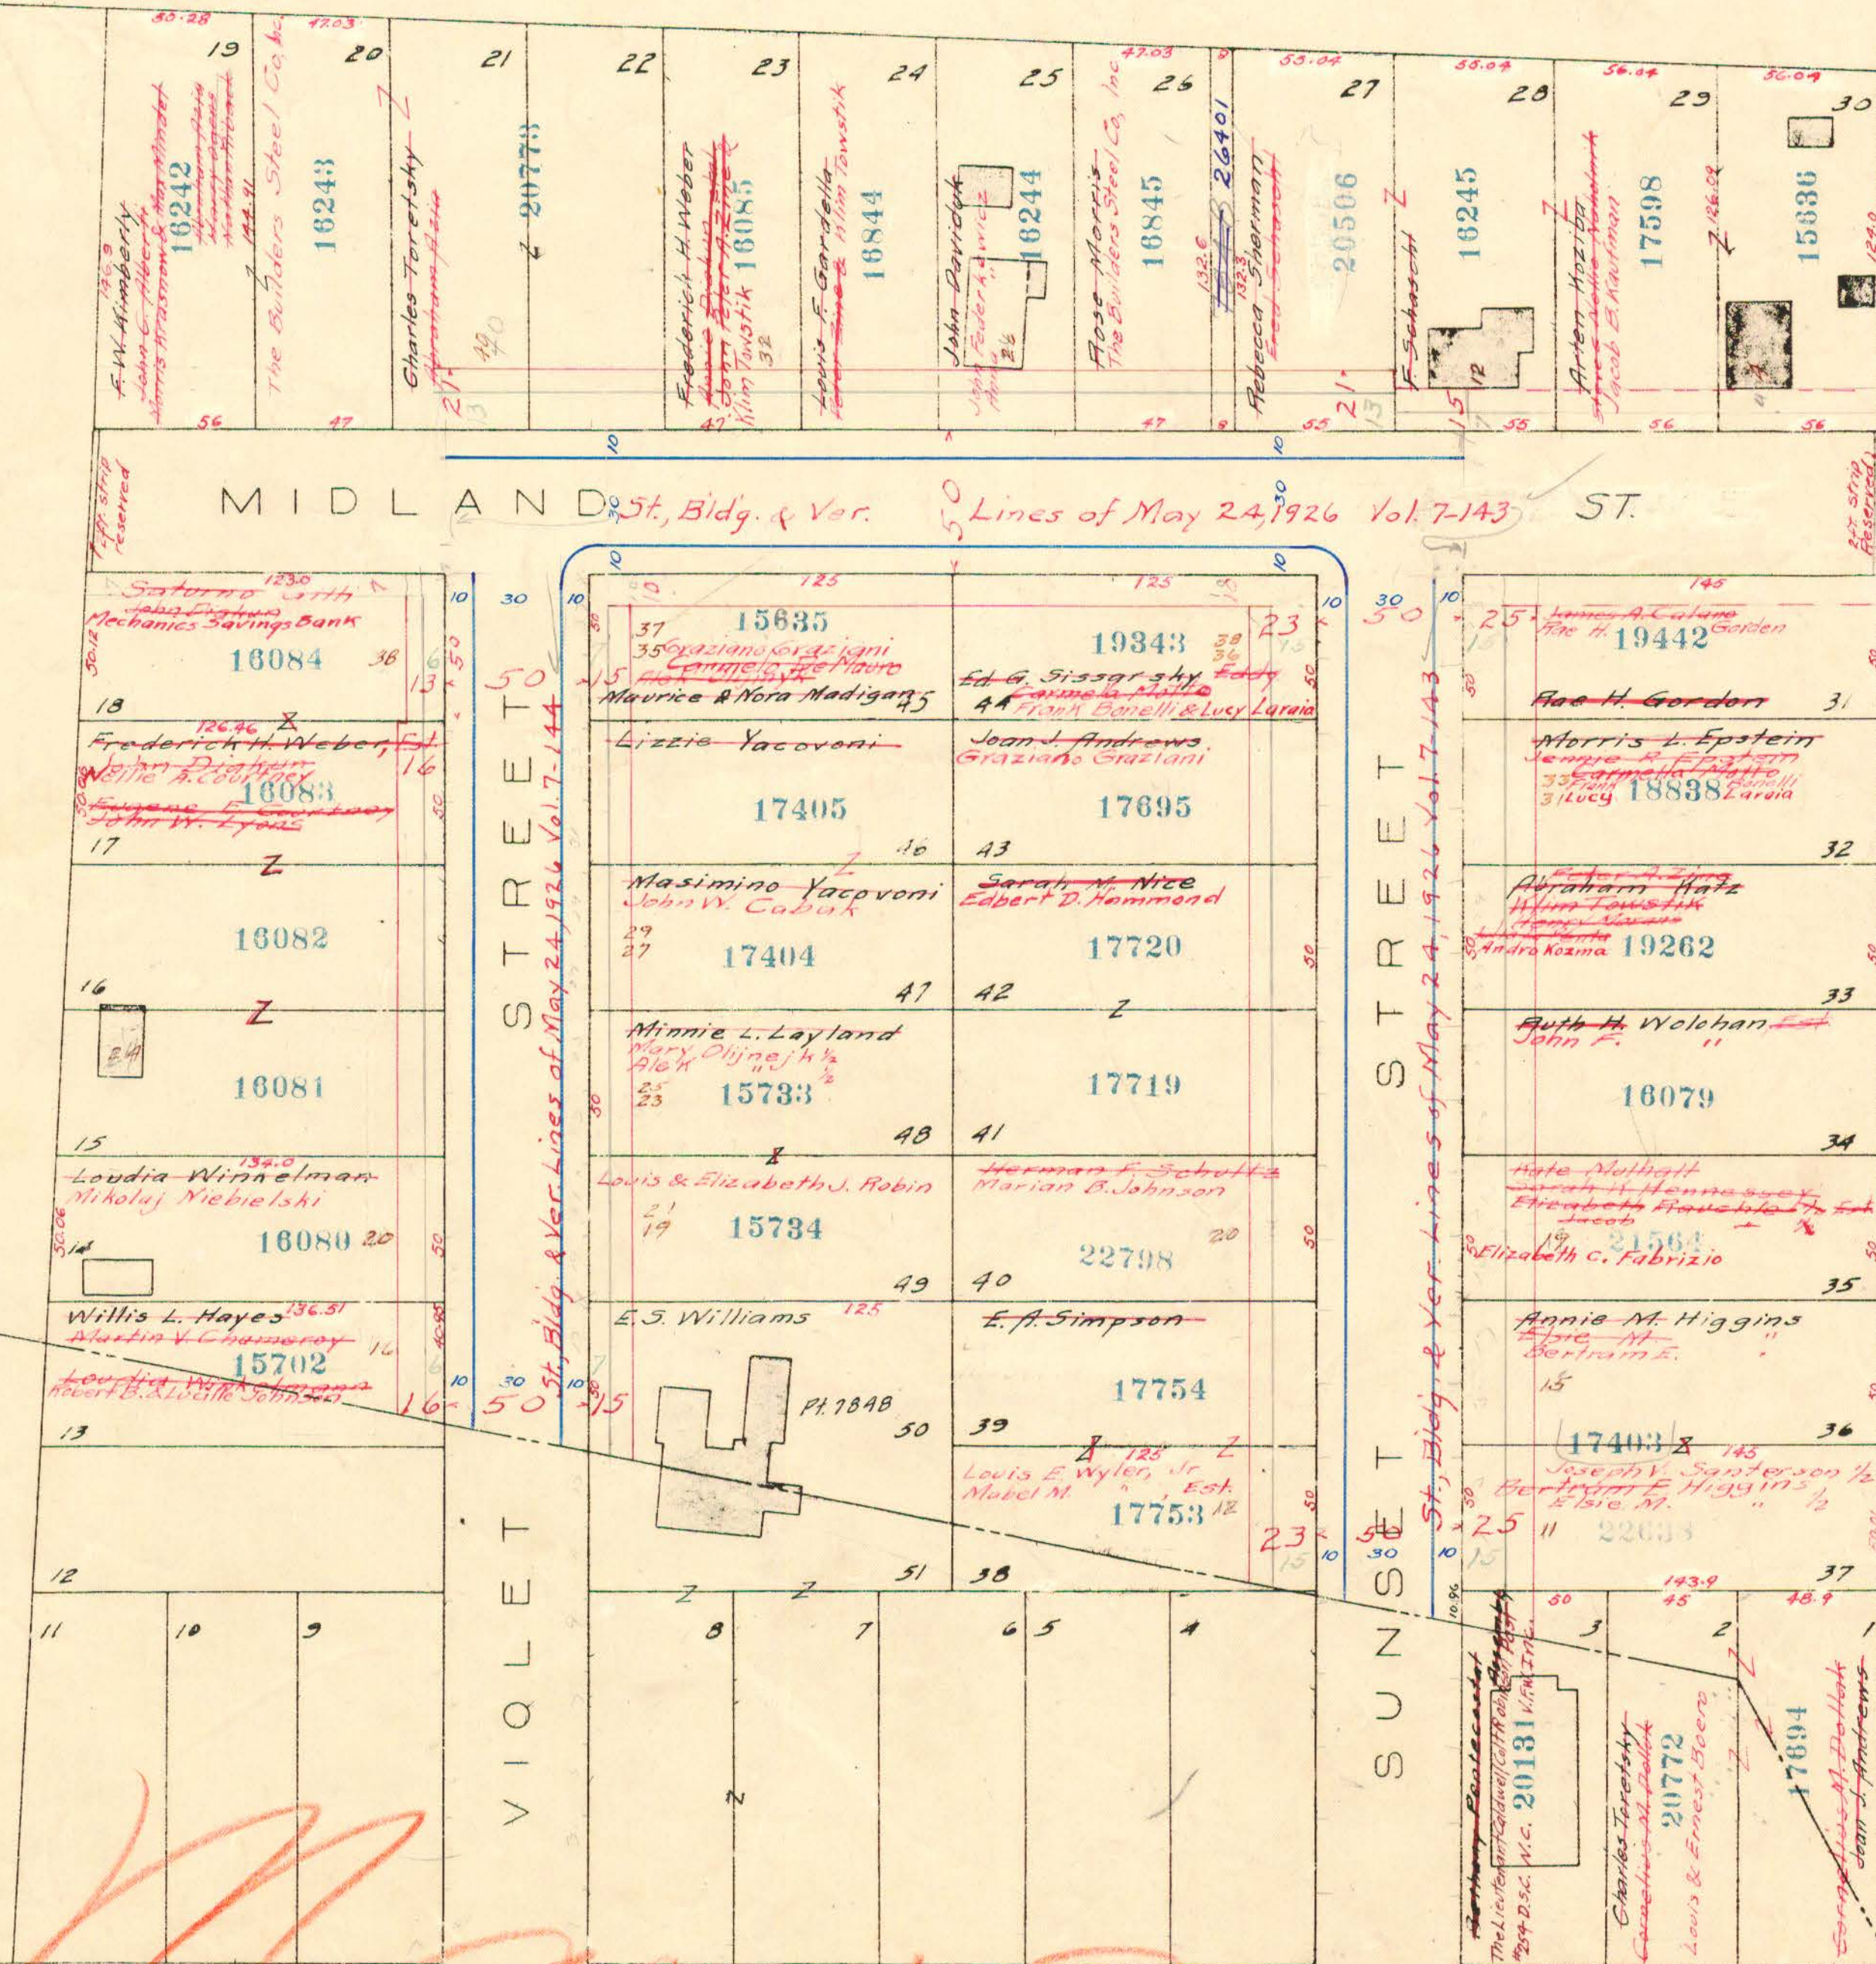

All lots not otherwise marked are Elva A. Simpson & Geo. L. Dinnell.
Mark all new cards formerly in 1893

150

Sheet

See

March 8-1935

Out of service, March 8-1935.