


CITY OF HARTFORD
Department of Engineering

WEST

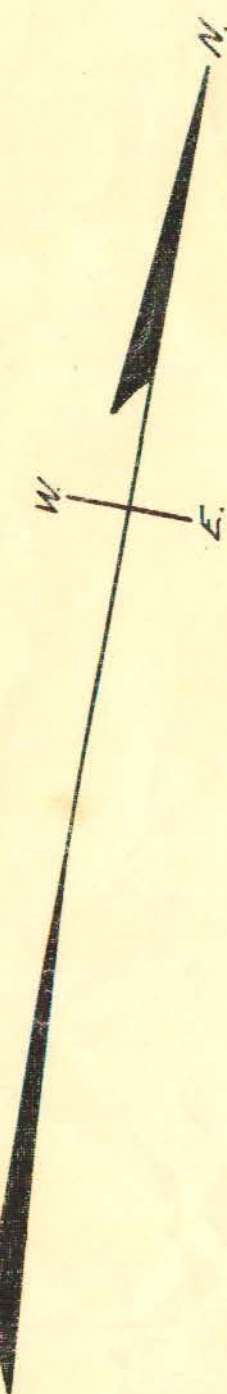

EASTVIEW
STREET

WHITE
STREET

CHAPMAN
STREET

MAPLE
STREET

BROWN
STREET

DALTON
ST.


BRUNS-
WICK
ST.

CASCO
ST.

BECKET
ST.

CAMPFIELD
STREET

AVENUE

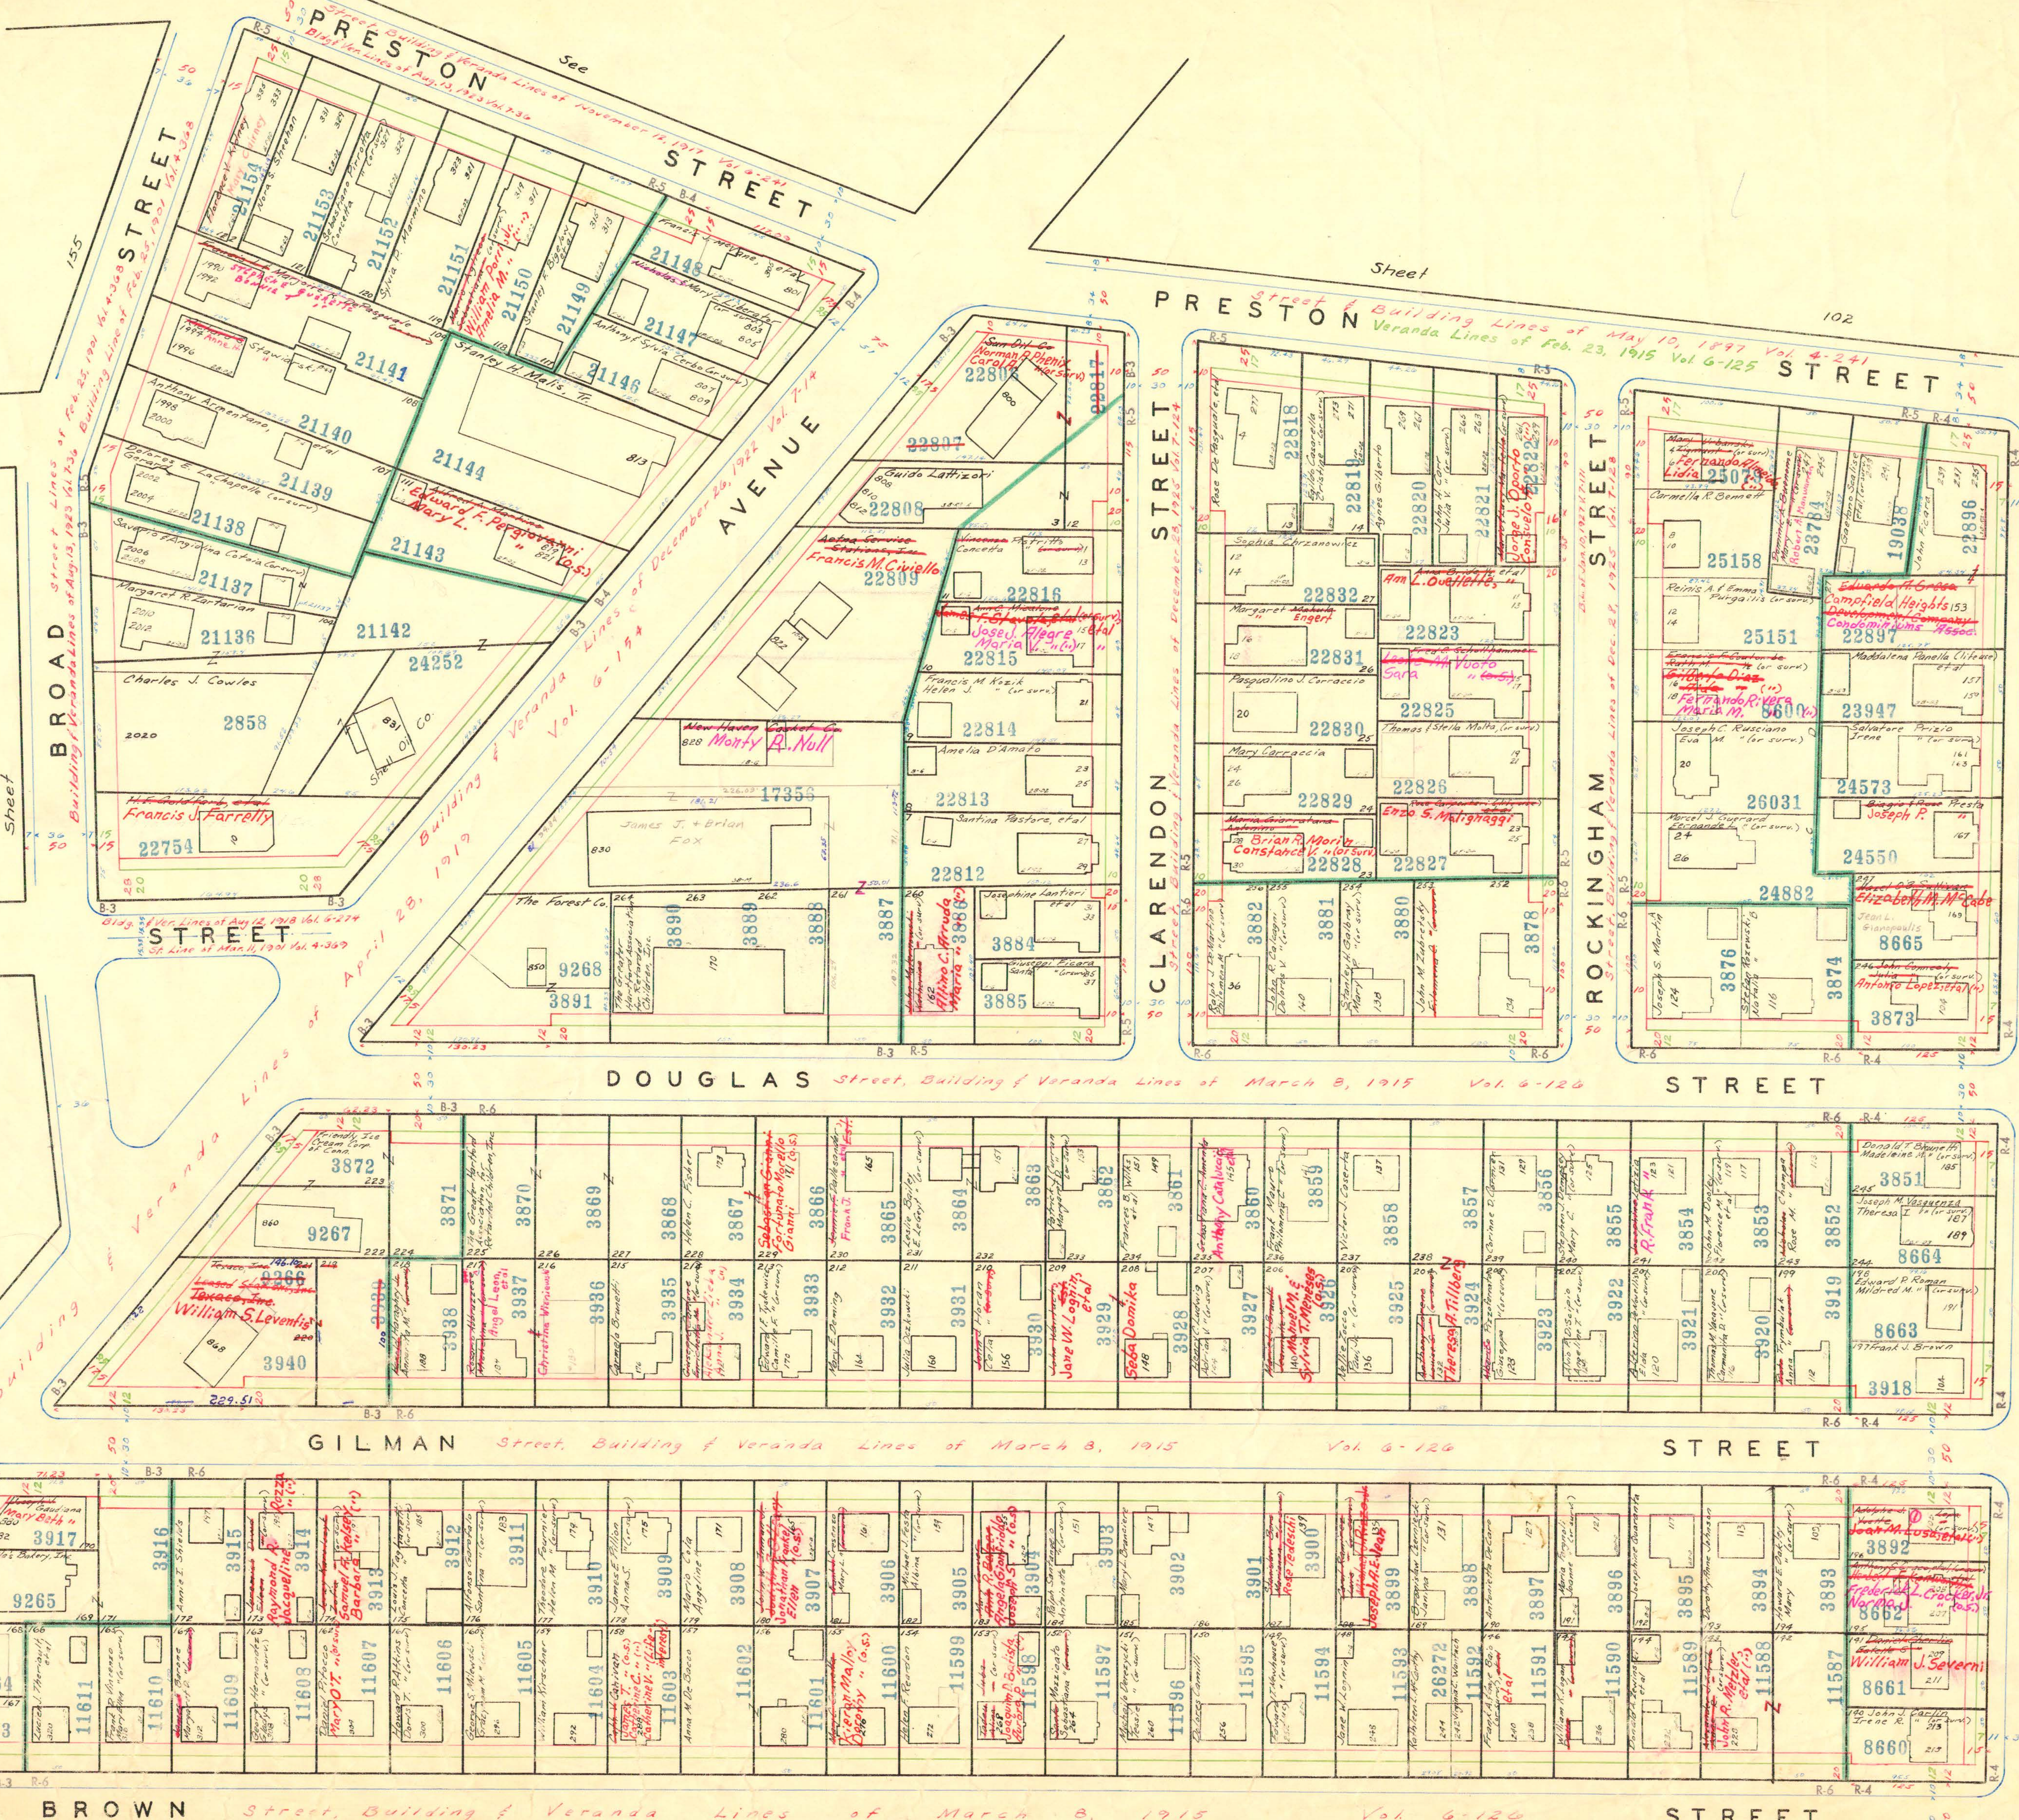

LINNMOORE
ST.

152

152

(D. 516 & 3892
Theodore R. Michels Jr.
Barbara A. Michels
(Joint Tenants))