


CITY OF HARTFORD
Department of Engineering

Cut-ups:
"Additions and Revisions of Fairfield Park" 258/26
West Preston St., Broad St., & Maple Ave.
"Maplewood Park" (Revised Plan) 244/14
Maple Ave., Preston St., & Clarendon St.
"Parkway Heights" 194/1, Maple Ave., Douglas St.,
Gilman St., Brown St., & Campfield Ave.

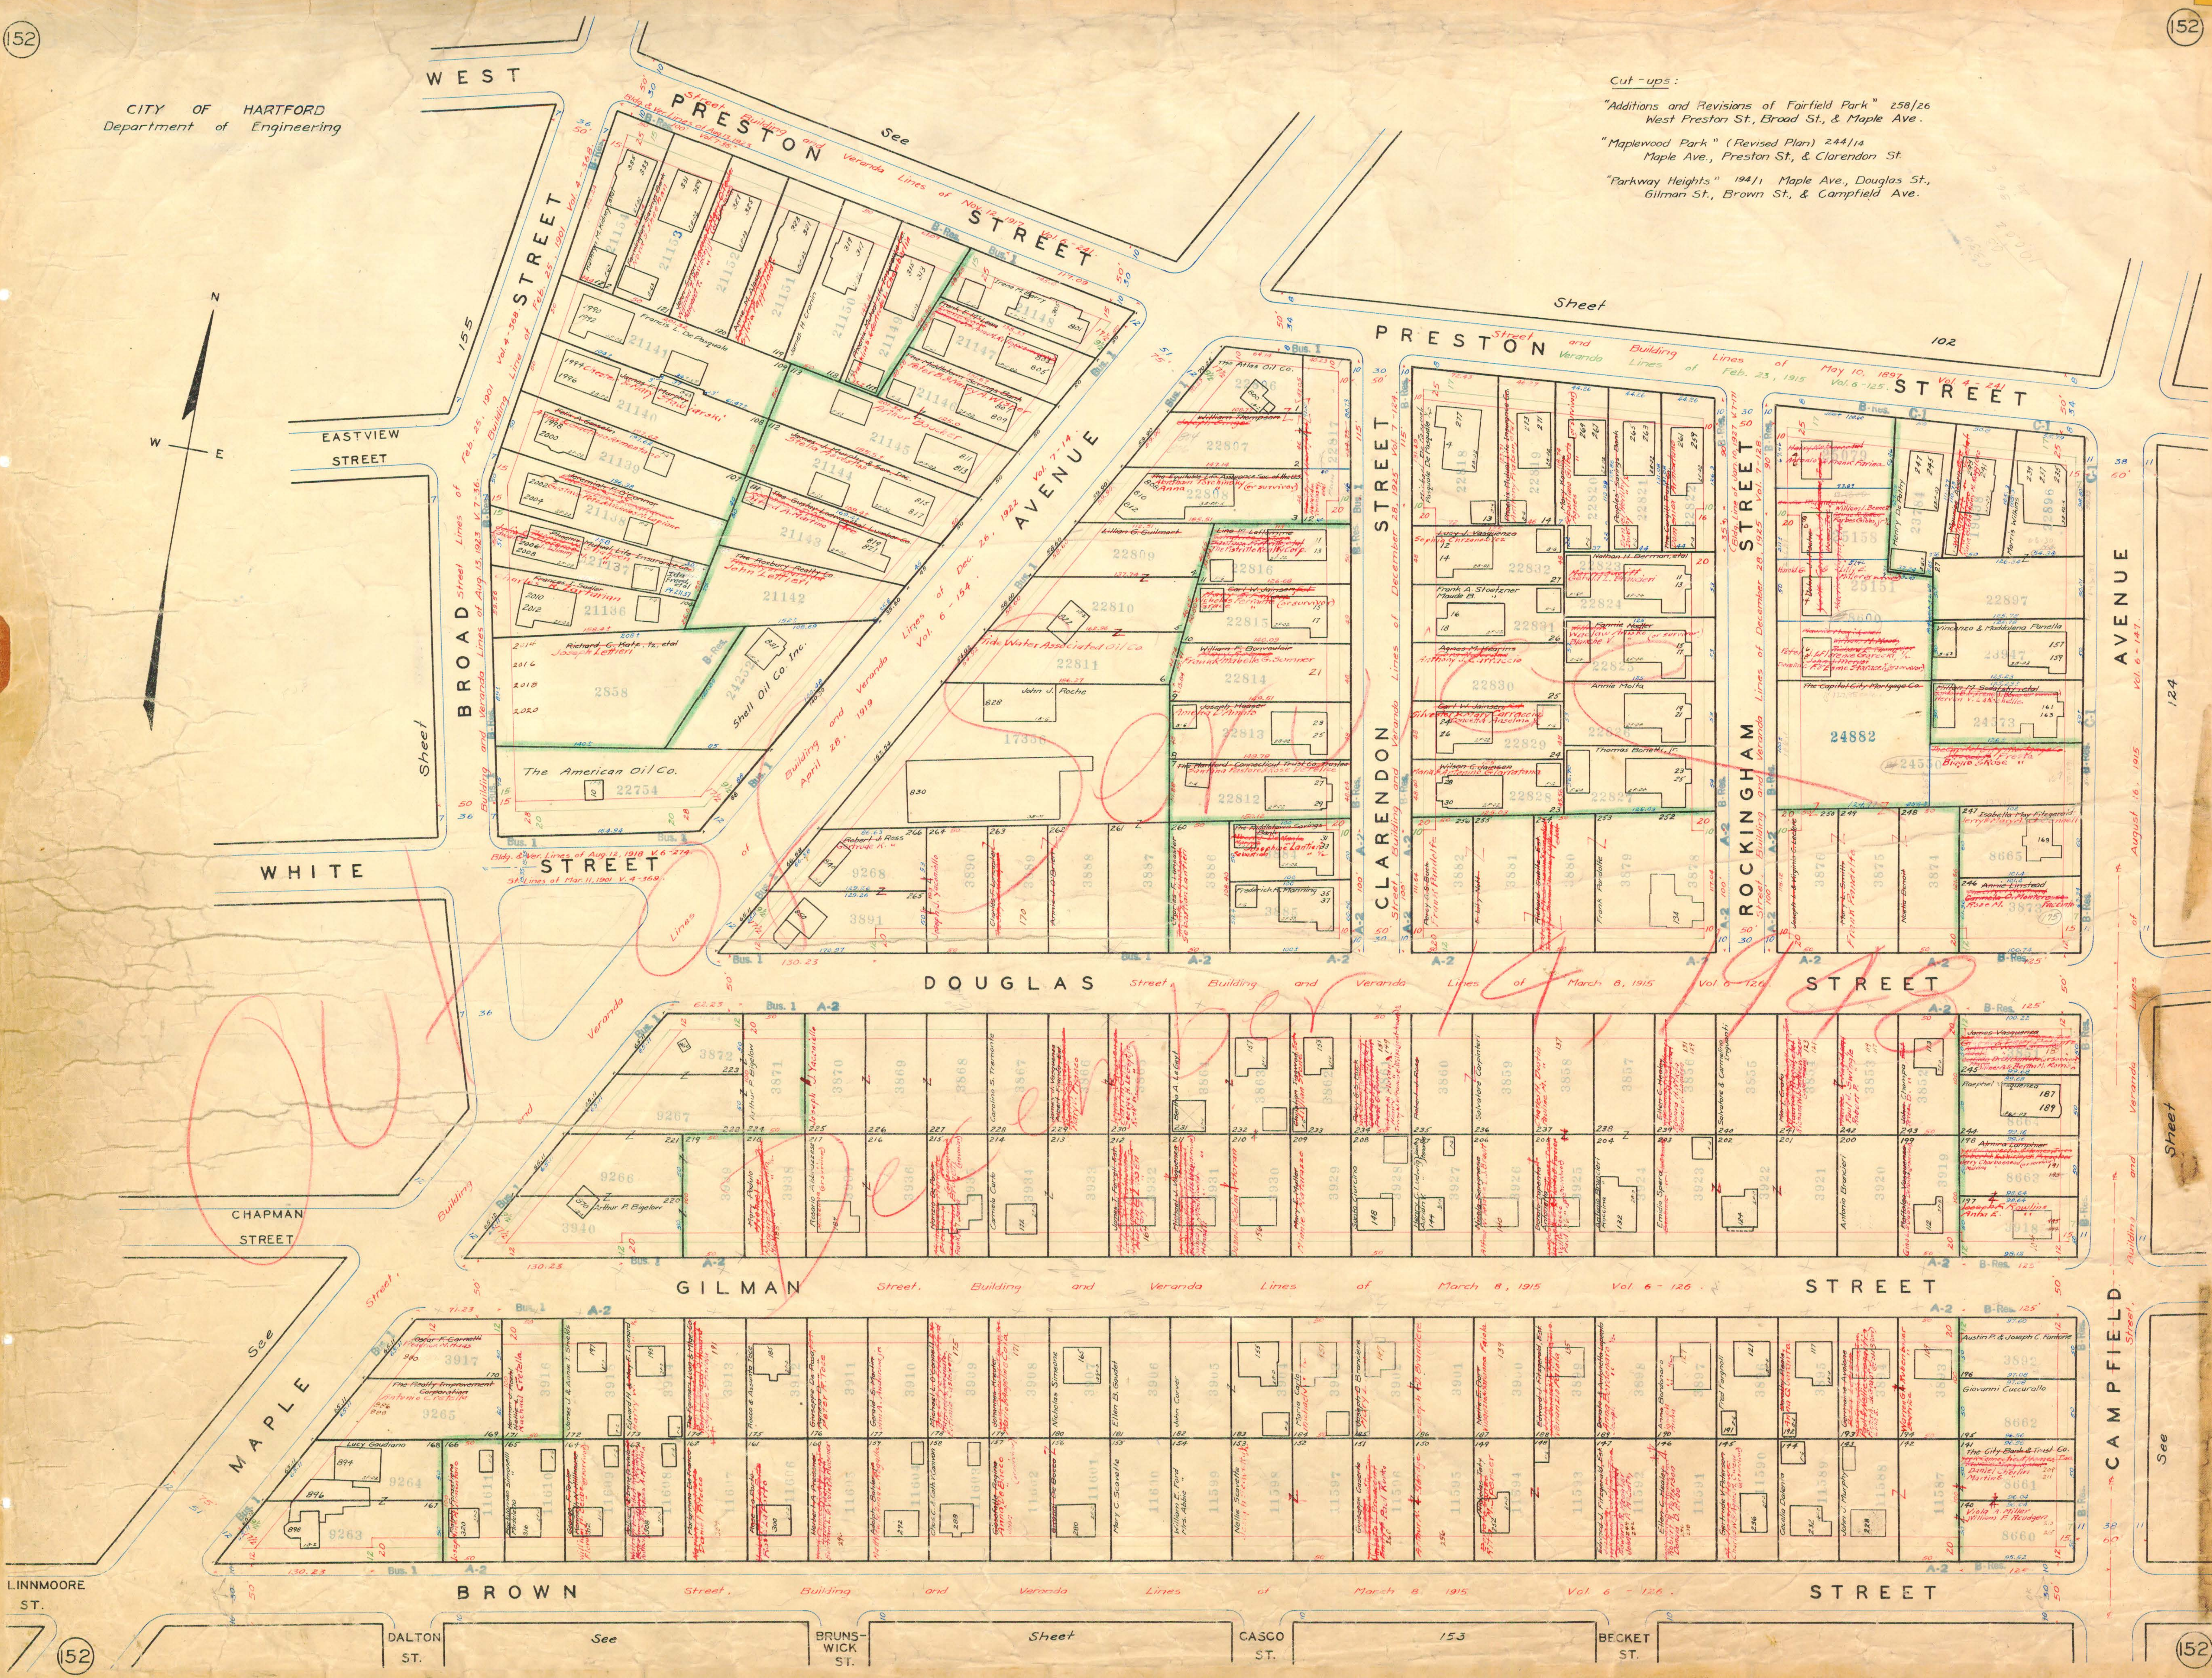

LINNMOORE ST.

DALTON ST.

BRUNSWICK ST.

CASCO ST.

BECKET ST.