


CITY OF HARTFORD
Department of Engineering
Cut-ups: Additions & Revisions of Fairfield Park 259/56.
West Preston St., Broad St. & Maple Ave.
"Maplewood Park" (Revised Plan) 244/1a, Maple Ave.,
Preston St. & Clarendon St.
"Parkway Heights" 129/1, Maple Ave., Douglas St.,
Gilman St., Brown St. & Campfield Ave.

Out of Service, April 26-1940

Out of Service

April 26-1940

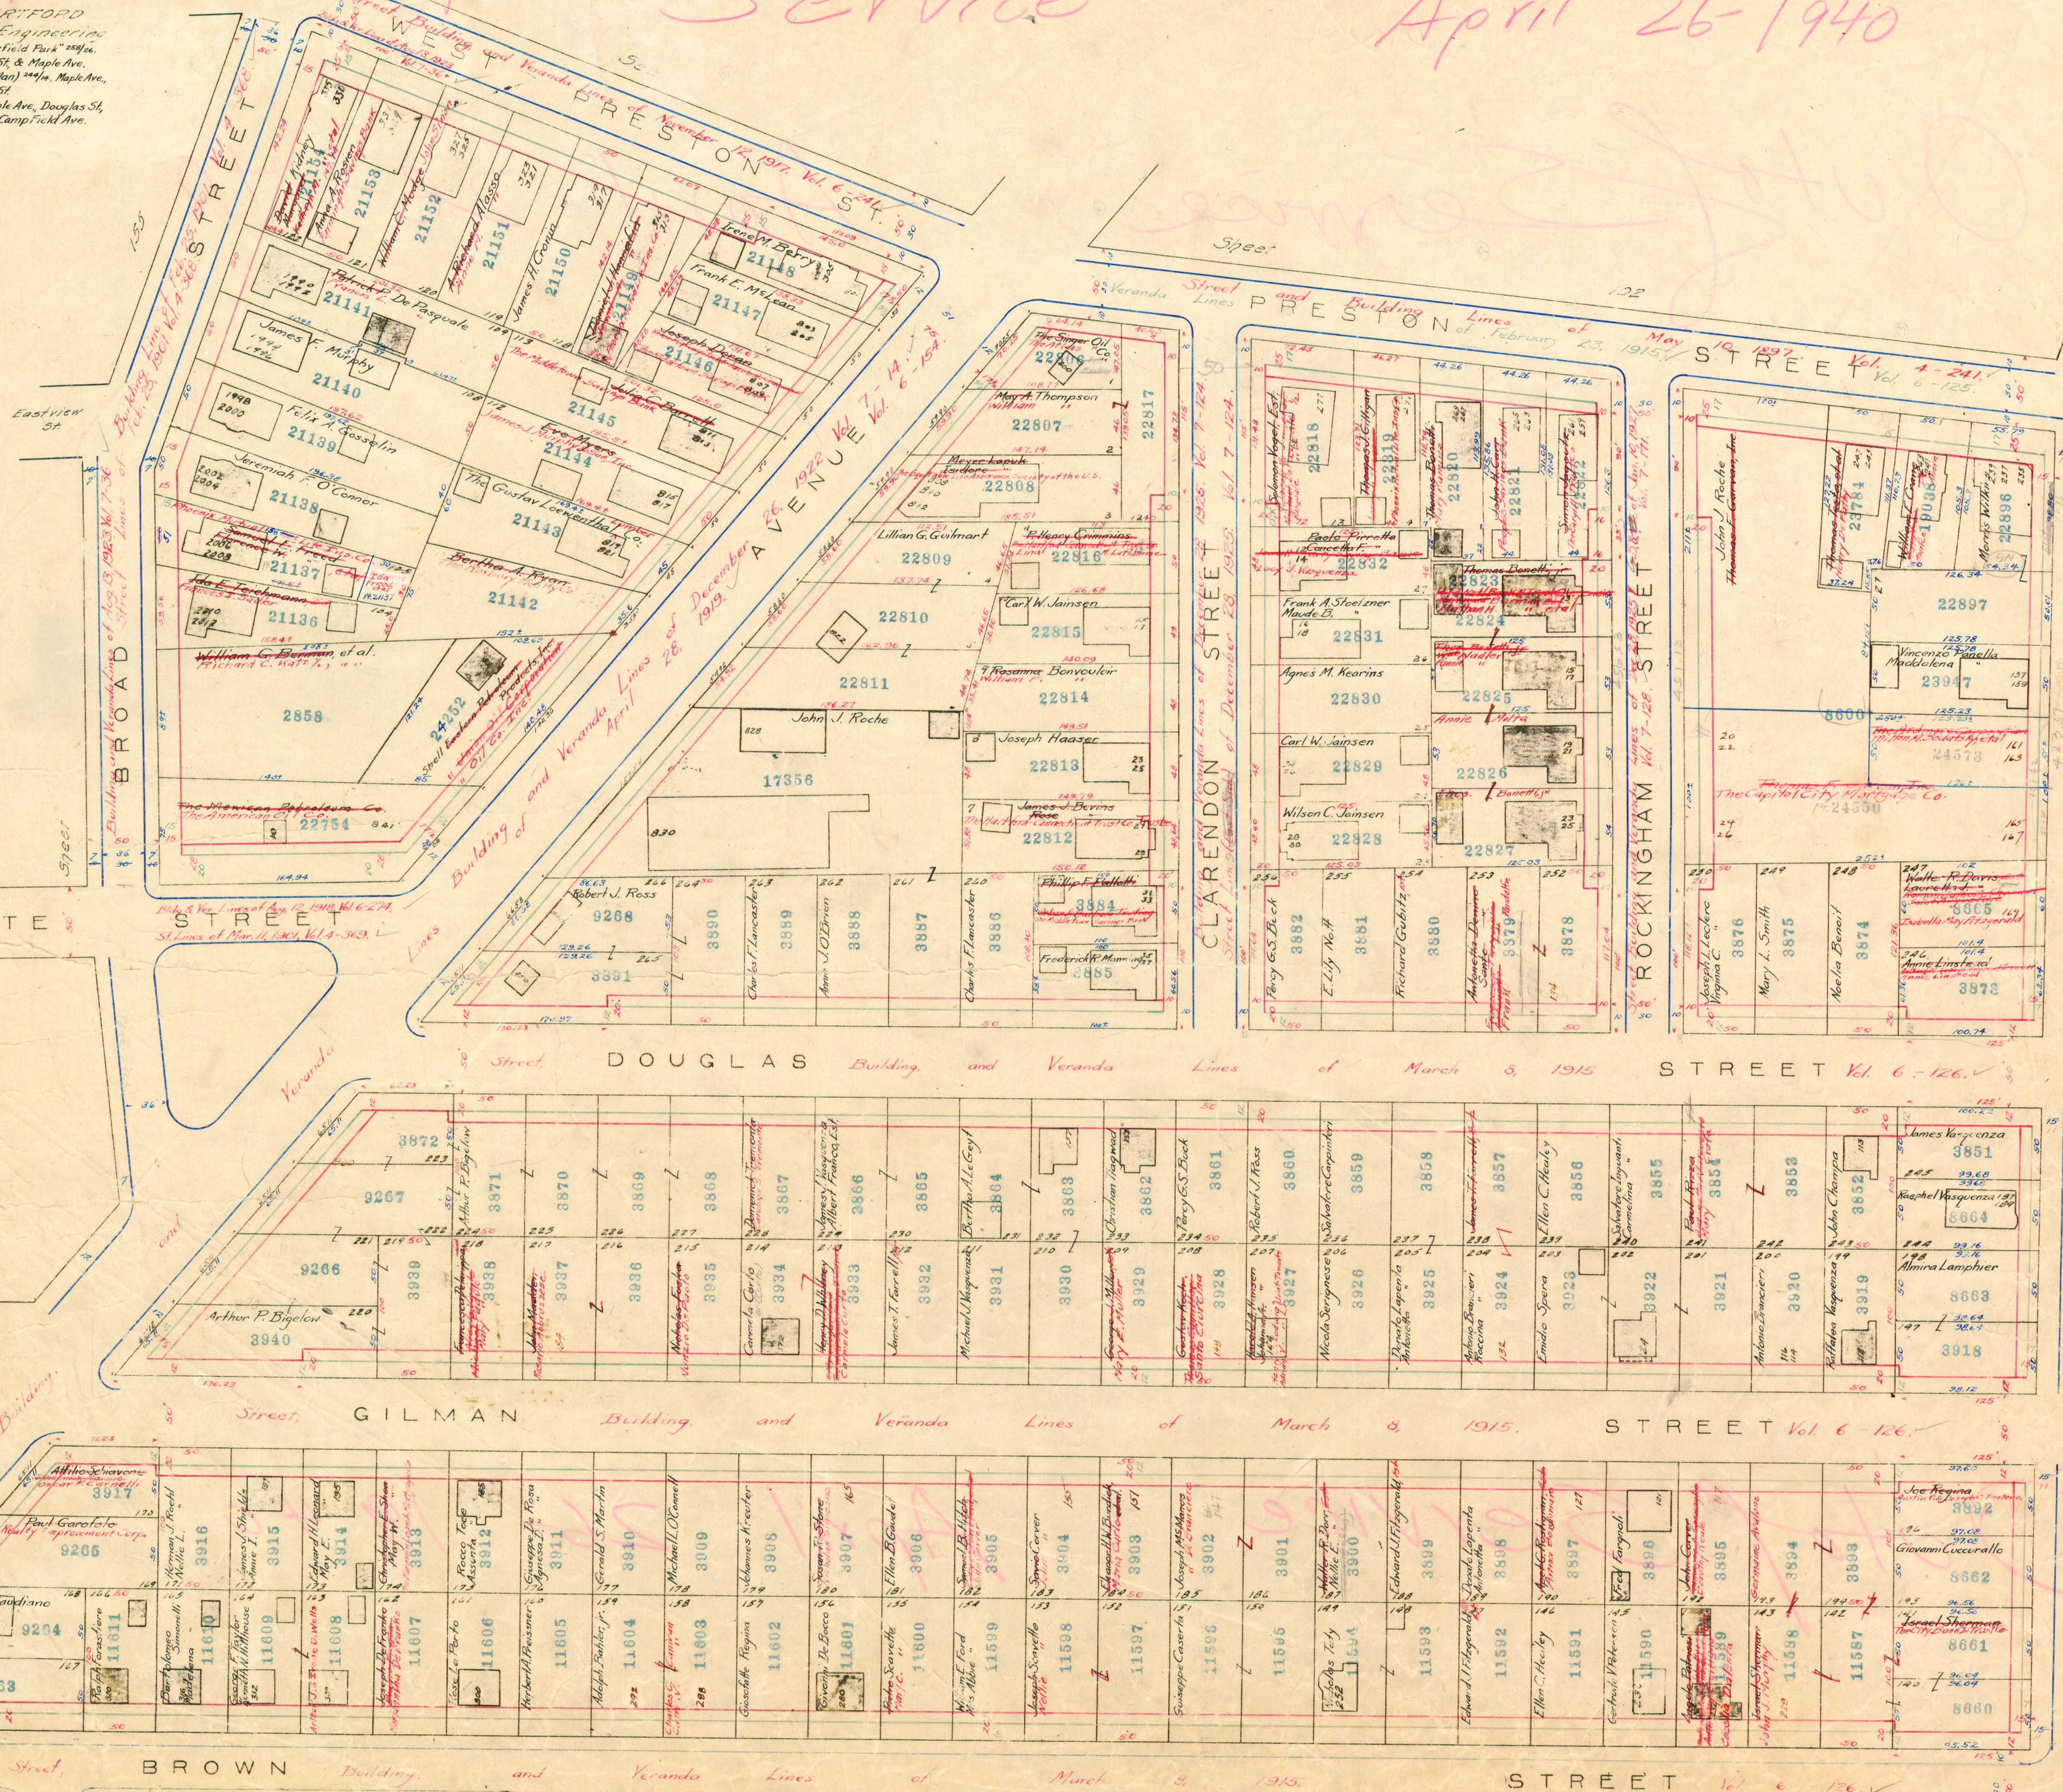

Out of Service, April 26-1940

Out of Service

April 26-1940

Out of Service