
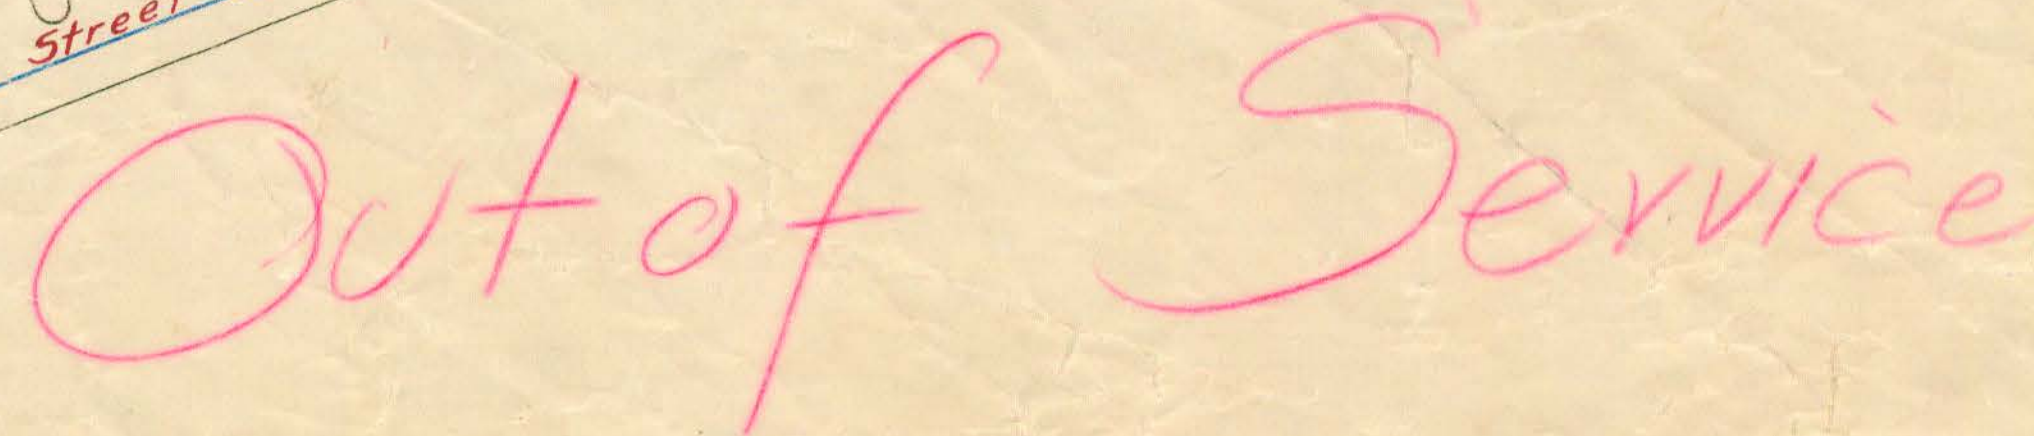


April 18-1938

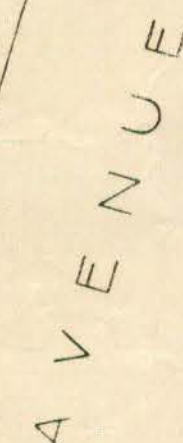

April 18-1938

Out of service, April 18-1938