


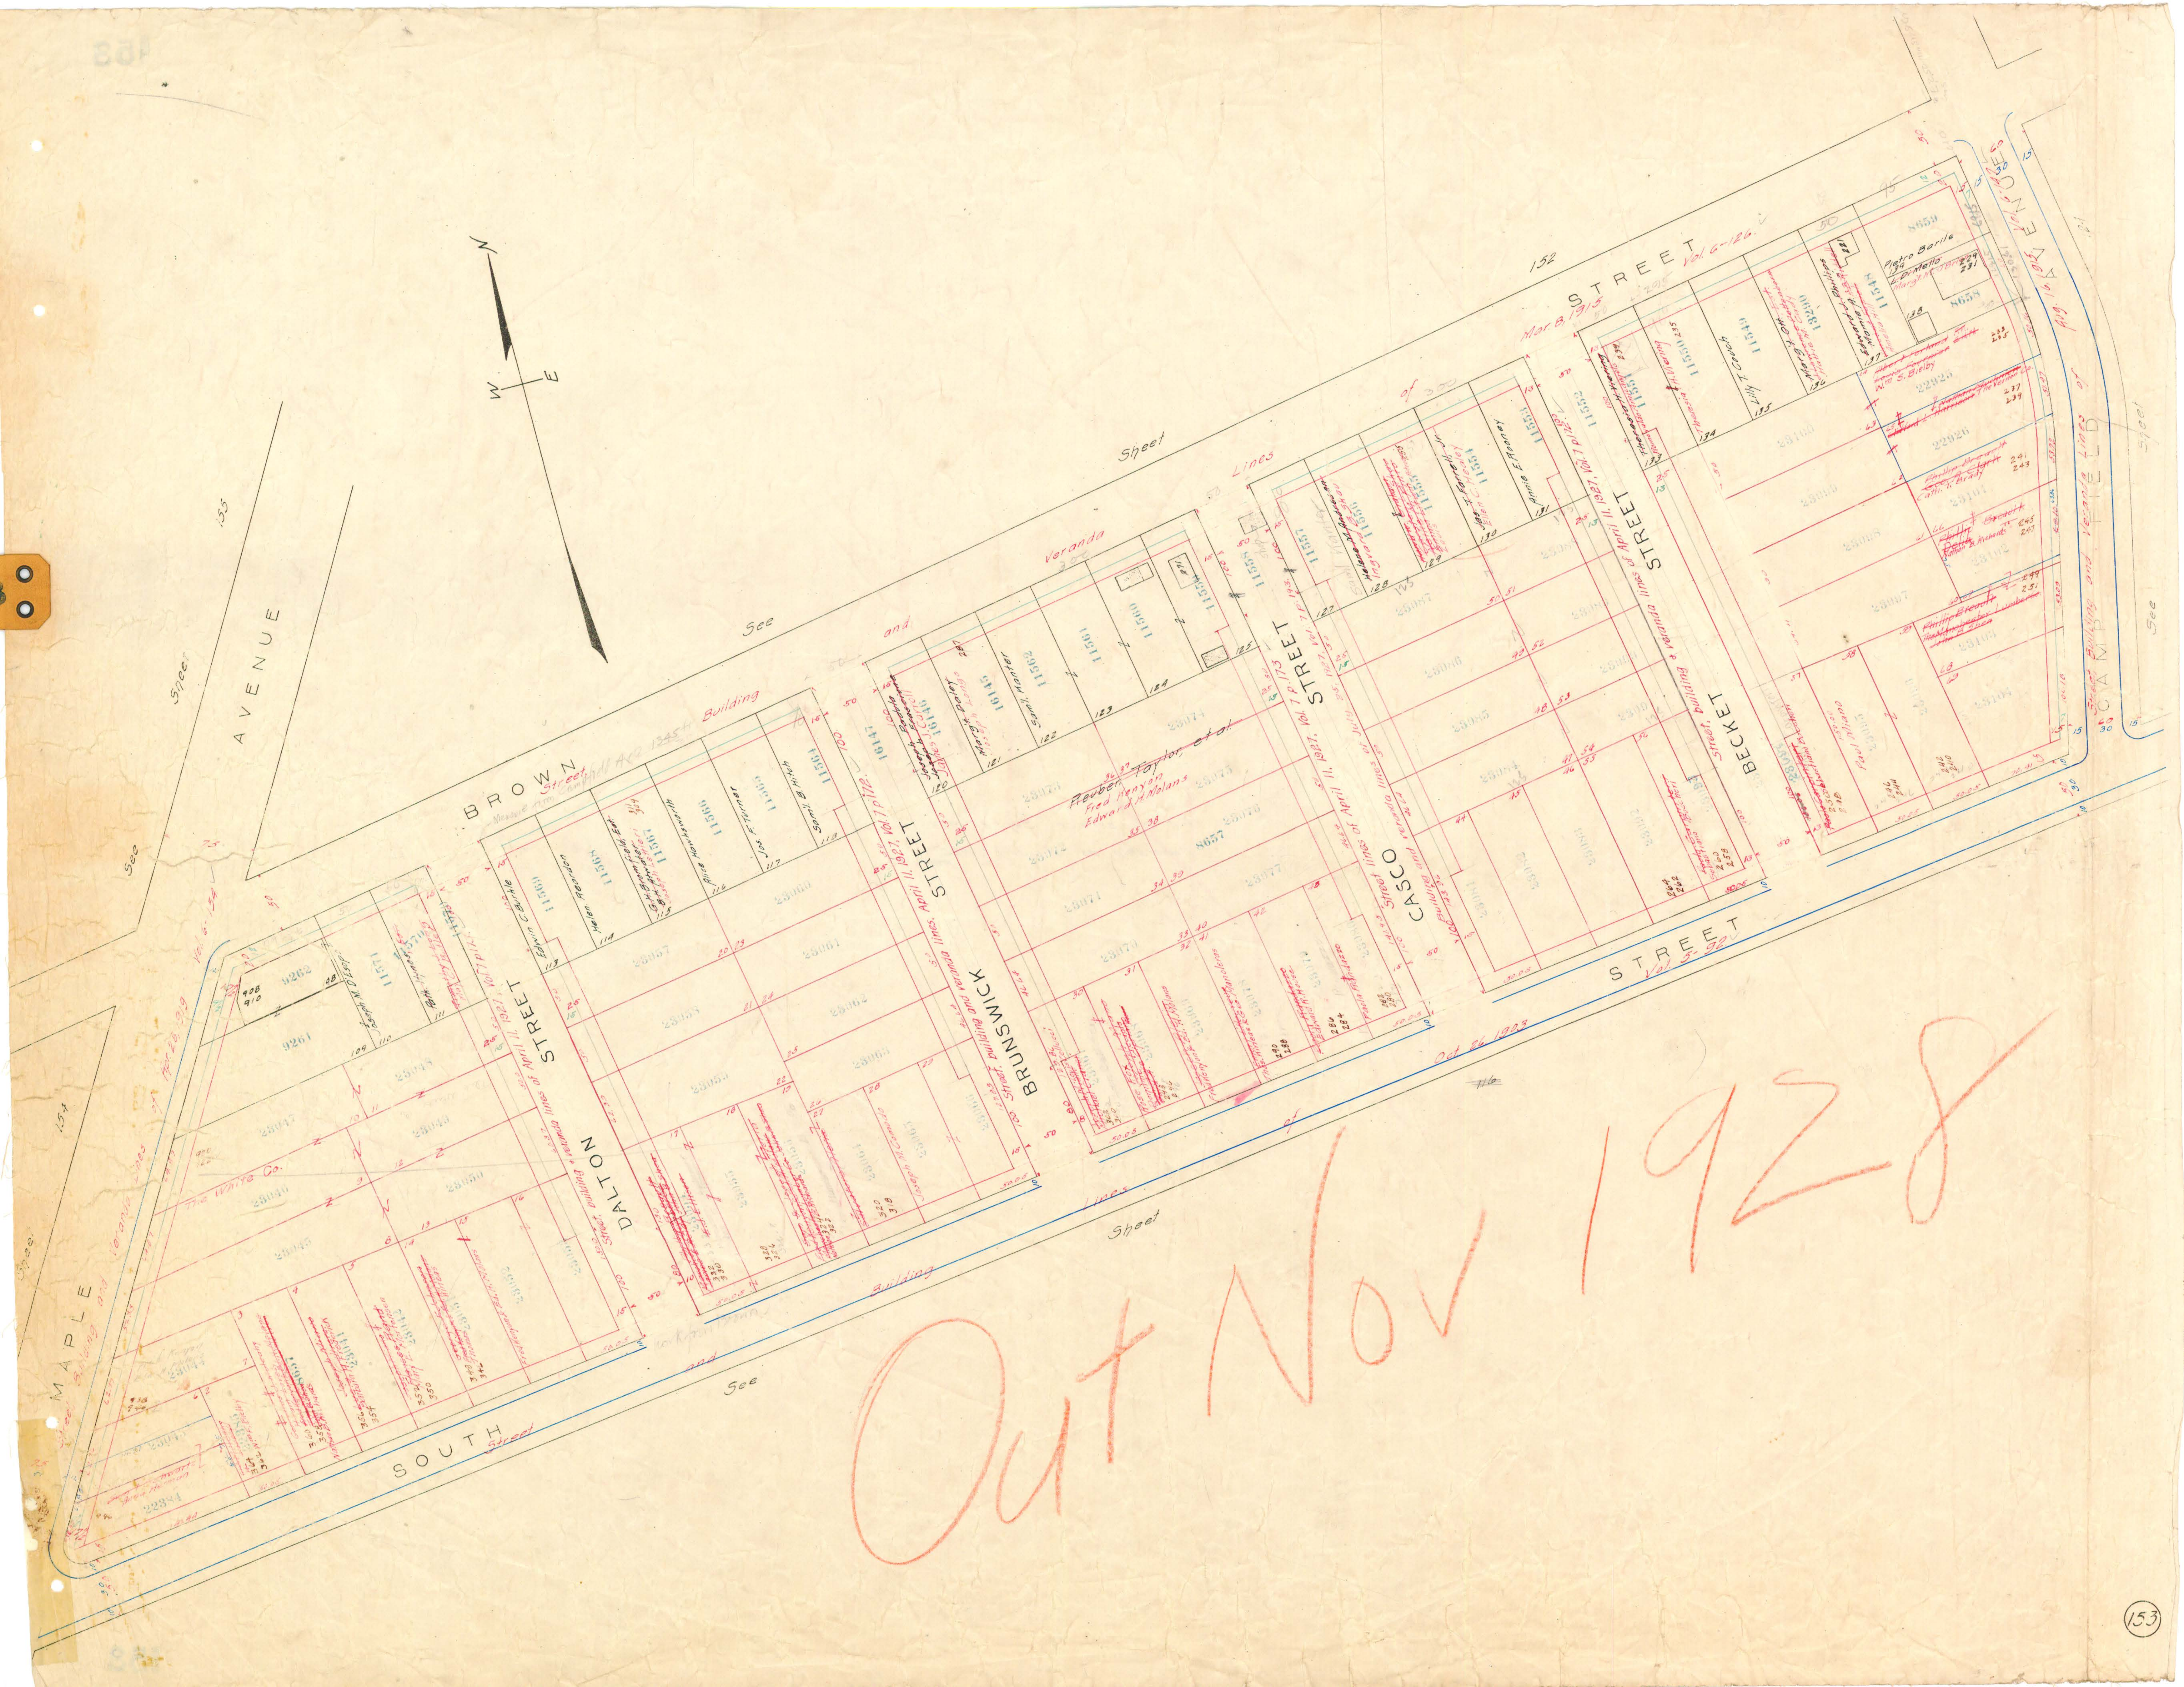

Out Nov 1928